
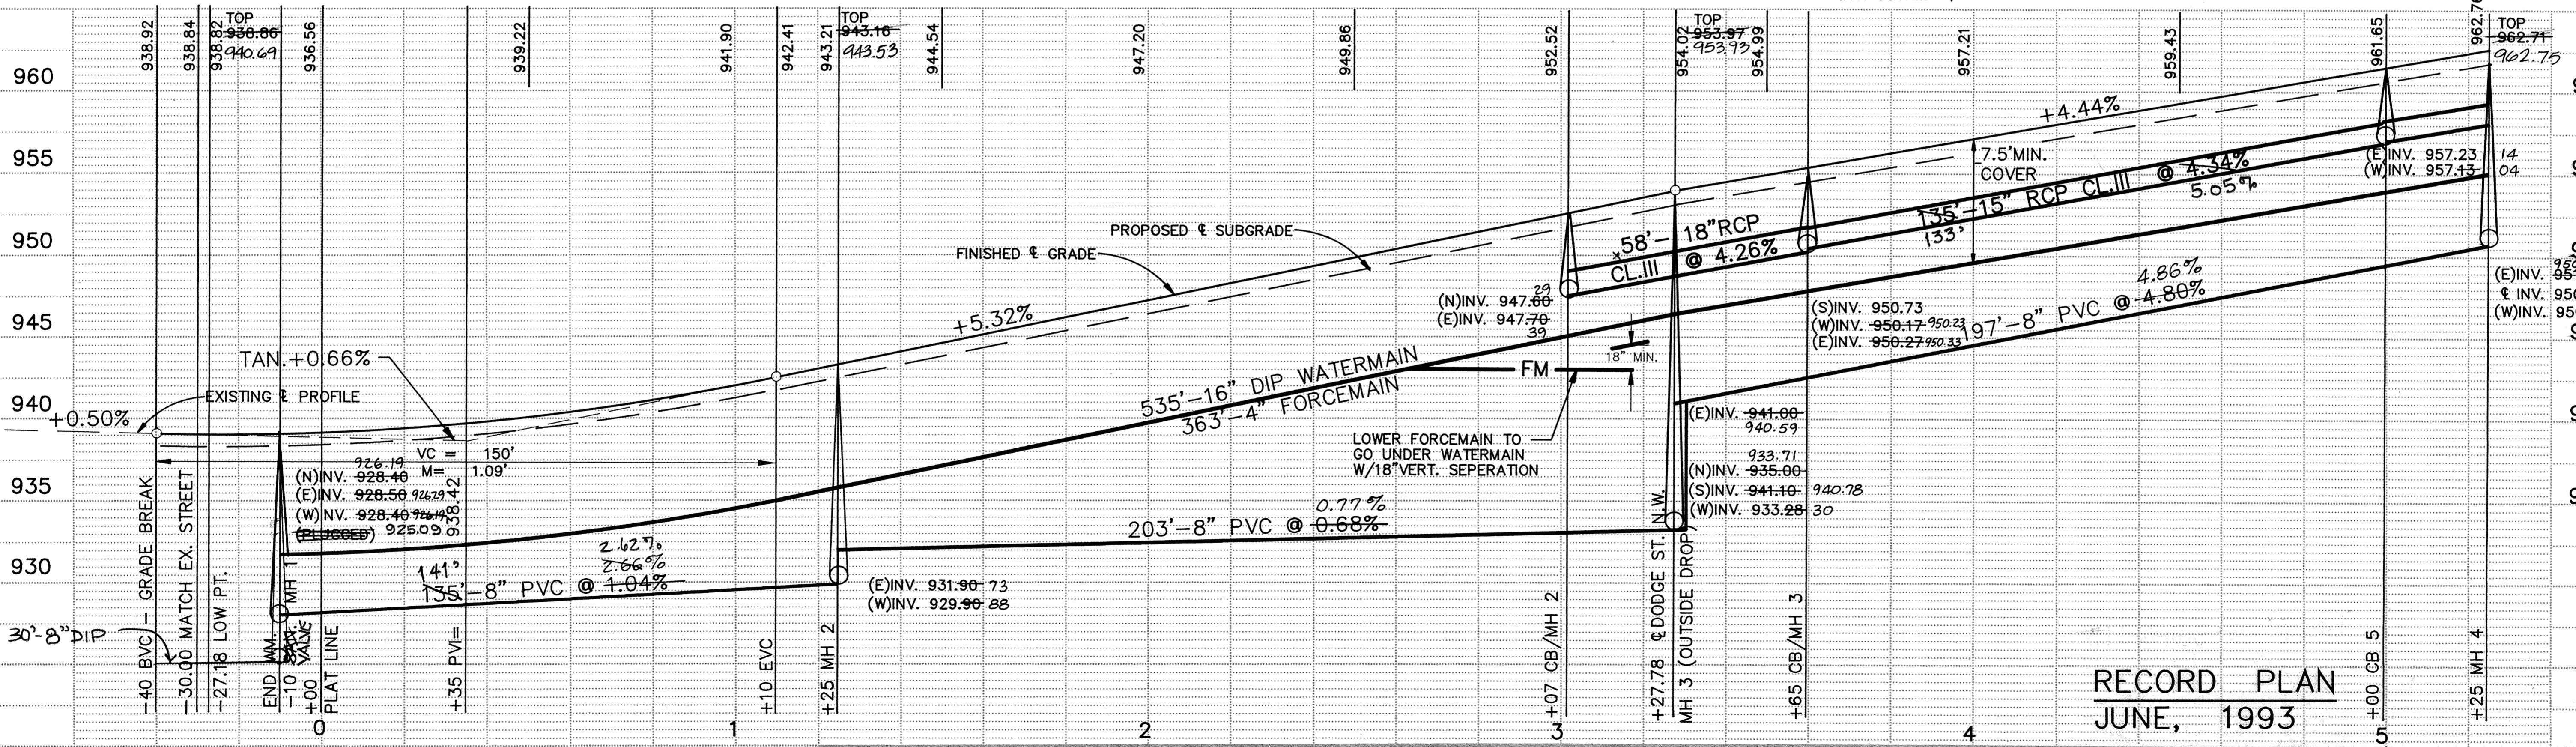


# 193RD AVENUE N.W.

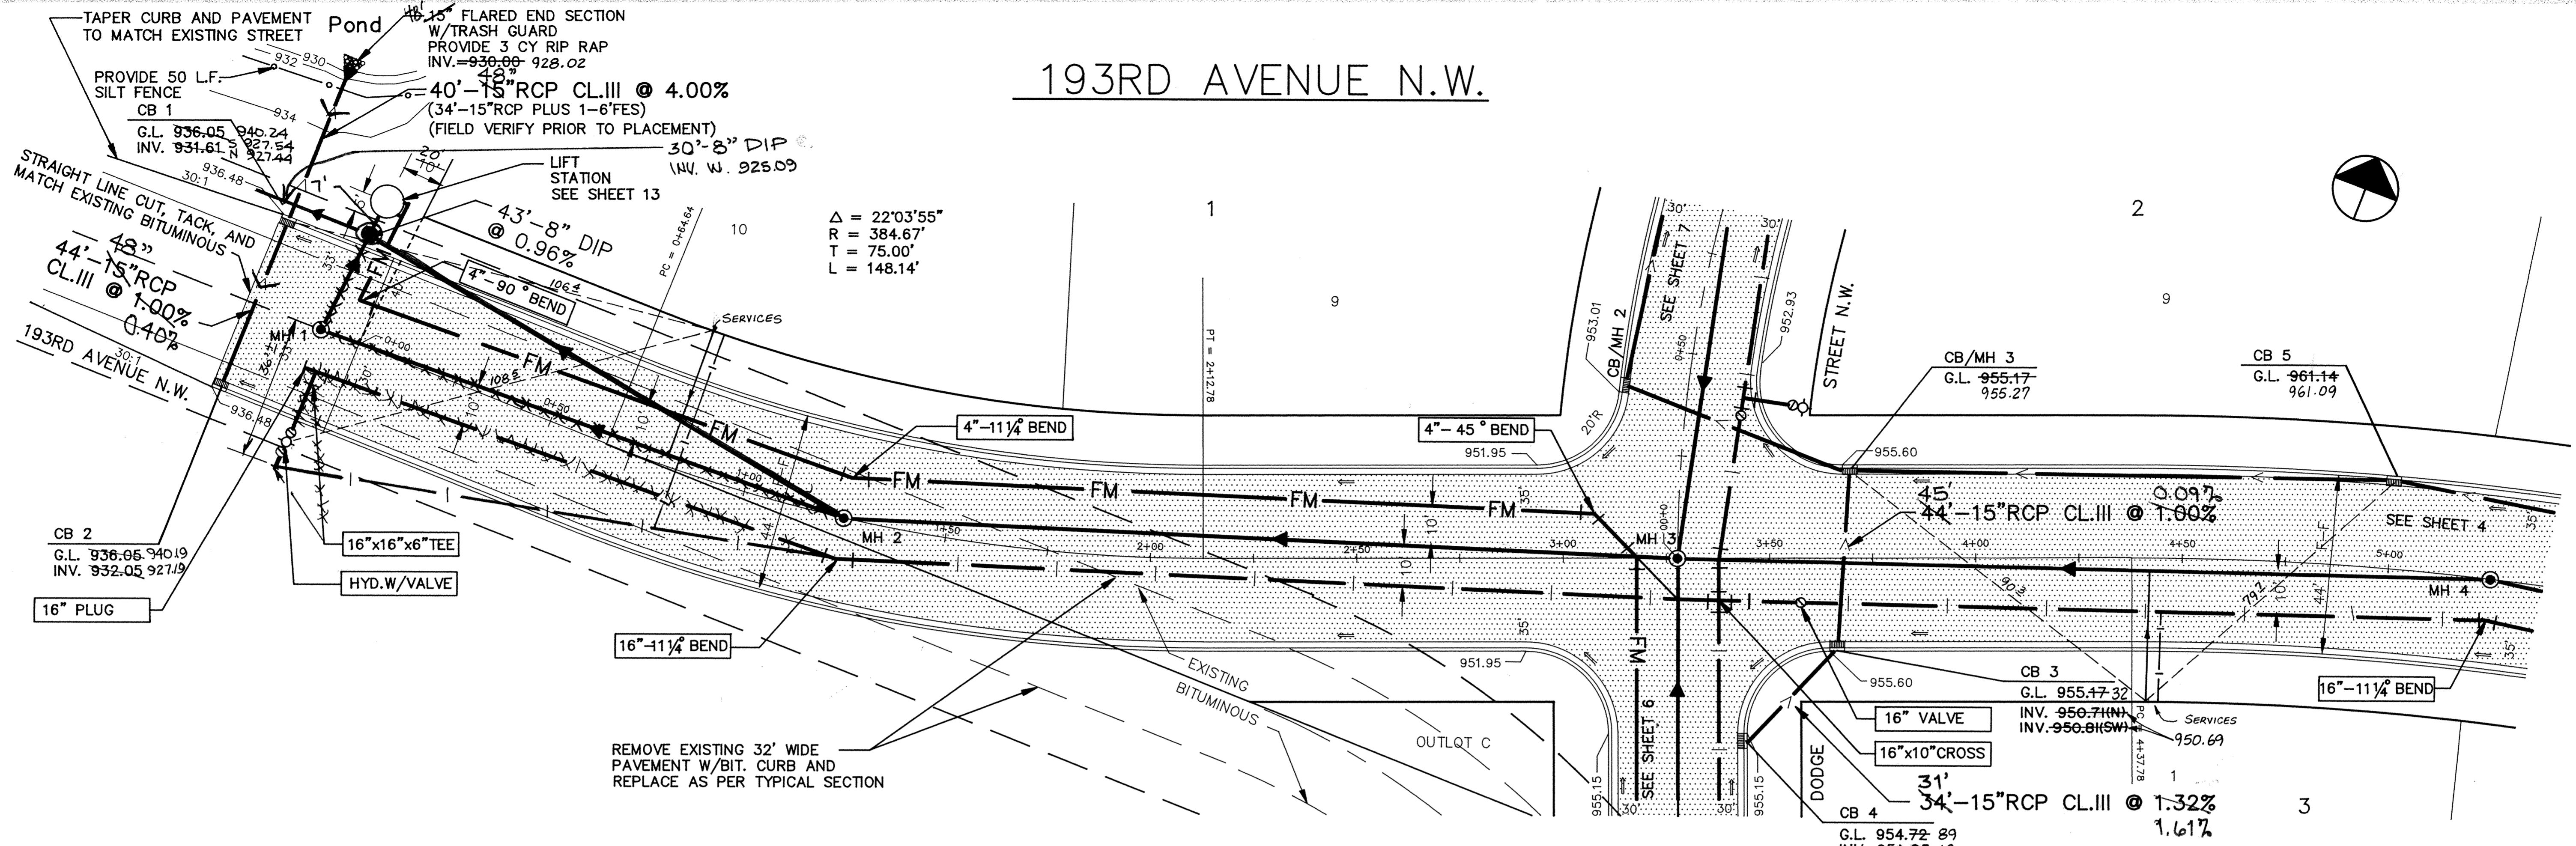

**RECORD PLAN**  
JUNE, 1993

I HEREBY CERTIFY THAT THIS PLAN, SPECIFICATION, OR REPORT WAS PREPARED BY ME OR UNDER MY DIRECT SUPERVISION AND THAT I AM A DULY REGISTERED PROFESSIONAL ENGINEER UNDER THE LAWS OF THE STATE OF MINNESOTA.  
*Terry J. Maurer*  
DATE 6/8/92 REG. NO. 15316

**Maier Stewart & Associates Inc.**  
CONSULTING ENGINEERS  
9800 SHELARD PARKWAY (612) 546-0432 MINNEAPOLIS, MINNESOTA 55441  
1959 SLOAN PLACE (612) 774-6021 ST. PAUL, MINNESOTA 55117

DATE	DESCRIPTION	DESIGNED	CHECKED

CITY OF ELK RIVER  
SANITARY SEWER, WATERMAIN, STORM SEWER  
AND STREET CONSTRUCTION  
193RD AVENUE N.W.  
DATE JUNE, 1992 SHEET 3 OF 19 SHEETS PROJECT NO. 230-140

DRAWING NUMBER

DRAWING NUMBER

DRAWING NUMBER

DRAWING NUMBER  
HILLSET 1.93