
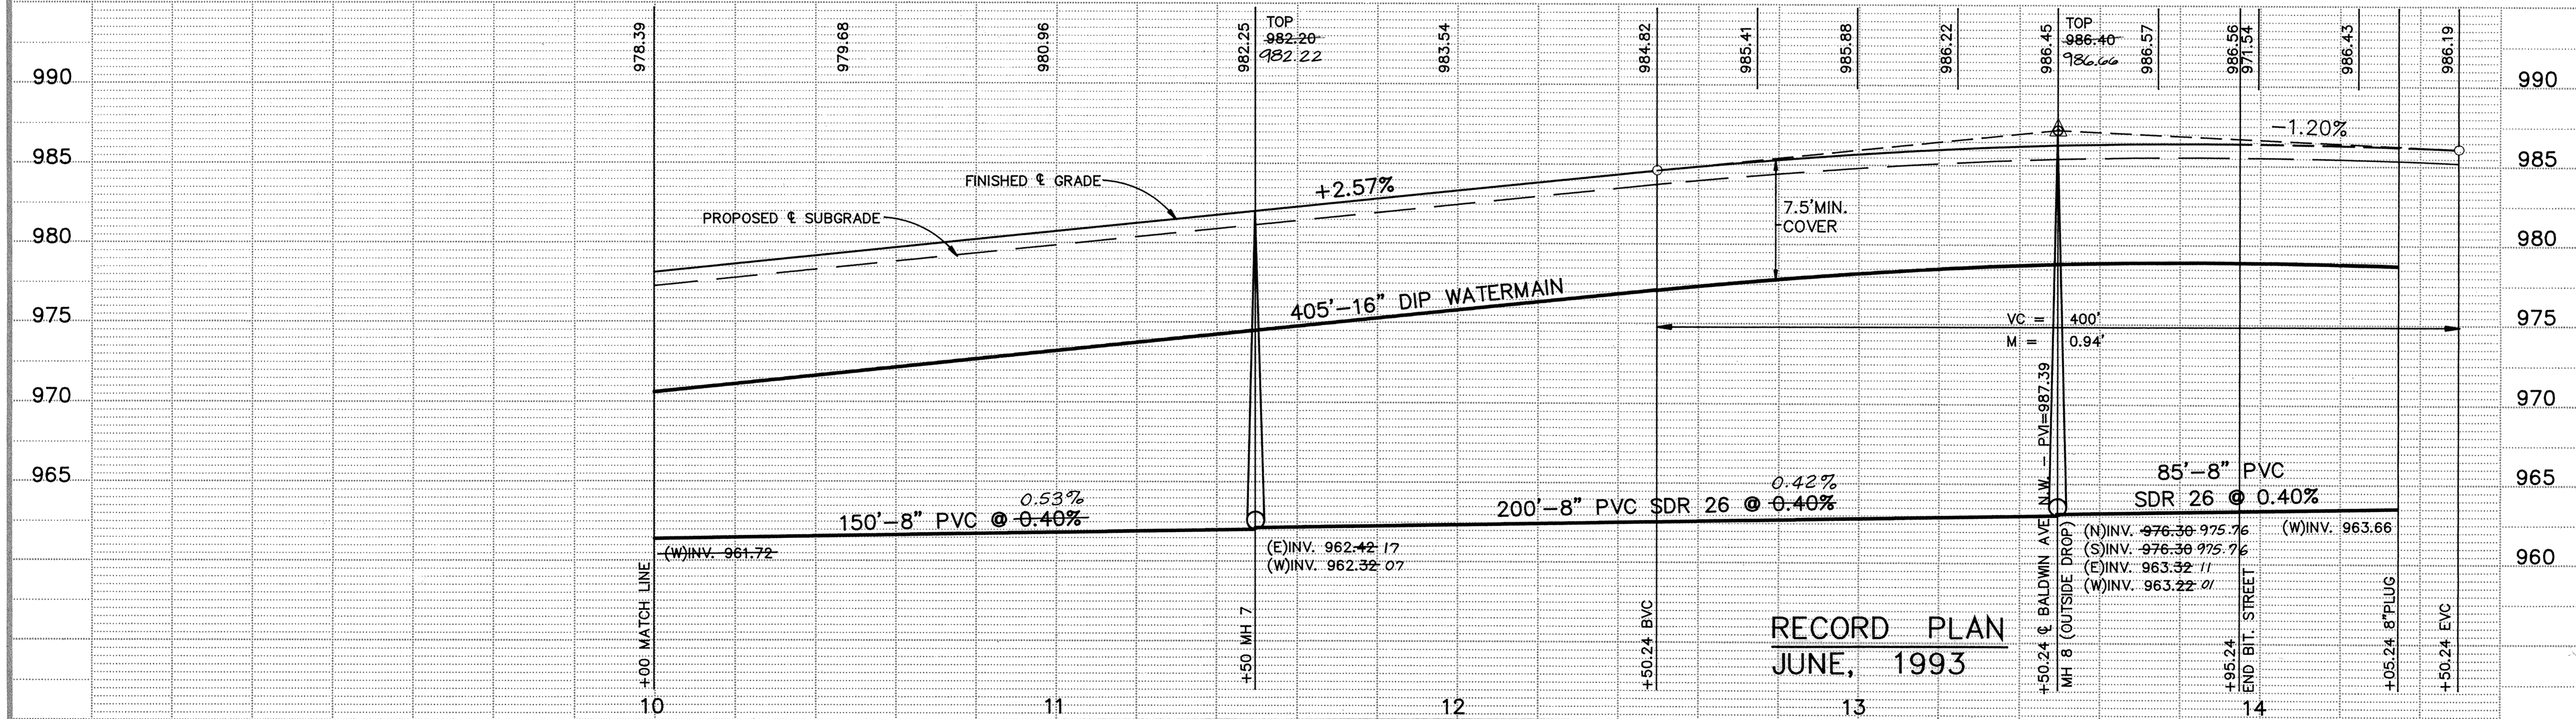


193RD AVENUE N.W.

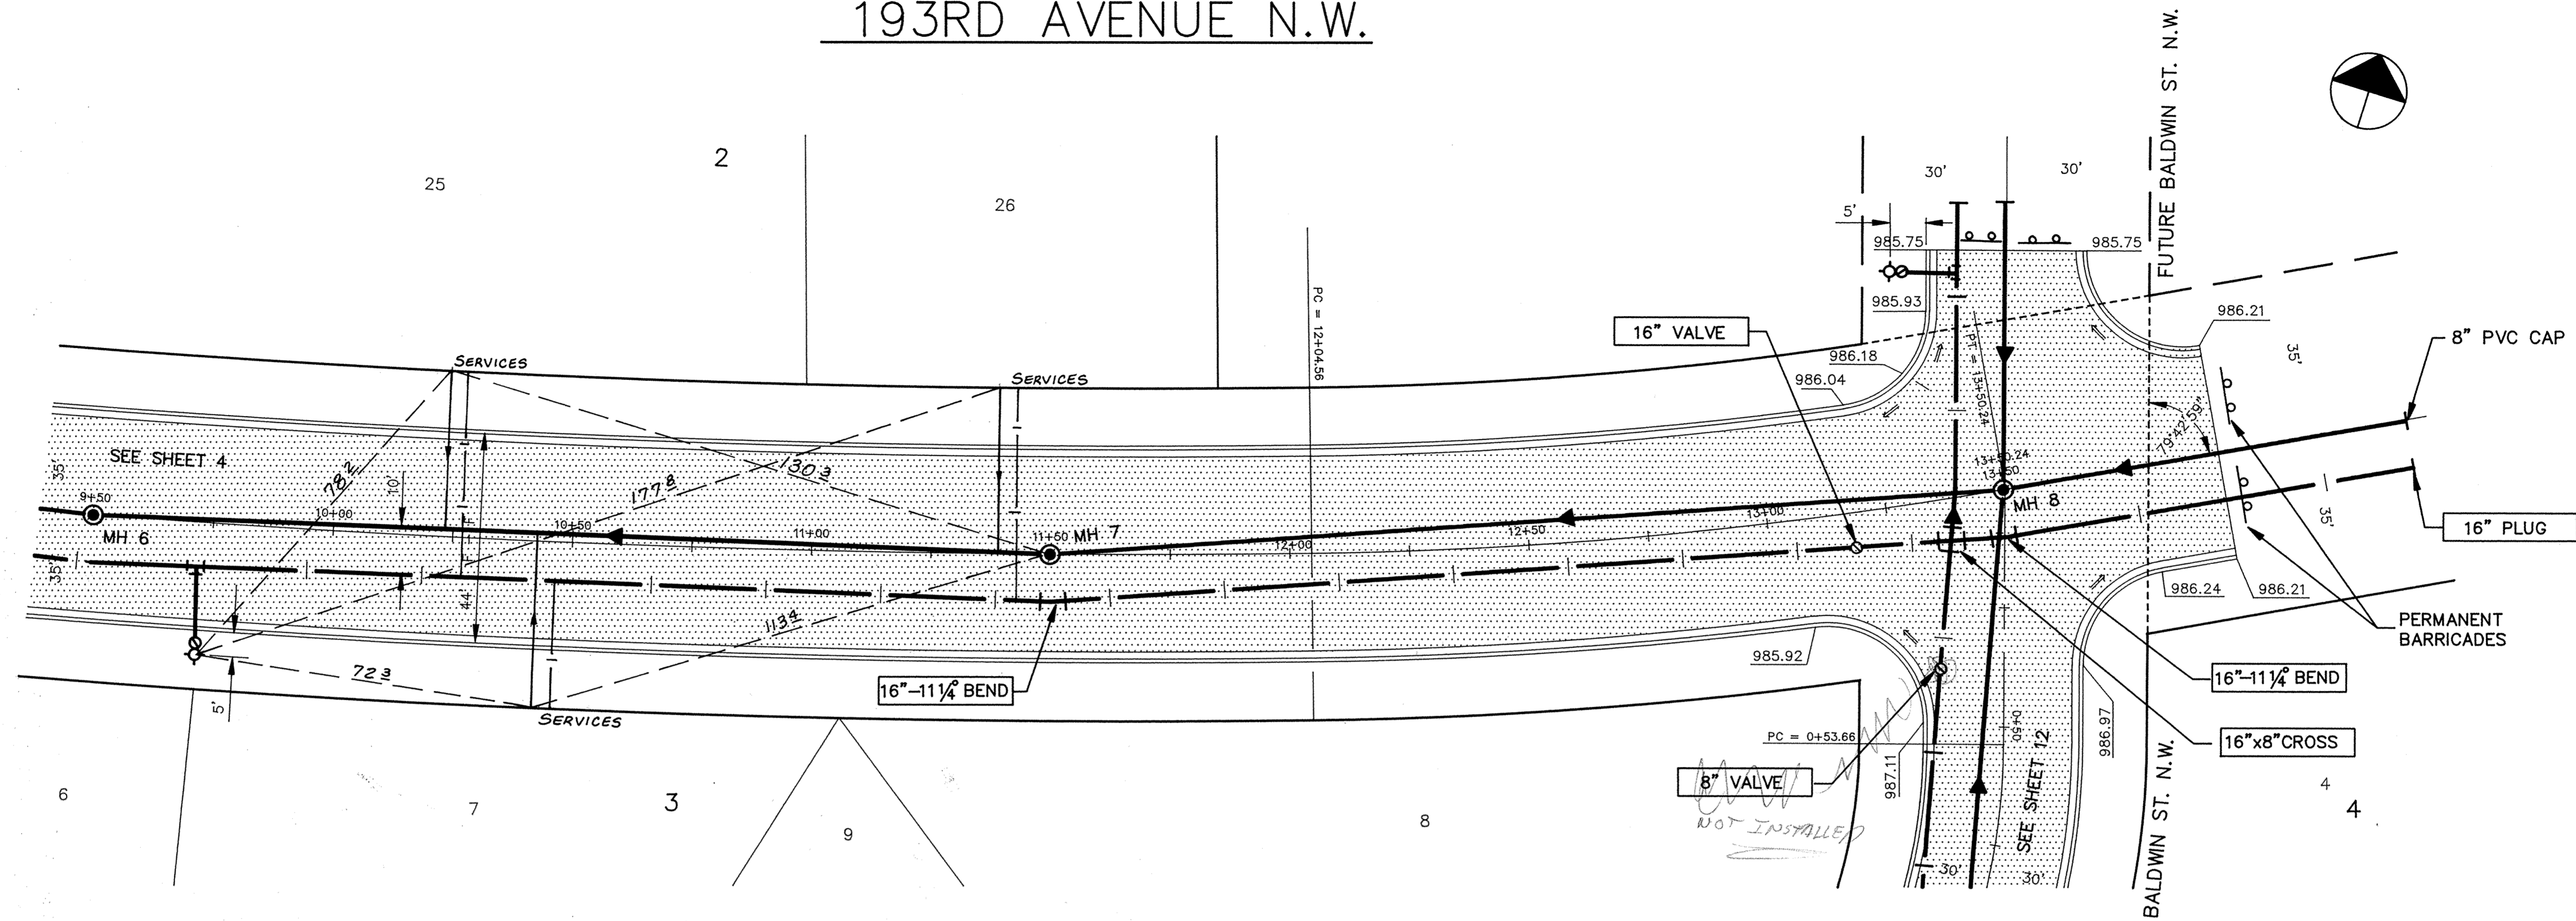

RECORD PLAN
JUNE, 1993

I HEREBY CERTIFY THAT THIS PLAN, SPECIFICATION, OR REPORT WAS PREPARED BY ME OR UNDER MY DIRECT SUPERVISION AND THAT I AM A DULY REGISTERED PROFESSIONAL ENGINEER UNDER THE LAWS OF THE STATE OF MINNESOTA.

Randy Maun
DATE 6/8/92 REG. NO. 15314

Maier Stewart & Associates Inc.
CONSULTING ENGINEERS
9800 SHELARD PARKWAY (612) 546-0432 MINNEAPOLIS, MINNESOTA 55441
1959 SLOAN PLACE (612) 774-6021 ST. PAUL, MINNESOTA 55117

DATE	DESCRIPTION	DESIGNED
		CHECKED
		DRAWN MRF
		GRAPHIC SCALE
		0' HORIZ. 20'
		0' VERT. 5'

CITY OF ELK RIVER
SANITARY SEWER, WATERMAIN, STORM SEWER
AND STREET CONSTRUCTION
193RD AVENUE N.W.

DATE: JUNE 1992 SHEET 5 OF 19 SHEETS PROJECT NO. 230-140

DRAWING NUMBER HILLS 1.93 5