



SDCO PRODUCTS • NEW HOPE, MINNESOTA  
REORDER BY PART NUMBER 0592  
SDCO PRODUCTS • NEW HOPE, MINNESOTA  
REORDER BY PART NUMBER 0592  
SDCO PRODUCTS • NEW HOPE, MINNESOTA  
REORDER BY PART NUMBER 0592  
SDCO PRODUCTS • NEW HOPE, MINNESOTA  
REORDER BY PART NUMBER 0592

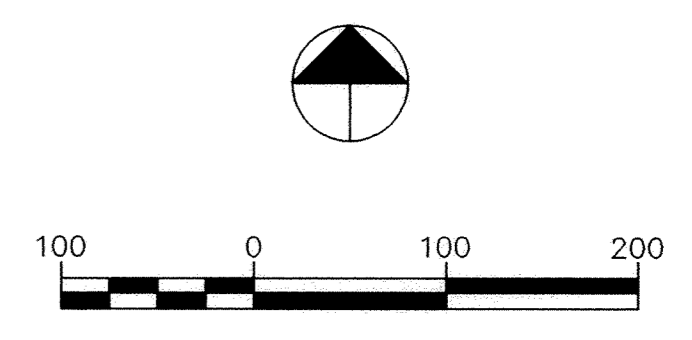

*Handwritten note:*  
Ties to sewer pipe stubs  
Block 1, Lot 1  
Hillside Second addn  
last empty lot  
digging next week

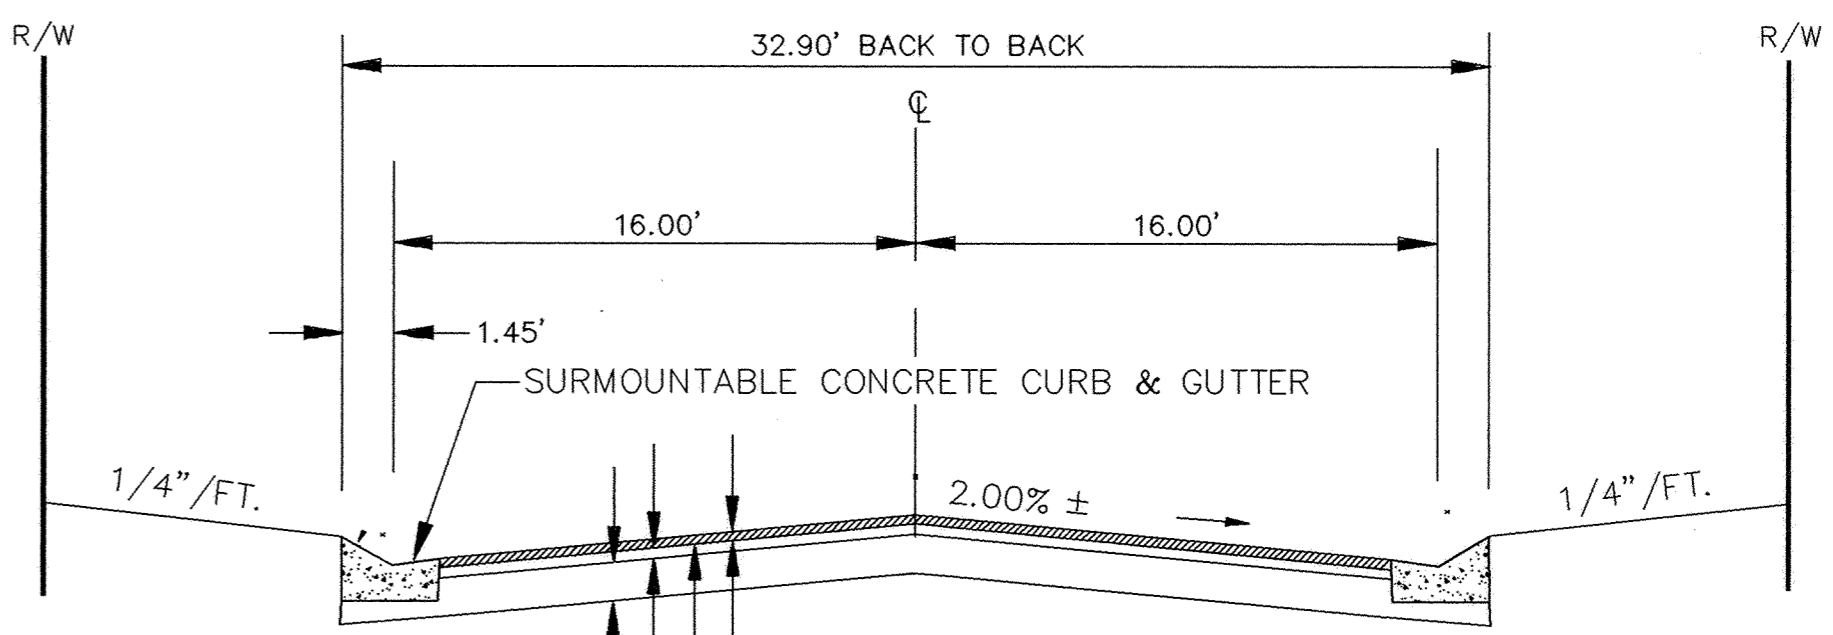

**NOTE:**  
B618 CONCRETE CURB AND GUTTER SHALL BE PLACED AROUND RADII AND AT STORM SEWER STRUCTURES.

**TYPICAL STREET SECTION**  
(60' R.O.W.)  
BALDWIN STREET N.W.  
**RECORD PLAN**  
AUGUST 1994

I HEREBY CERTIFY THAT THIS PLAN, SPECIFICATION, OR REPORT WAS PREPARED BY ME OR UNDER MY DIRECT SUPERVISION AND THAT I AM A DULY REGISTERED PROFESSIONAL ENGINEER UNDER THE LAWS OF THE STATE OF MINNESOTA.  
*Mark J. Spahn*  
DATE 10/27/93 REG. NO. 19130



1326 ENERGY PARK DRIVE  
ST. PAUL, MINNESOTA 55108  
(612) 644-4389  
9800 SHELARD PARKWAY  
MINNEAPOLIS, MINNESOTA 55441  
(612) 546-0432

REVISIONS	DATE	DESCRIPTION	DESIGNED	M/JG
			CHECKED	BAI
			DRAWN	CLS
			GRAPHIC SCALE	
			0' HORIZ.	
			0' VERT.	

CITY OF ELK RIVER HILLSIDE ESTATES SECOND ADDITION INDEX MAP		
DATE	OCT. 1993	SHEET <u>2</u> OF <u>7</u> SHEETS
PROJECT NO.	230-199	