
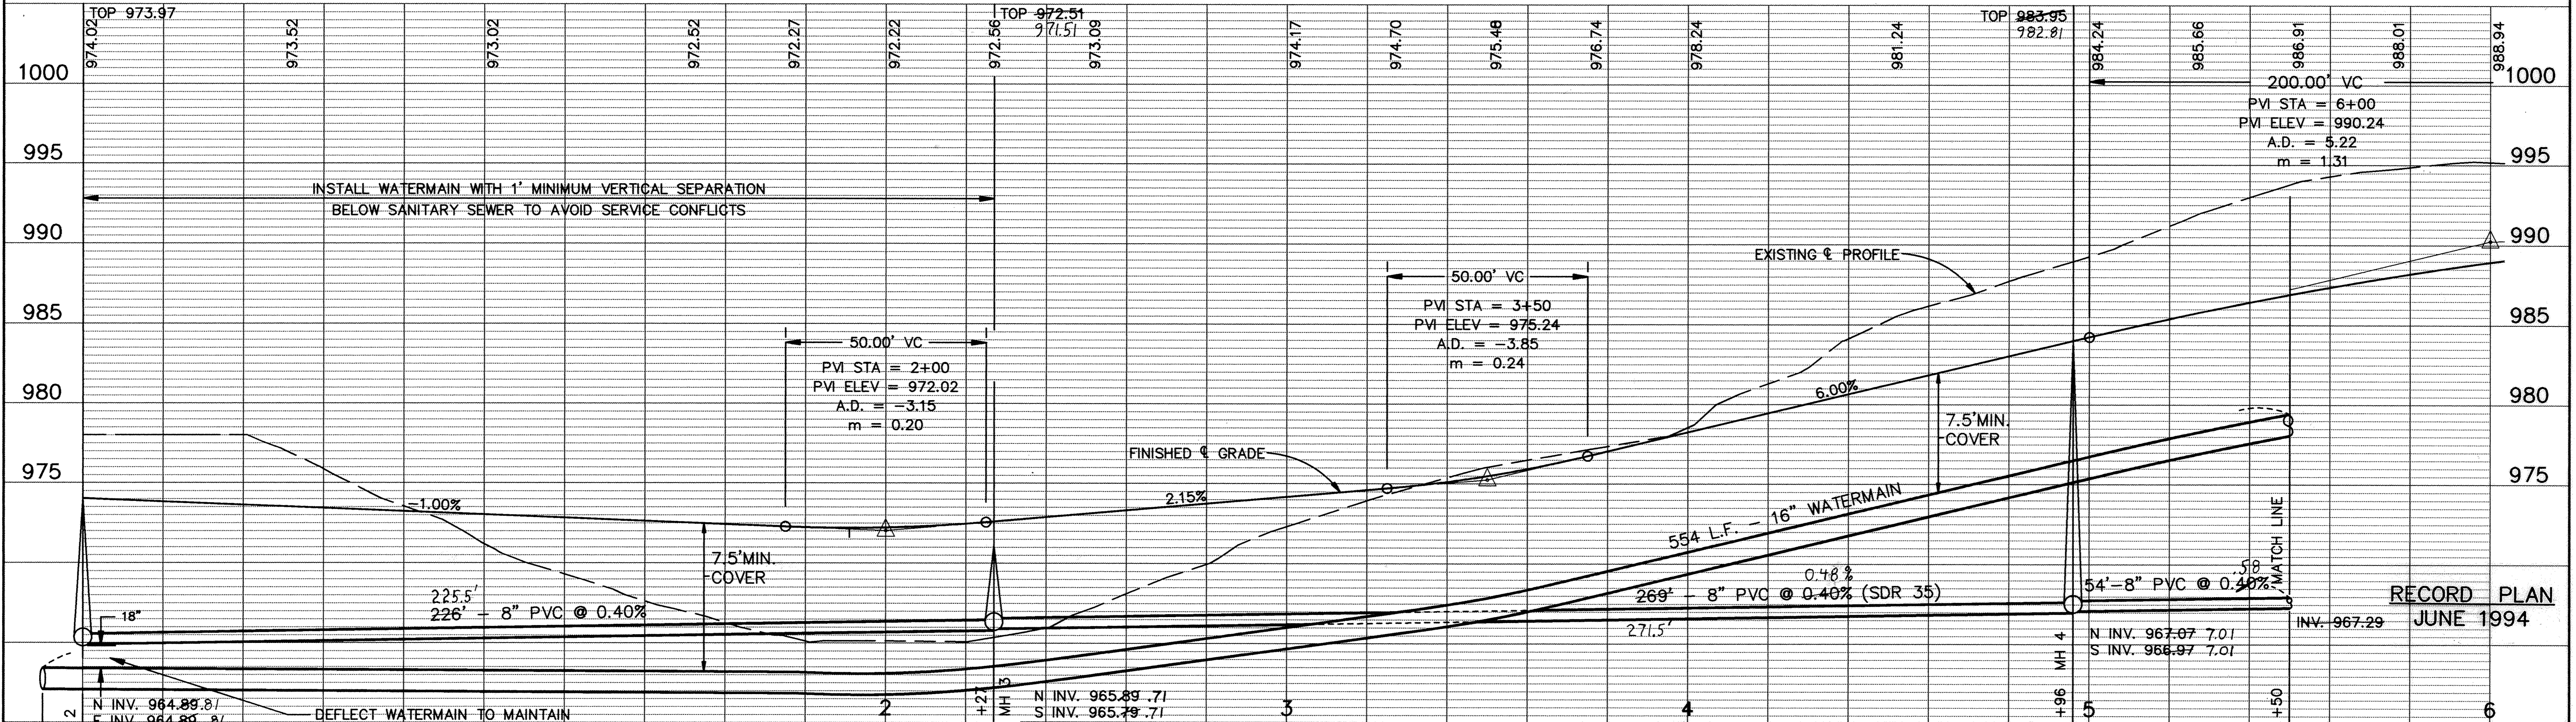


FUTURE STREET

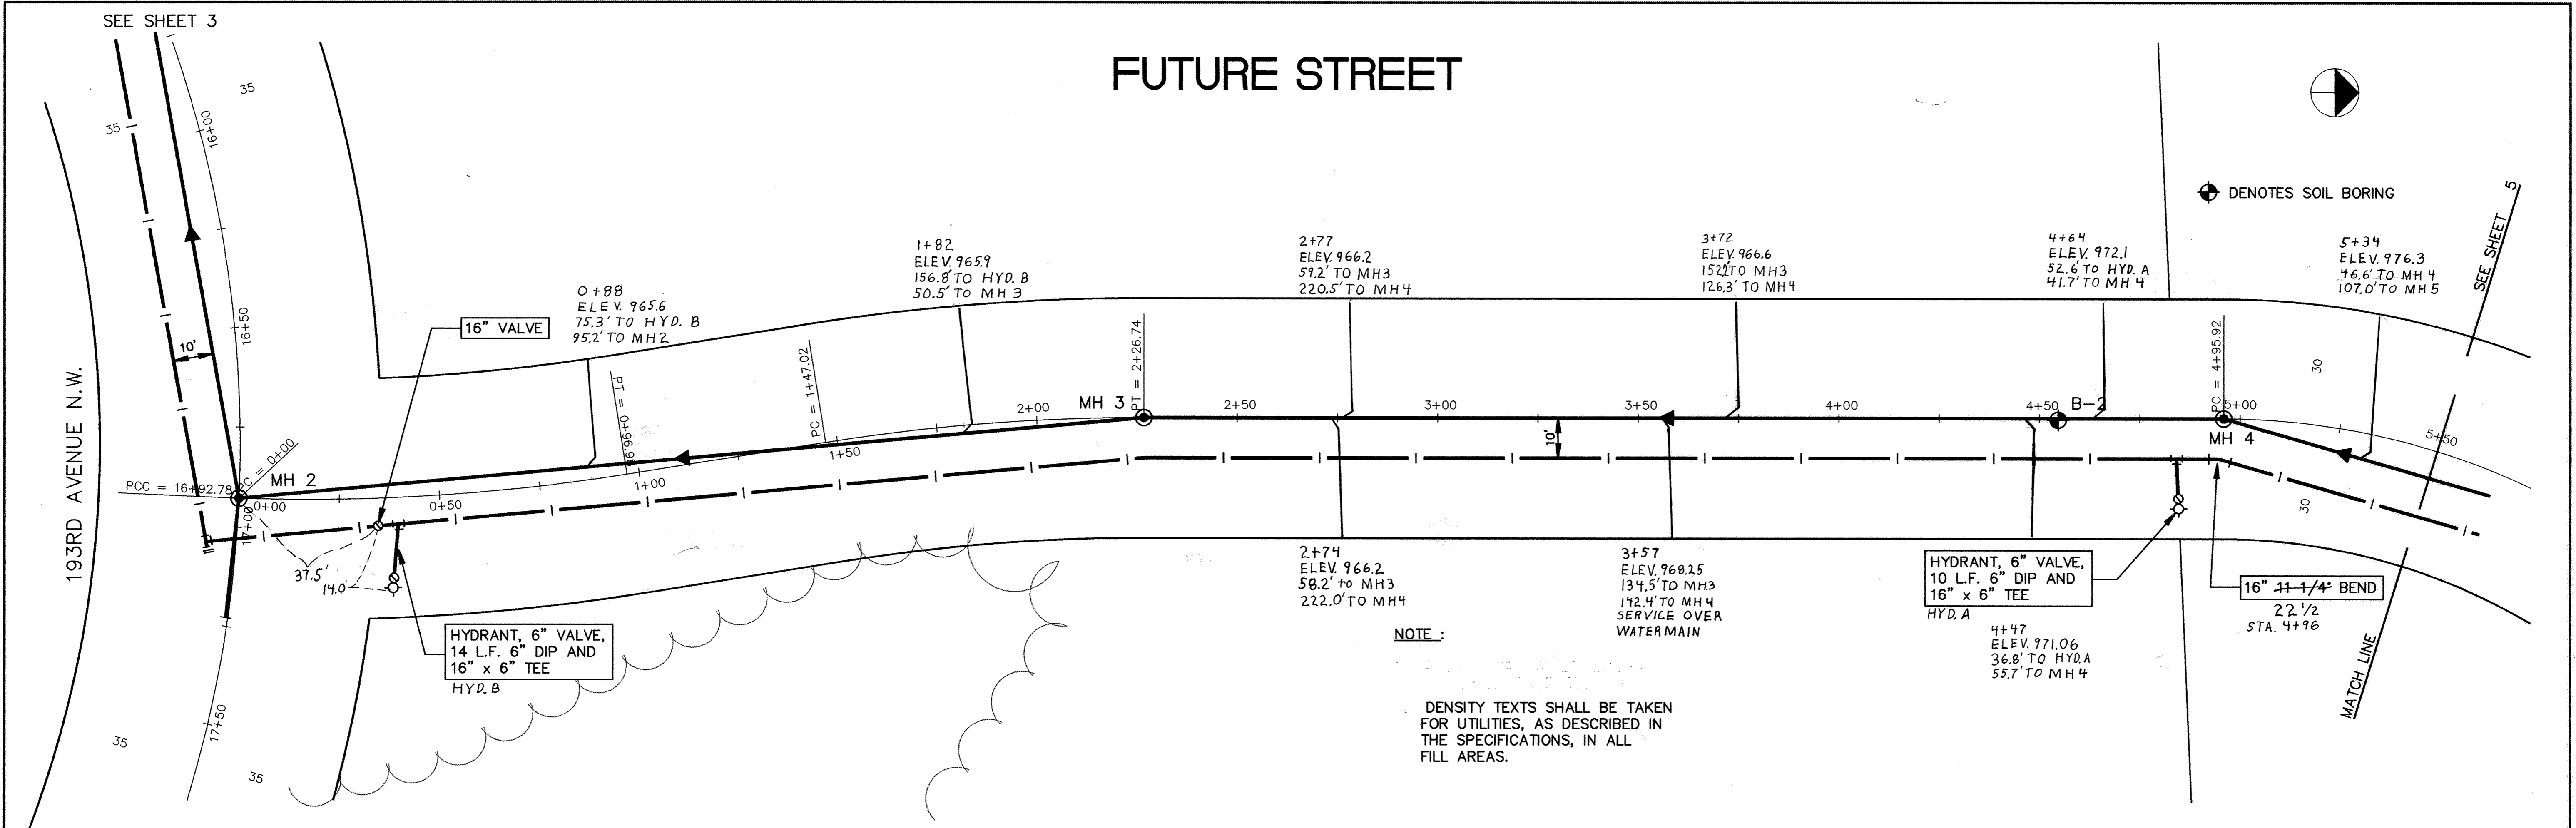

1326 ENERGY PARK DRIVE ST. PAUL, MINNESOTA 55108 (612) 644-4389		DESIGNED MJC CHECKED BAI DRAWN CLS		CITY OF ELK RIVER SANITARY SEWER AND WATERMAIN FUTURE STREET	
9800 SHELARD PARKWAY MINNEAPOLIS, MINNESOTA 55441 (612) 546-0432		GRAPHIC SCALE 0 HORIZ. 20 0 VERT. 5		STA. 0+00 TO 5+50	
I HEREBY CERTIFY THAT THIS PLAN, SPECIFICATION, OR REPORT WAS PREPARED BY ME OR UNDER MY DIRECT SUPERVISION AND THAT I AM A DULY REGISTERED PROFESSIONAL ENGINEER UNDER THE LAWS OF THE STATE OF MINNESOTA. <i>Mark S. Gerhard</i> DATE 10/21/93 REG. NO. 19130		REVISIONS DATE DESCRIPTION		DATE SEPT. 1993 SHEET 4 OF 12 SHEETS PROJECT NO. 230-190	