


STATION	AREAS Square Feet		VOLUMES Cubic Yards		CUMULATIVE VOLUMES Cubic Yards	
	CUT	FILL	CUT	FILL	CUT	FILL
13+50.24	881.39	0.00	1414.10	0.00	1414.10	0.00
14+00	653.21	0.00	929.01	0.00	2343.11	0.00
14+50	350.12	0.00	324.19	333.57	2667.29	333.57
15+00	0.00	360.26	0.00	354.61	2667.29	688.18
15+20.20	0.00	587.48	0.00	572.48	2667.29	1260.66
15+50	0.00	453.69	0.00	520.17	2667.29	1780.83
16+00	0.00	122.34	30.87	107.09	2698.16	1887.92
16+50	32.44	3.26	297.43	2.43	2995.59	1890.35
16+92.78	332.76	0.00	0.06	0.00	2995.65	1890.35
16+92.78	332.77	0.00	89.85	0.00	3085.50	1890.35
17+00	340.49	0.00	366.91	101.87	3452.41	1992.22
17+50	73.68	106.01	53.85	397.81	3506.26	2390.02
17+91.18	0.00	390.54	0.00	0.00	3506.26	2390.02

NOTE :
GRADE TO PROPOSED FINISHED STREET CENTERLINE.

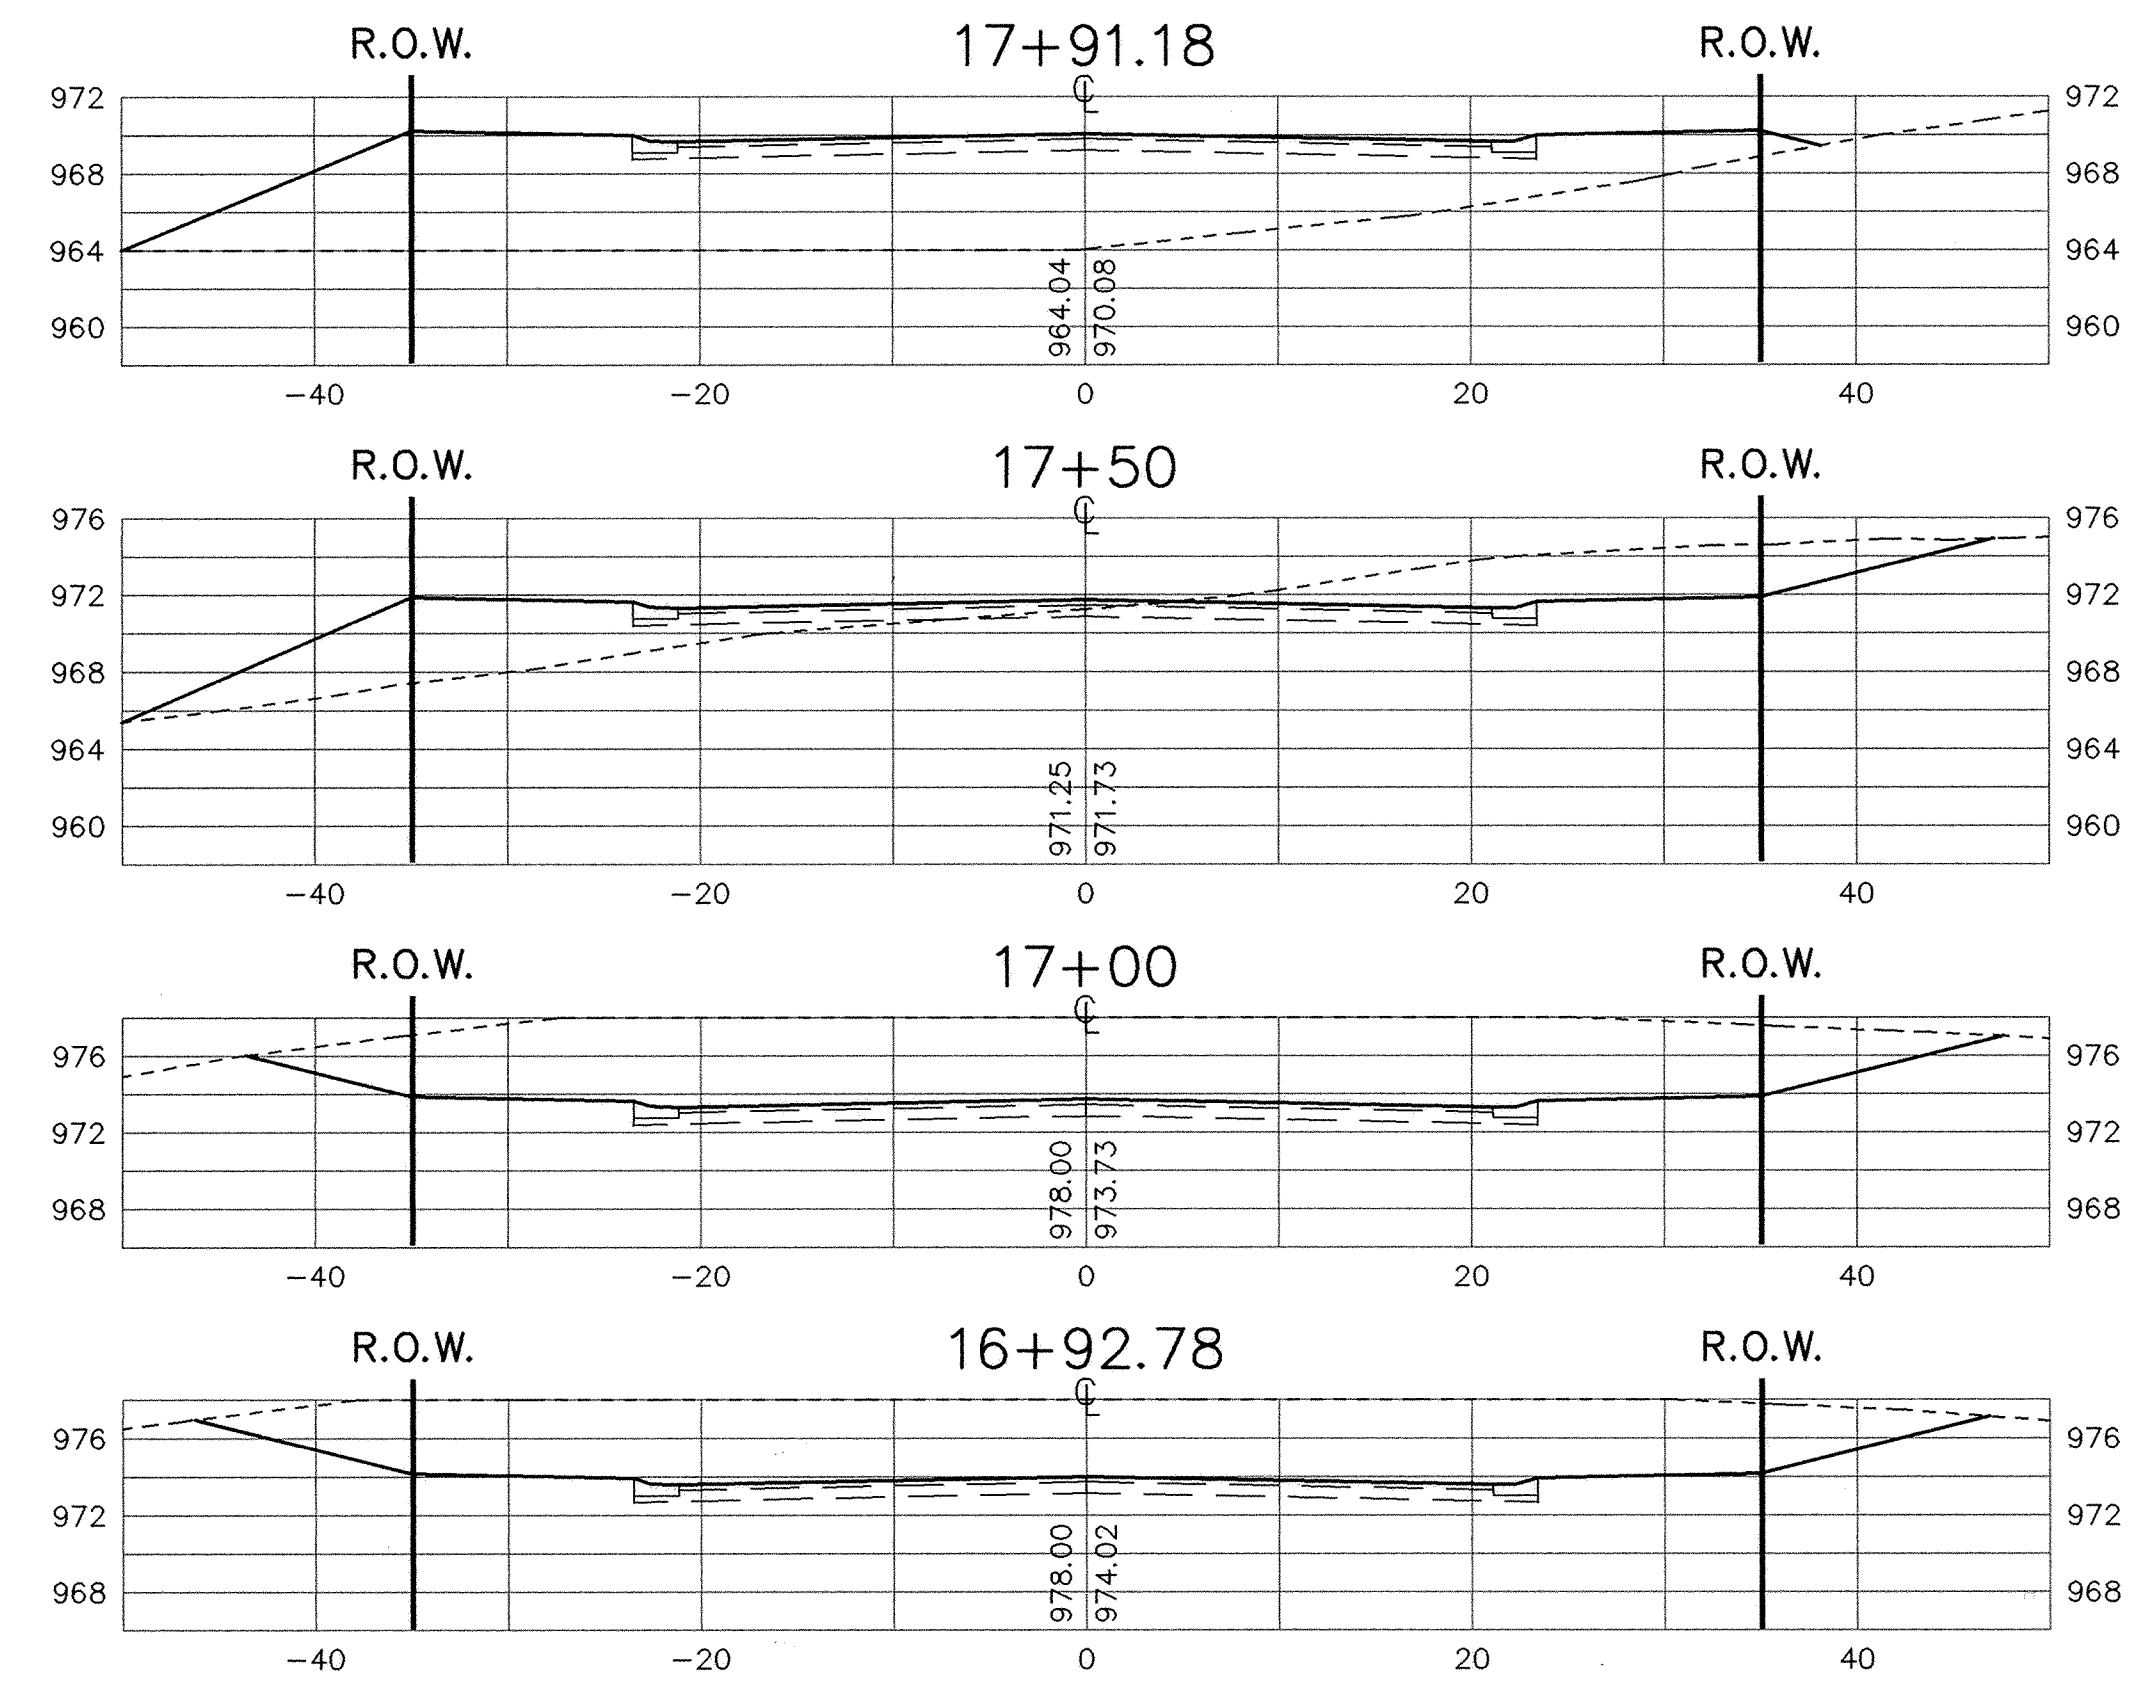

RECORD PLAN
JUNE 1994

I HEREBY CERTIFY THAT THIS PLAN, SPECIFICATION, OR REPORT WAS PREPARED BY ME OR UNDER MY DIRECT SUPERVISION AND THAT I AM A DULY REGISTERED PROFESSIONAL ENGINEER UNDER THE LAWS OF THE STATE OF MINNESOTA.
Mark J. Graham
DATE 10/21/93 REG. NO. 19135



1326 ENERGY PARK DRIVE
ST. PAUL, MINNESOTA 55108
(612) 644-4389
9800 SHELARD PARKWAY
MINNEAPOLIS, MINNESOTA 55441
(612) 546-0432

DATE	DESCRIPTION	DESIGNED	CHECKED

REVISIONS

NO.	DATE	DESCRIPTION

GRAPHIC SCALE
0 HORIZ. 10
0 VERT. 5

CITY OF ELK RIVER
193RD AVENUE N.W. STA.
CROSS SECTIONS 13+50.24 TO 17+91.18

DATE OCT. 1993 SHEET 7 OF 12 SHEETS PROJECT NO. 230-190