



NOTE :  
GRADE TO PROPOSED FINISHED STREET CENTERLINE.

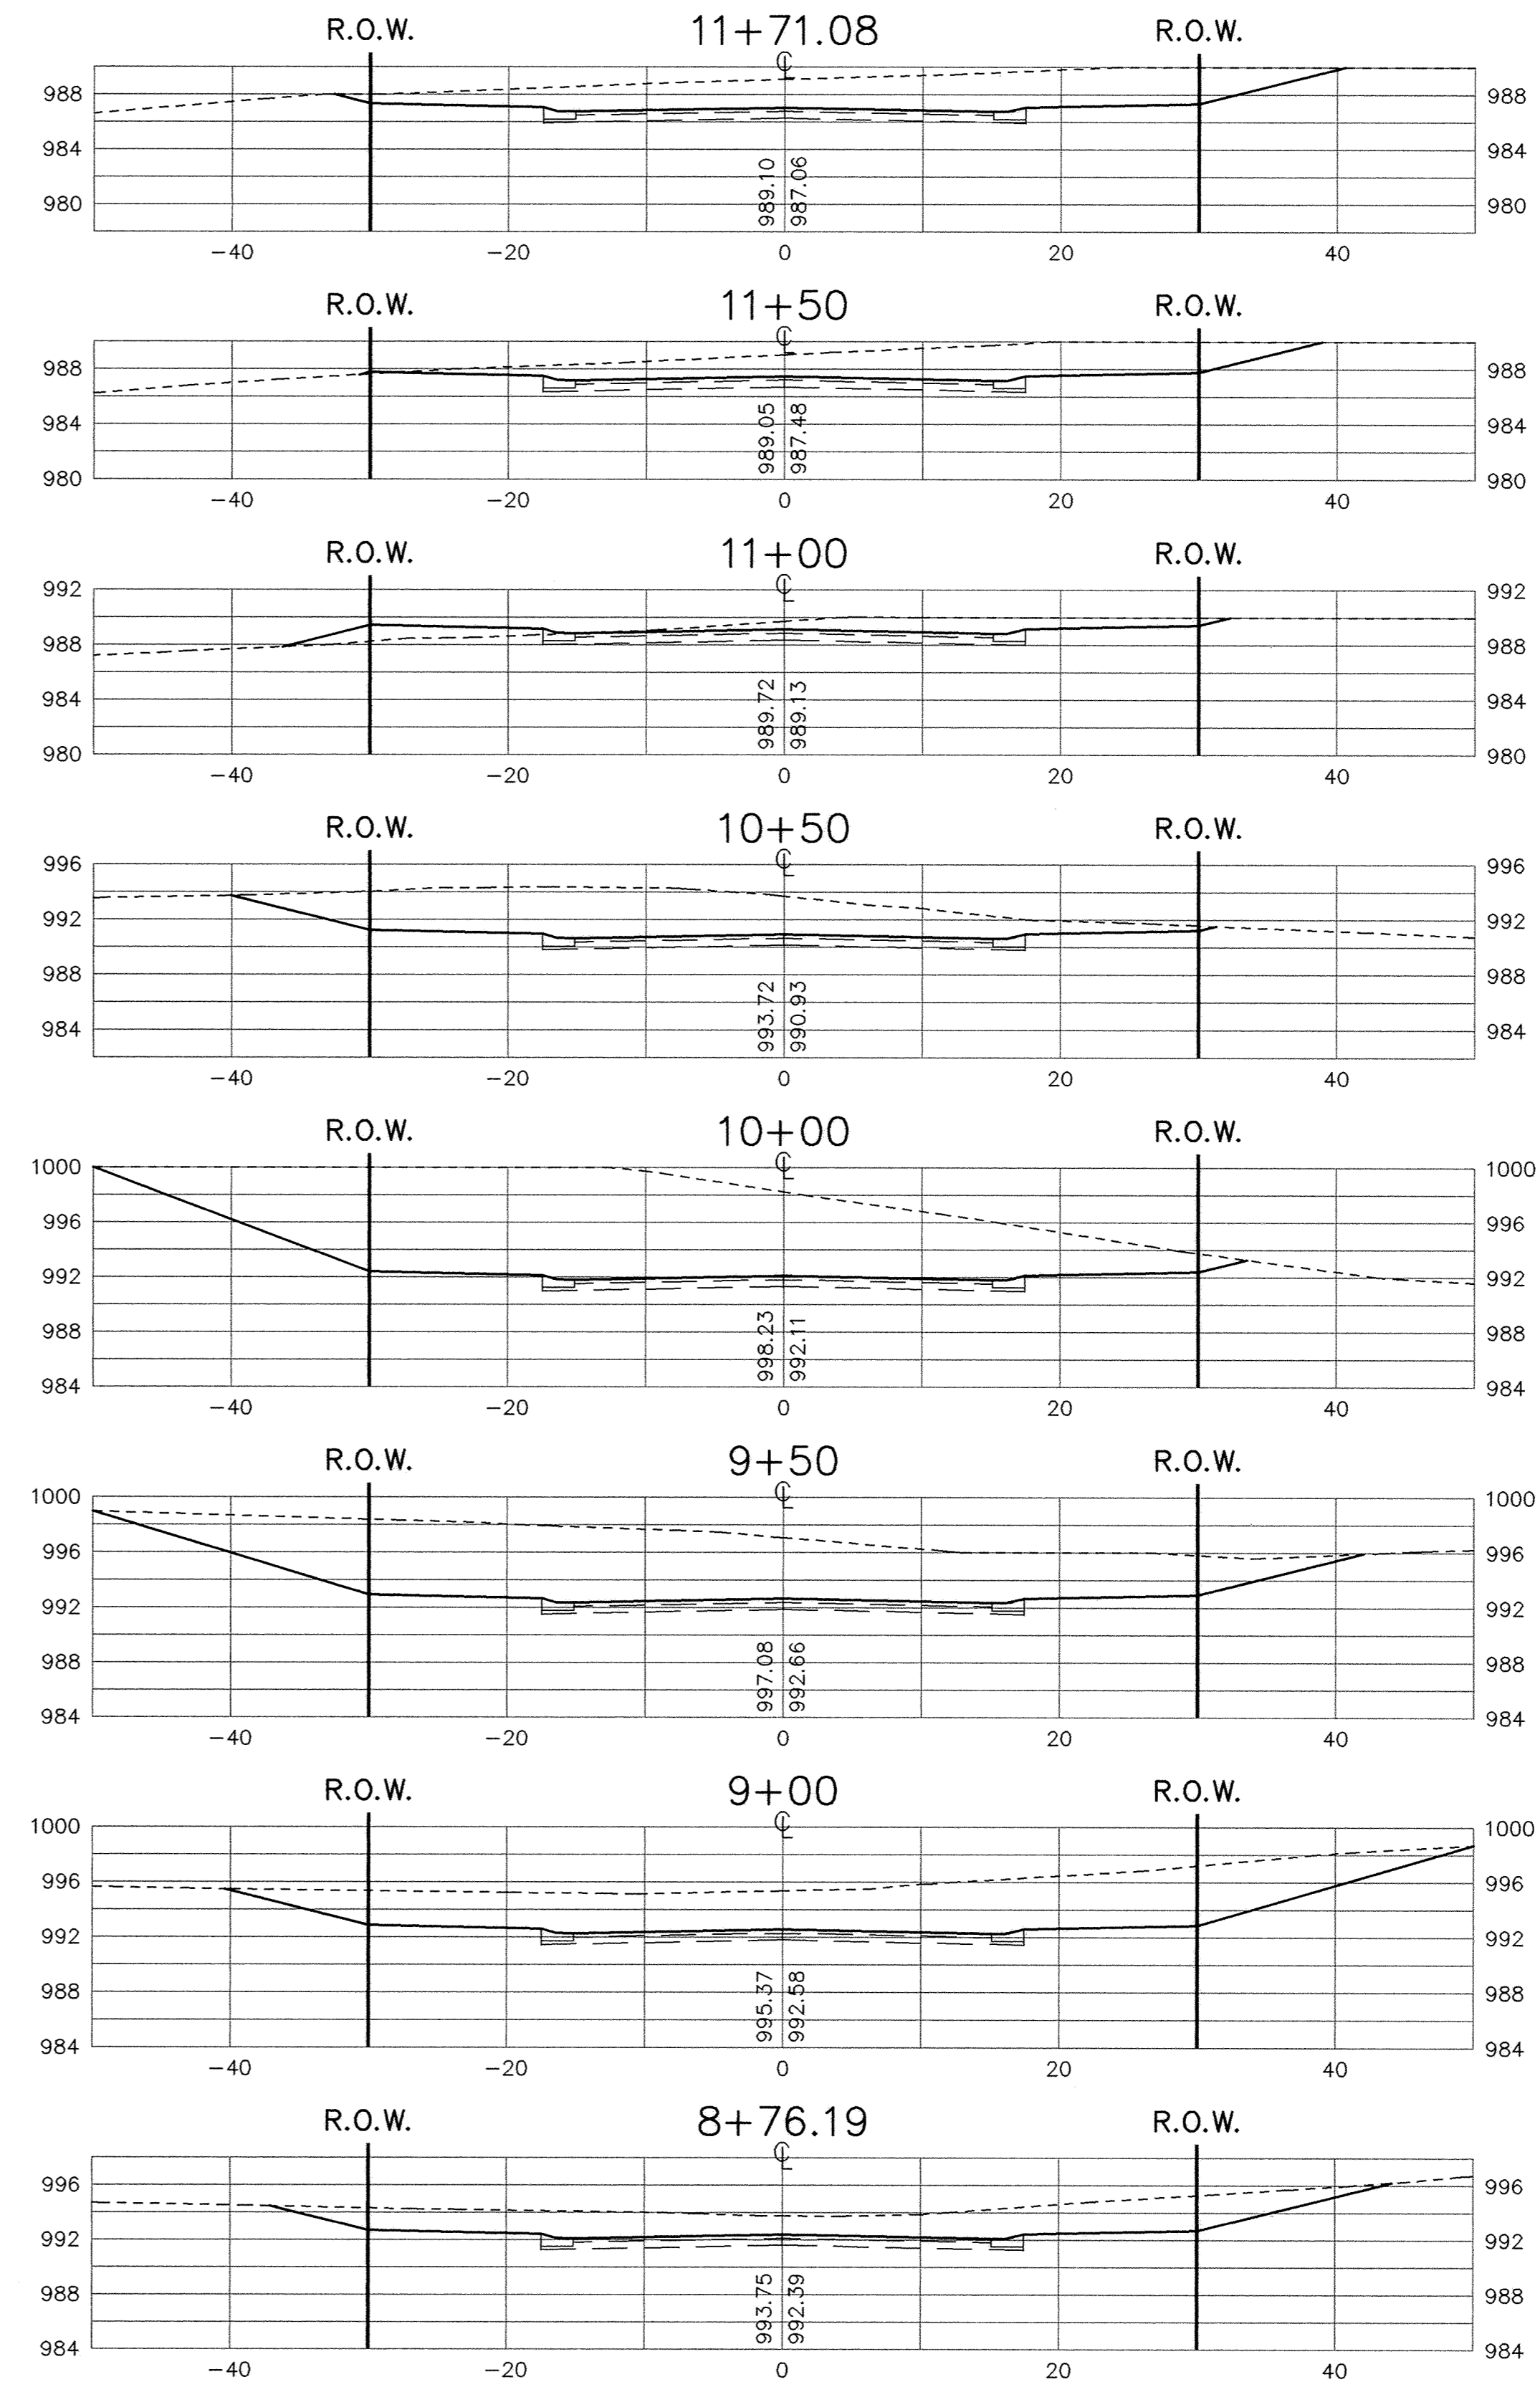

RECORD PLAN  
JUNE 1994

I HEREBY CERTIFY THAT THIS PLAN, SPECIFICATION, OR REPORT WAS PREPARED BY ME OR UNDER MY DIRECT SUPERVISION AND THAT I AM A DULY REGISTERED PROFESSIONAL ENGINEER UNDER THE LAWS OF THE STATE OF MINNESOTA.  
*Mark V. Graham*  
DATE 10/21/93 REG. NO. 19130

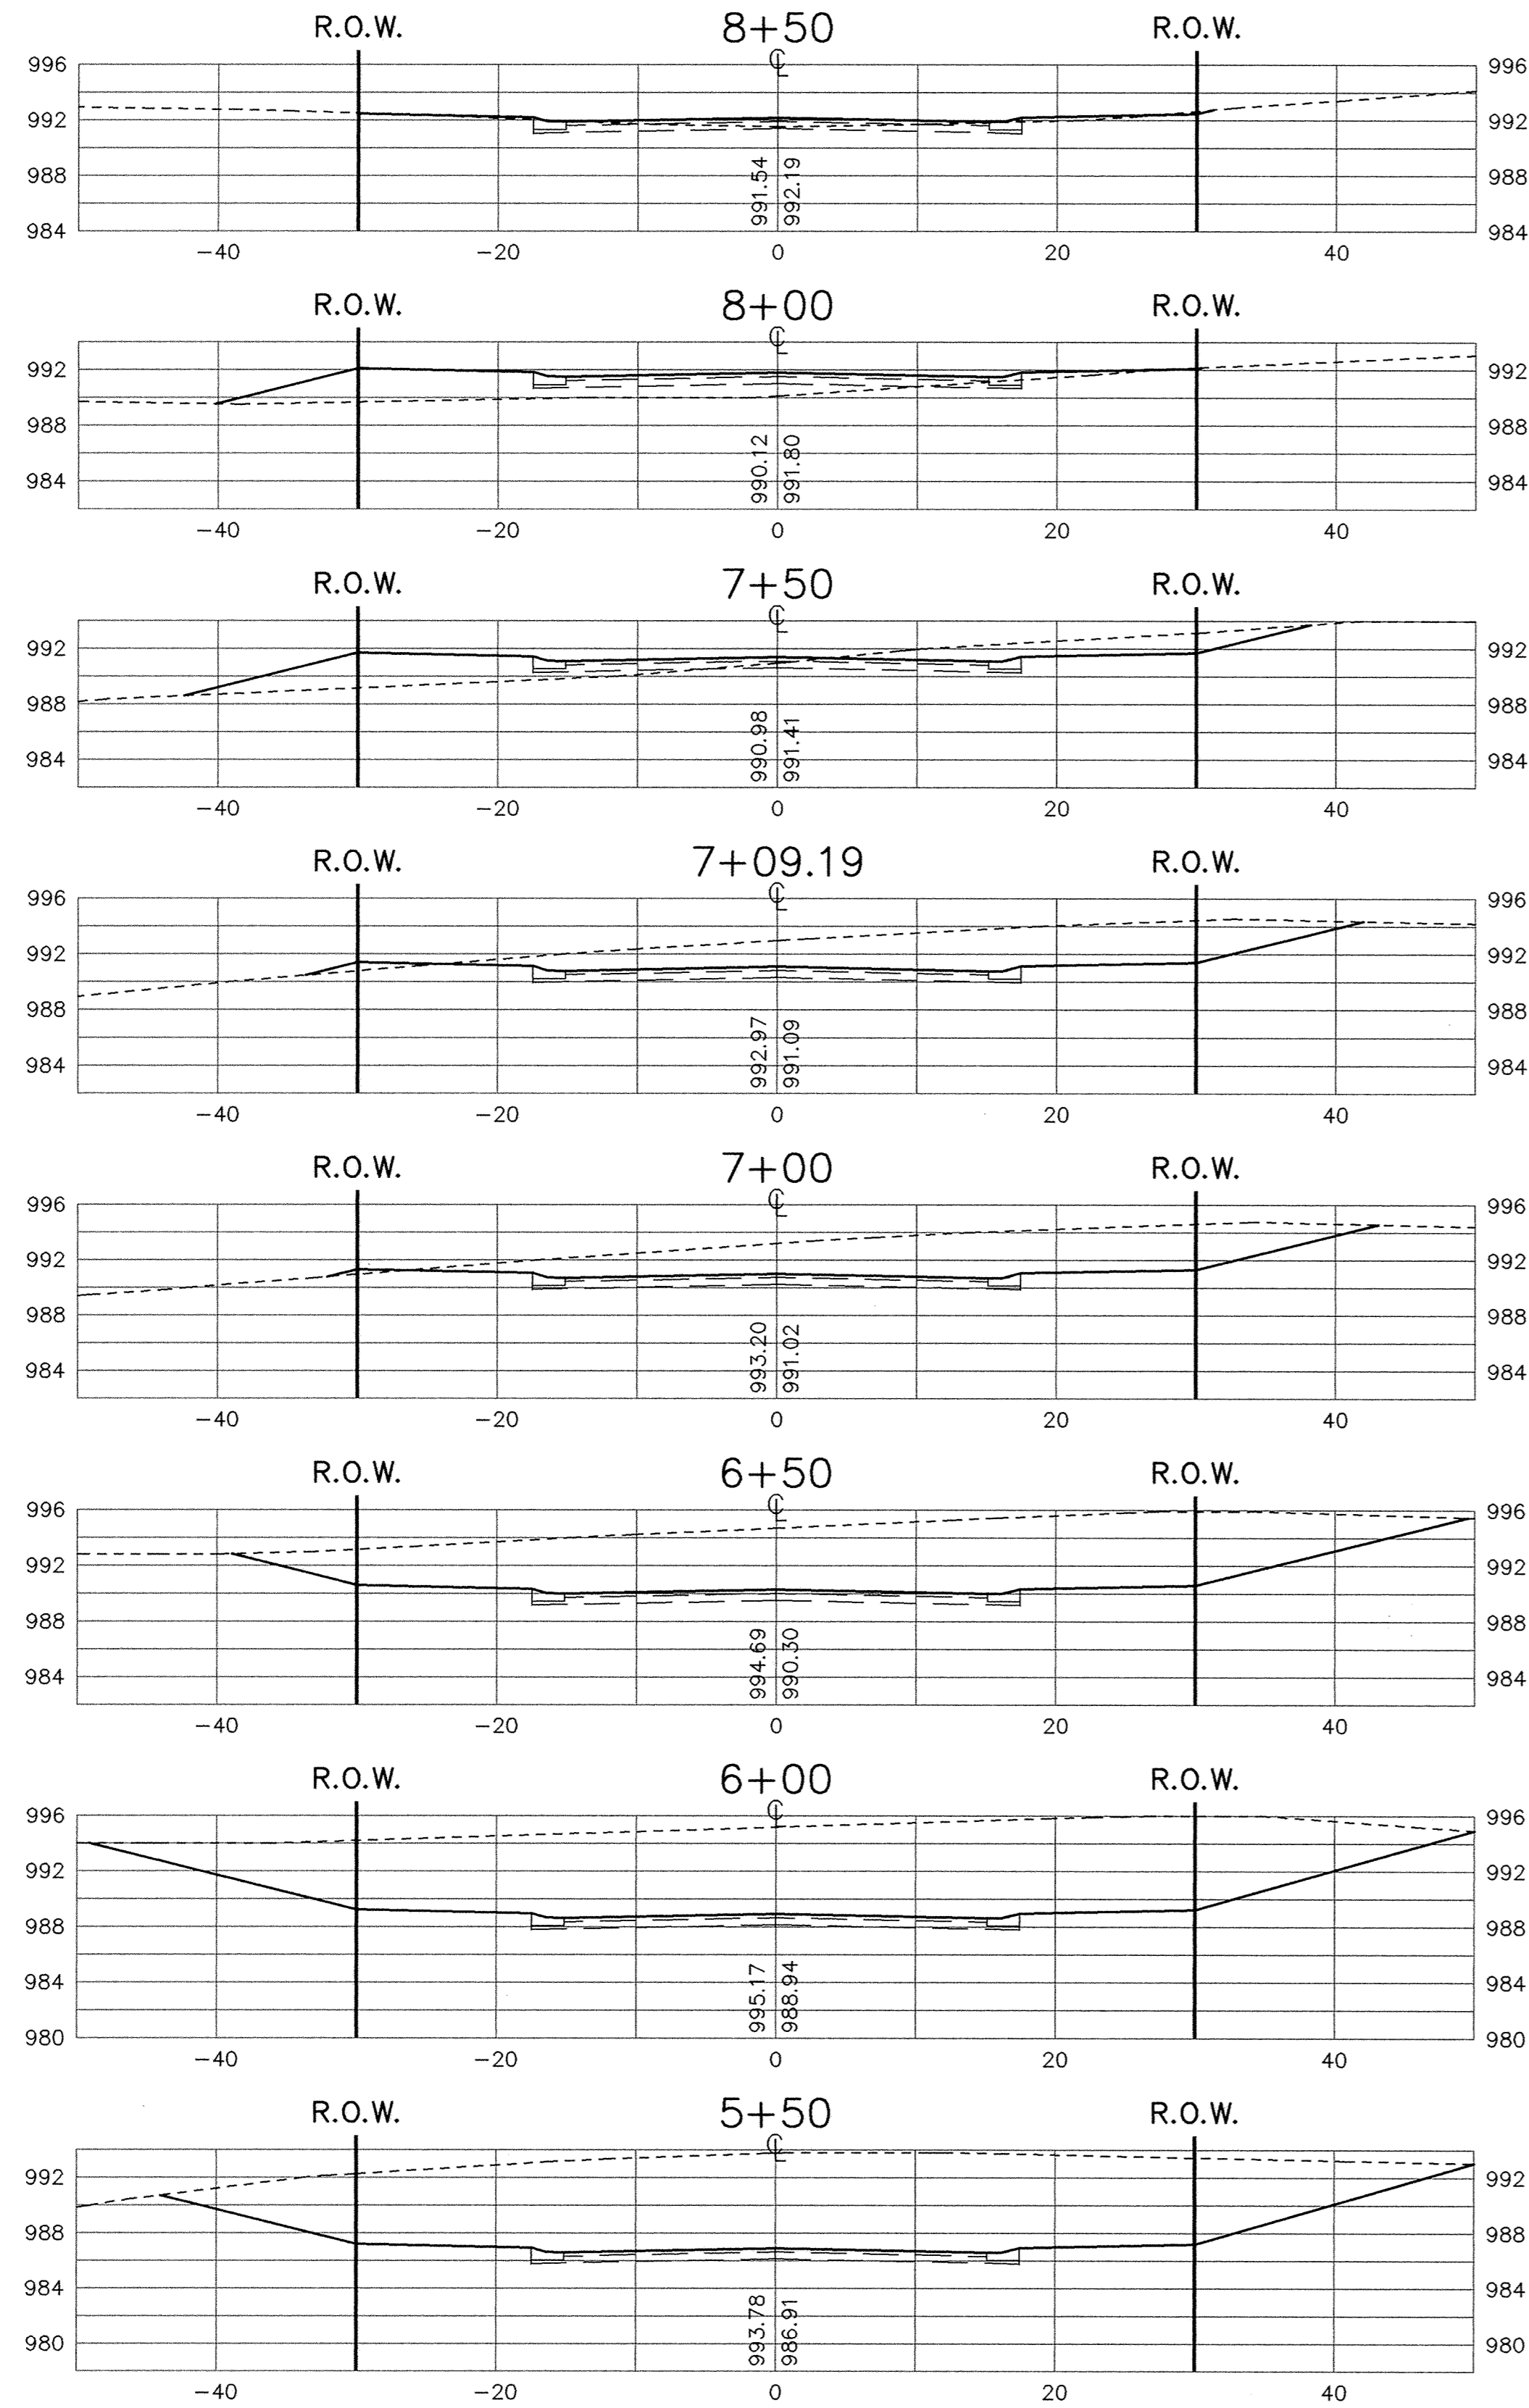

1326 ENERGY PARK DRIVE  
ST. PAUL, MINNESOTA 55108  
(612) 644-4389  
9800 SHELARD PARKWAY  
MINNEAPOLIS, MINNESOTA 55441  
(612) 546-0432

REVISIONS	DATE	DESCRIPTION	DESIGNED	CHECKED	DRAWN

GRAPHIC SCALE  
0 HORIZ. 10  
0 VERT. 5

CITY OF ELK RIVER		STA.
FUTURE STREET		5+50 TO 11+71.08
CROSS SECTIONS		
DATE OCT. 1993	SHEET 9 OF 12 SHEETS	PROJECT NO. 230-190