


RECORD DRAWING  
OCTOBER 1997

I HEREBY CERTIFY THAT THIS PLAN, SPECIFICATION, OR REPORT WAS PREPARED BY ME OR UNDER MY DIRECT SUPERVISION AND THAT I AM A DULY REGISTERED PROFESSIONAL ENGINEER UNDER THE LAWS OF THE STATE OF MINNESOTA.

*Spencer Mauer*  
DATE 10/10/94 REG. NO. 15316

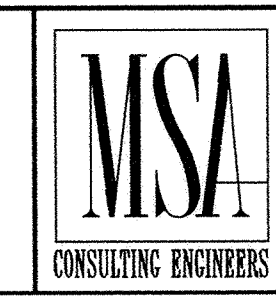

1326 ENERGY PARK DRIVE  
ST. PAUL, MINNESOTA 55108  
(612) 644-4389

9800 SHELARD PARKWAY  
MINNEAPOLIS, MINNESOTA 55441  
(612) 546-0432

| REVISIONS | DATE | DESCRIPTION | DESIGNED _____ | CHECKED _____ | DRAWN _____ |
|-----------|------|-------------|----------------|---------------|-------------|
|           |      |             |                |               |             |
|           |      |             |                |               |             |
|           |      |             |                |               |             |

GRAPHIC SCALE  
0 10  
0 VERT. 5

CITY OF ELK RIVER  
193RD AVENUE  
CROSS SECTIONS

16+50 TO 17+25

DATE SEPT 1994 SHEET 8 OF 15 SHEETS PROJECT NO. 230-227