

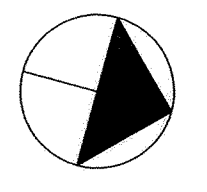


# AUBURN STREET

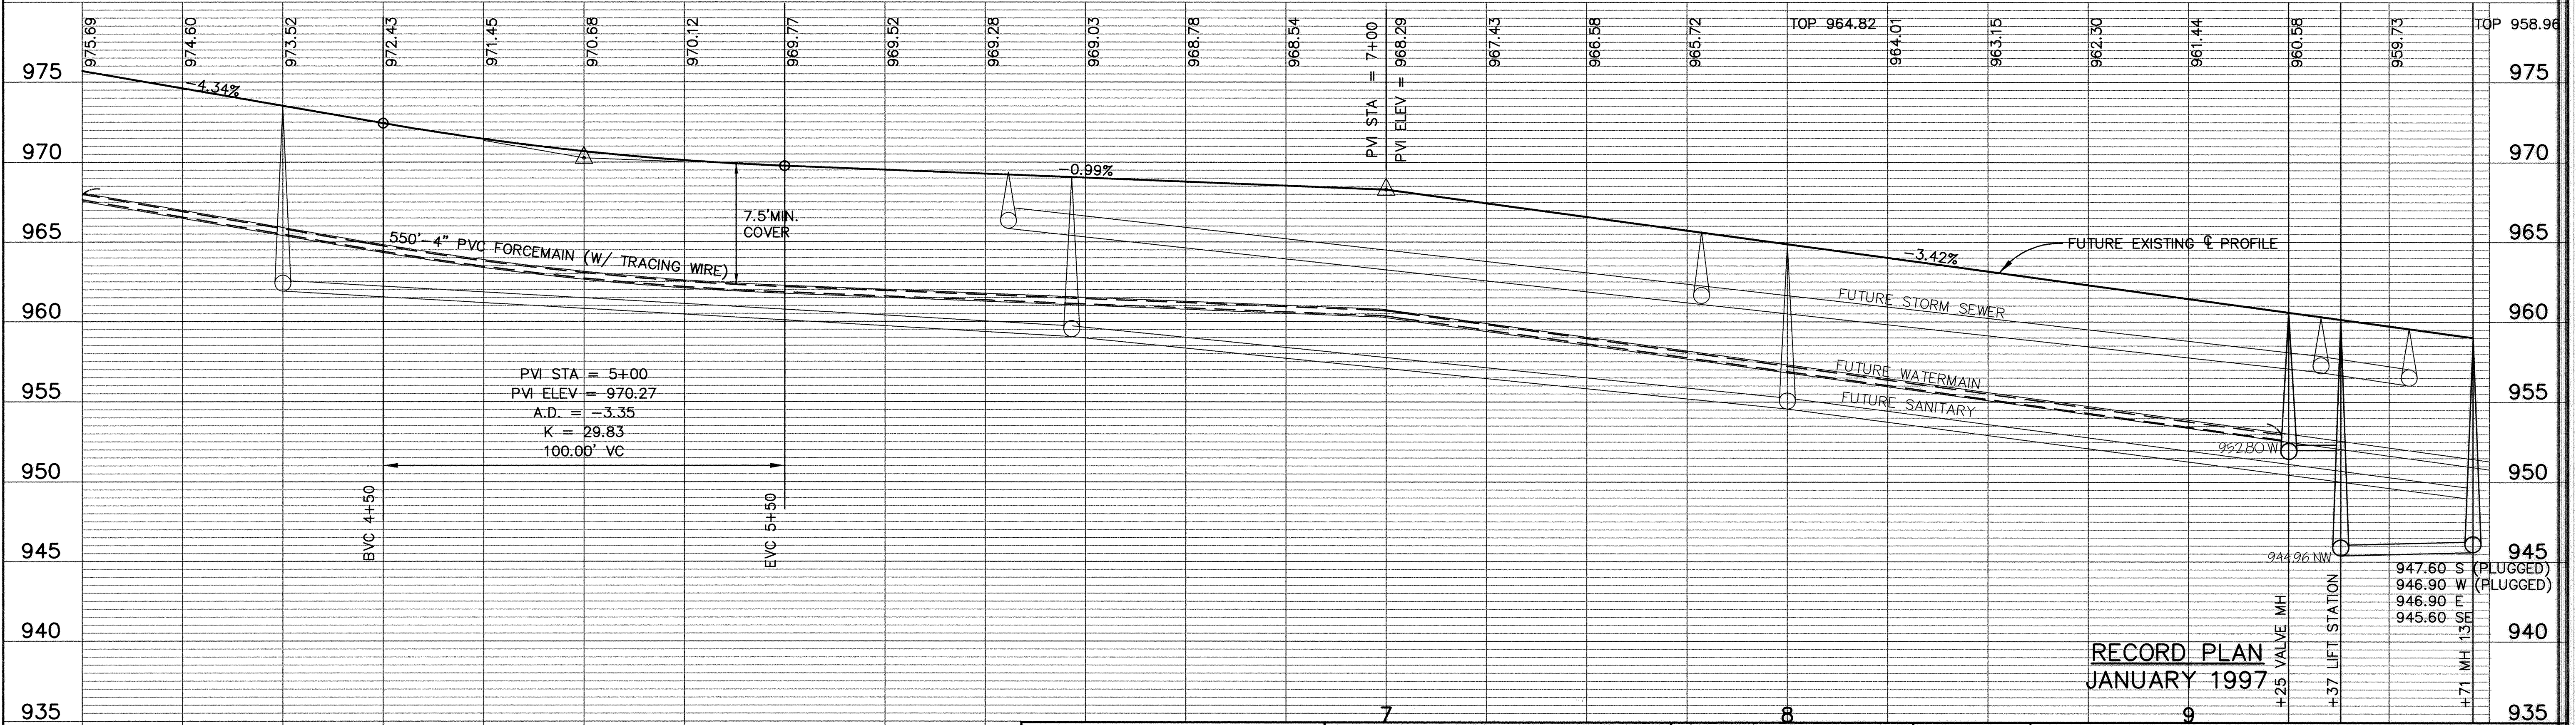


$\Delta = 13^\circ 32' 45''$   
 $R = 200.00'$   
 $T = 23.75'$   
 $L = 47.28'$

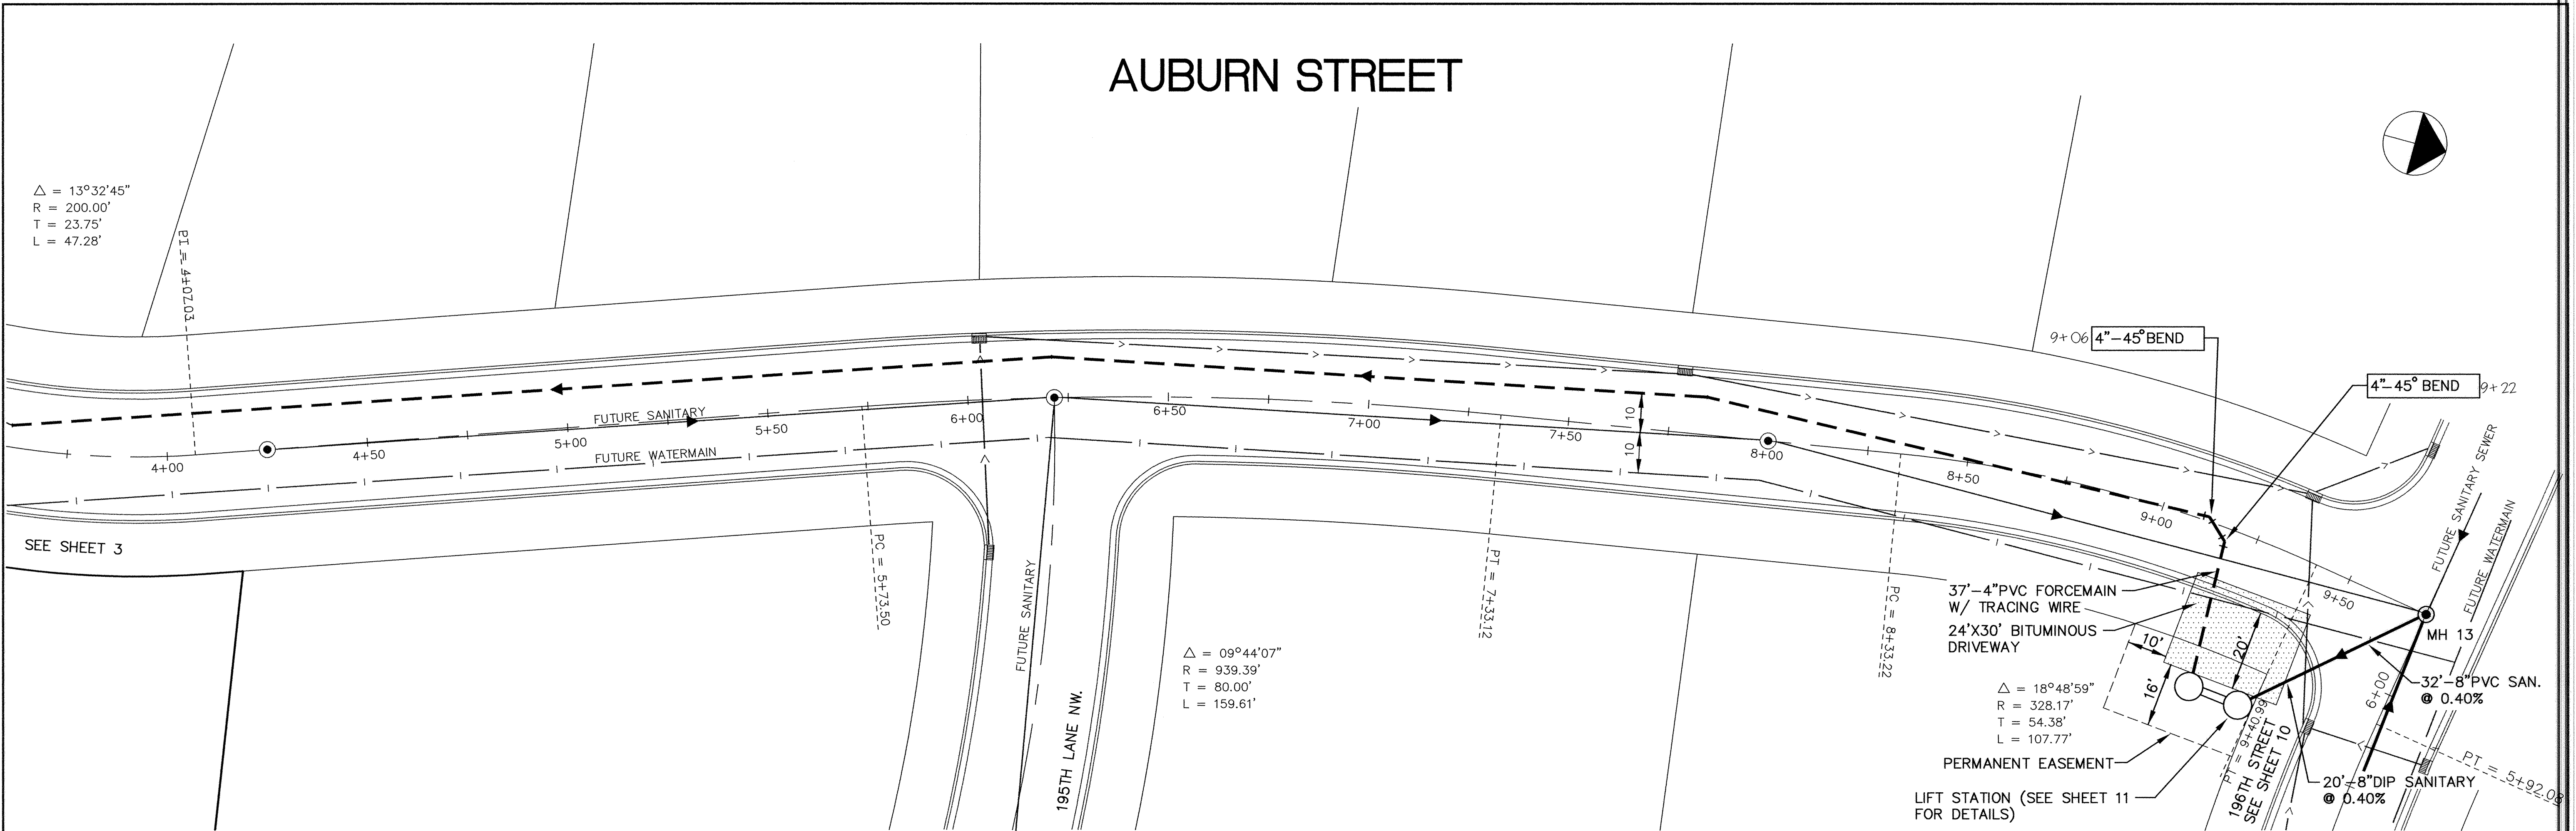

I HEREBY CERTIFY THAT THIS PLAN, SPECIFICATION, OR REPORT WAS PREPARED BY ME OR UNDER MY DIRECT SUPERVISION AND THAT I AM A DULY REGISTERED PROFESSIONAL ENGINEER UNDER THE LAWS OF THE STATE OF MINNESOTA.

*Sergey Mamonov*  
DATE 8/21/96 REG. NO. 15516

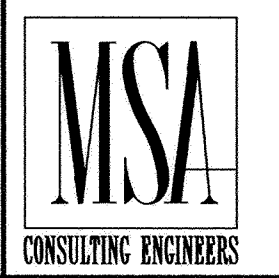

1326 ENERGY PARK DRIVE  
ST. PAUL, MINNESOTA 55108  
(612) 644-4389

REVISIONS	DATE	DESCRIPTION	DESIGNED	SEF.
0	9/11/96	REVISE SANITARY SEWER	CHECKED	
0			DRAWN	RKM

GRAPHIC SCALE  
0 20  
0 5  
VERT.

**RECORD PLAN**  
**JANUARY 1997**

CITY OF ELK RIVER  
SANITARY SEWER, WATERMAIN, STREET & STORM SEWER  
AUBURN STREET

3+75 TO 9+70.95

DATE JULY 1996 SHEET 4 OF 16 SHEETS PROJECT NO. 230-292