
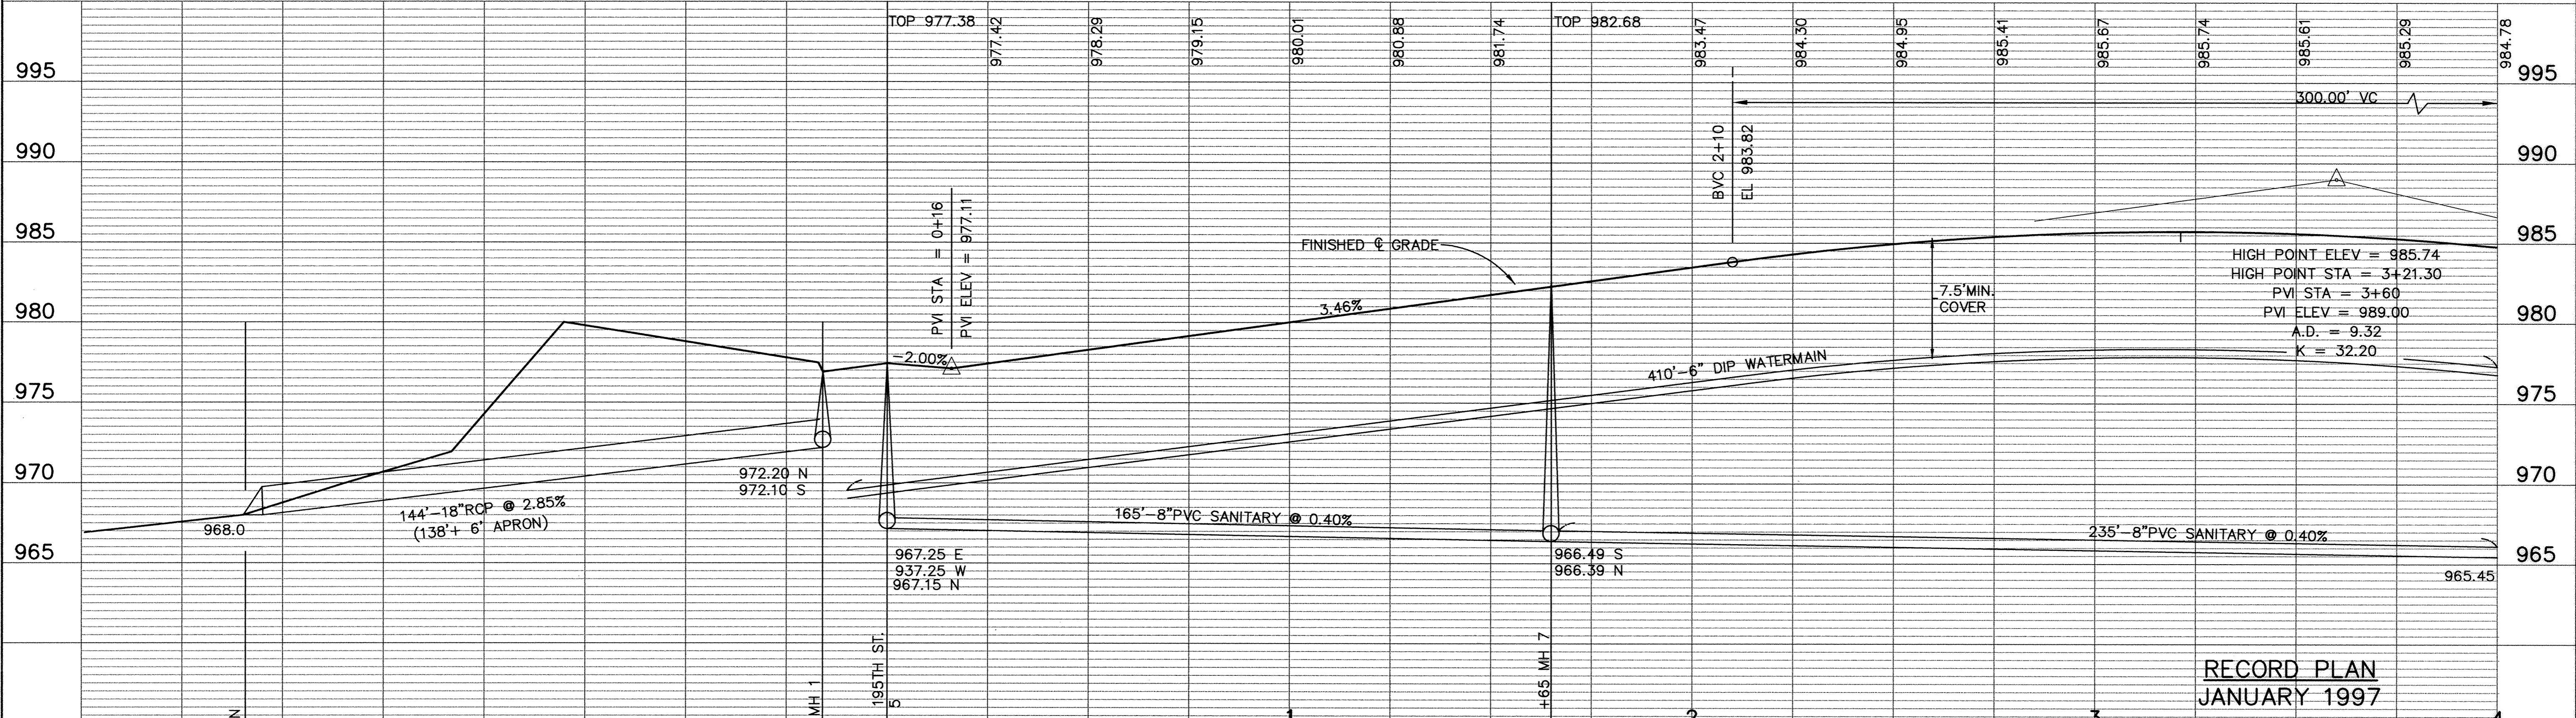


# ZANE STREET

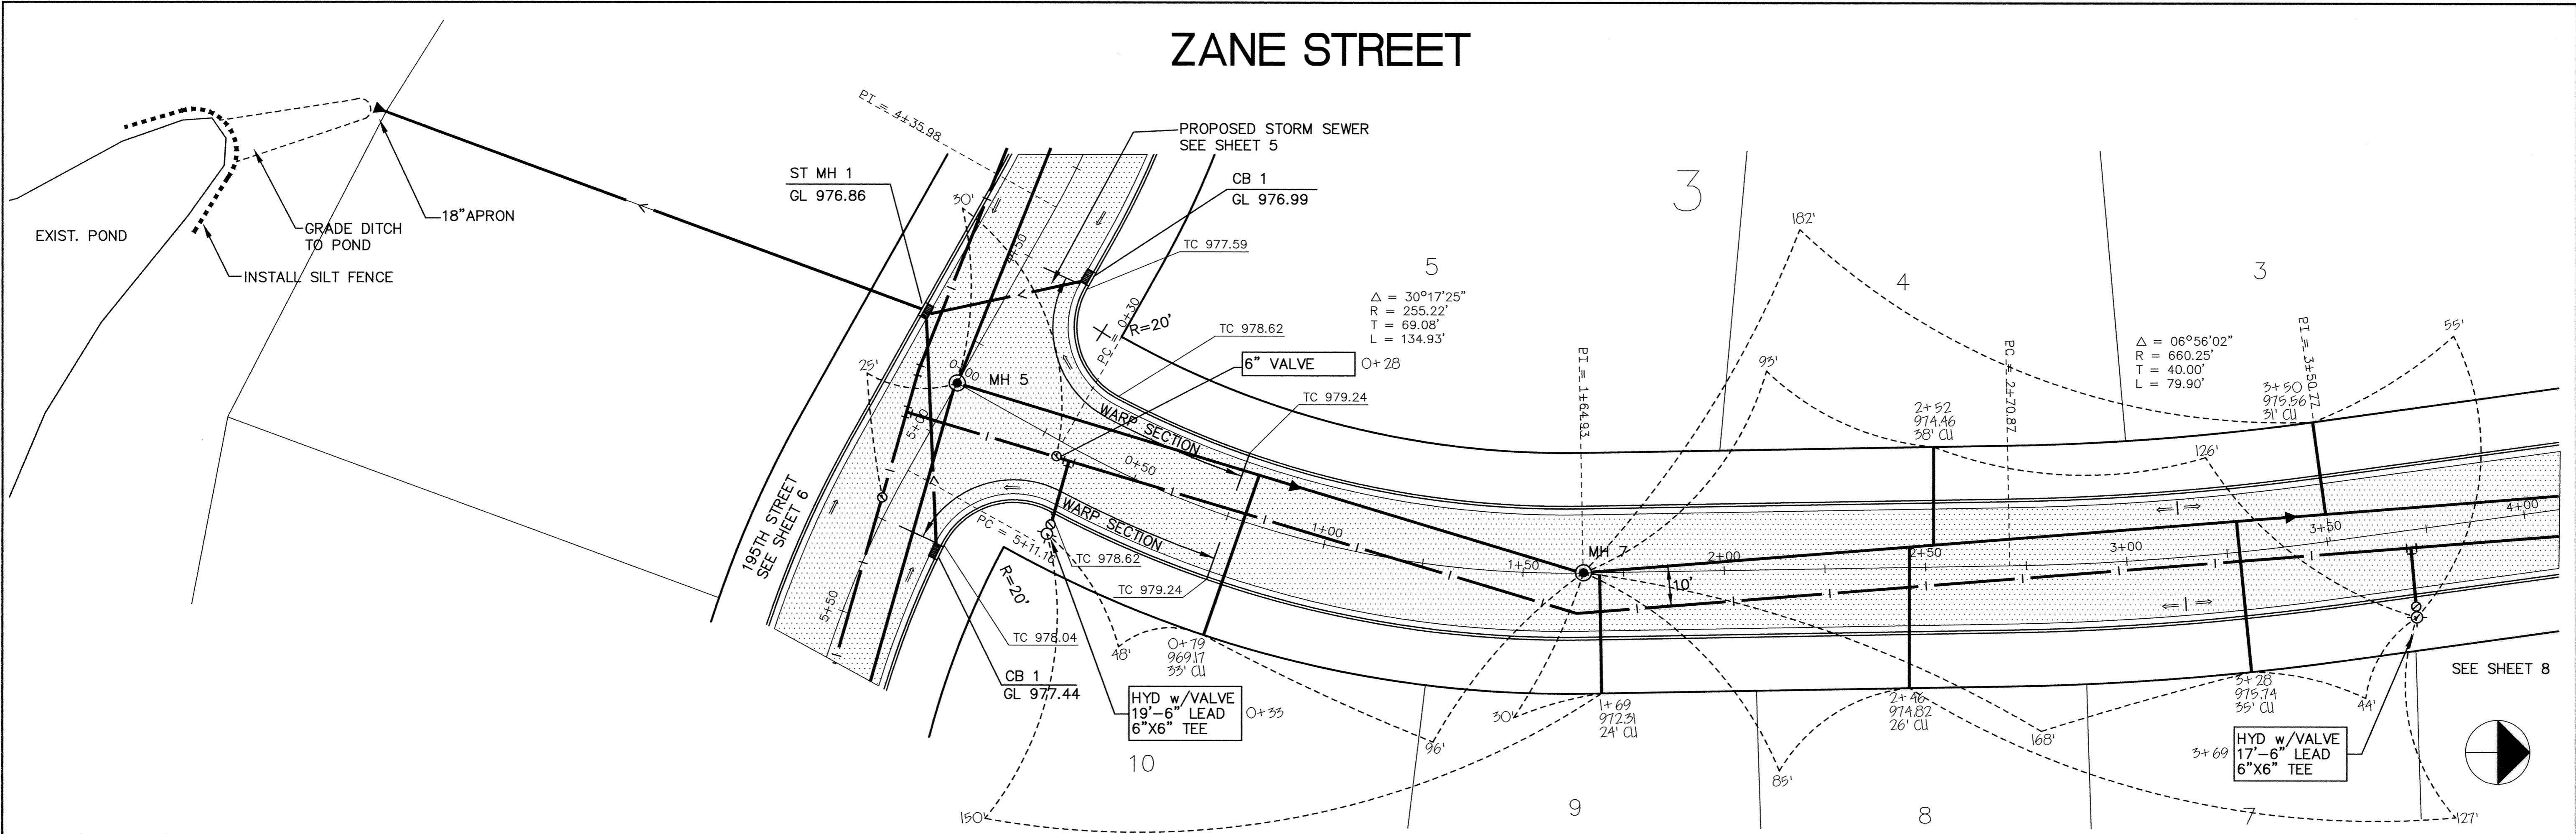

RECORD PLAN  
JANUARY 1997

I HEREBY CERTIFY THAT THIS PLAN, SPECIFICATION, OR REPORT WAS PREPARED BY ME OR UNDER MY DIRECT SUPERVISION AND THAT I AM A DULY REGISTERED PROFESSIONAL ENGINEER UNDER THE LAWS OF THE STATE OF MINNESOTA.

DATE 8/21/96 REG. NO. 15316



1326 ENERGY PARK DRIVE  
ST. PAUL, MINNESOTA 55108  
(612) 644-4389

REVISIONS	DATE	DESCRIPTION	DESIGNED	SEF

CITY OF ELK RIVER SANITARY SEWER, WATERMAIN, STREET & STORM SEWER ZANE STREET		0+00 TO 4+00	
DATE	JULY 1996	SHEET	7 OF 16 SHEETS
PROJECT NO.	230-292		

1068

DRAWING NUMBER

DRAWING NUMBER

DRAWING NUMBER

DRAWING NUMBER  
HILLSES:96  
7

C:\CADD\ElkRiver\ER292\ER292-3.dwg Wed Oct 29 13:58:36 1997