


RECORD PLAN
JANUARY 1997

I HEREBY CERTIFY THAT THIS PLAN, SPECIFICATION, OR REPORT WAS PREPARED BY ME OR UNDER MY DIRECT SUPERVISION AND THAT I AM A DULY REGISTERED PROFESSIONAL ENGINEER UNDER THE LAWS OF THE STATE OF MINNESOTA.

[Signature]

DATE 8/21/96 REG. NO. 15316

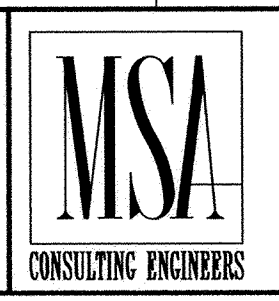

1326 ENERGY PARK DRIVE
ST. PAUL, MINNESOTA 55108
(612) 644-4389

DATE	DESCRIPTION	DESIGNED	SEF
9/13/96	REVISE SANITARY SEWER	CHECKED	
		DRAWN	RKM
		GRAPHIC SCALE	0 20
		VERT.	5

CITY OF ELK RIVER
SANITARY SEWER, WATERMAIN, STREET & STORM SEWER
196TH STREET

DATE JULY 1996 SHEET 10 OF 16 SHEETS PROJECT NO. 230-292