
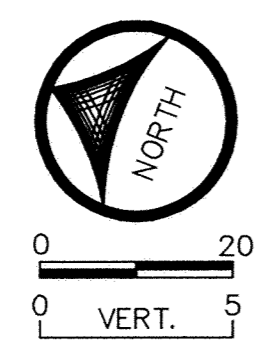


AUBURN CIRCLE

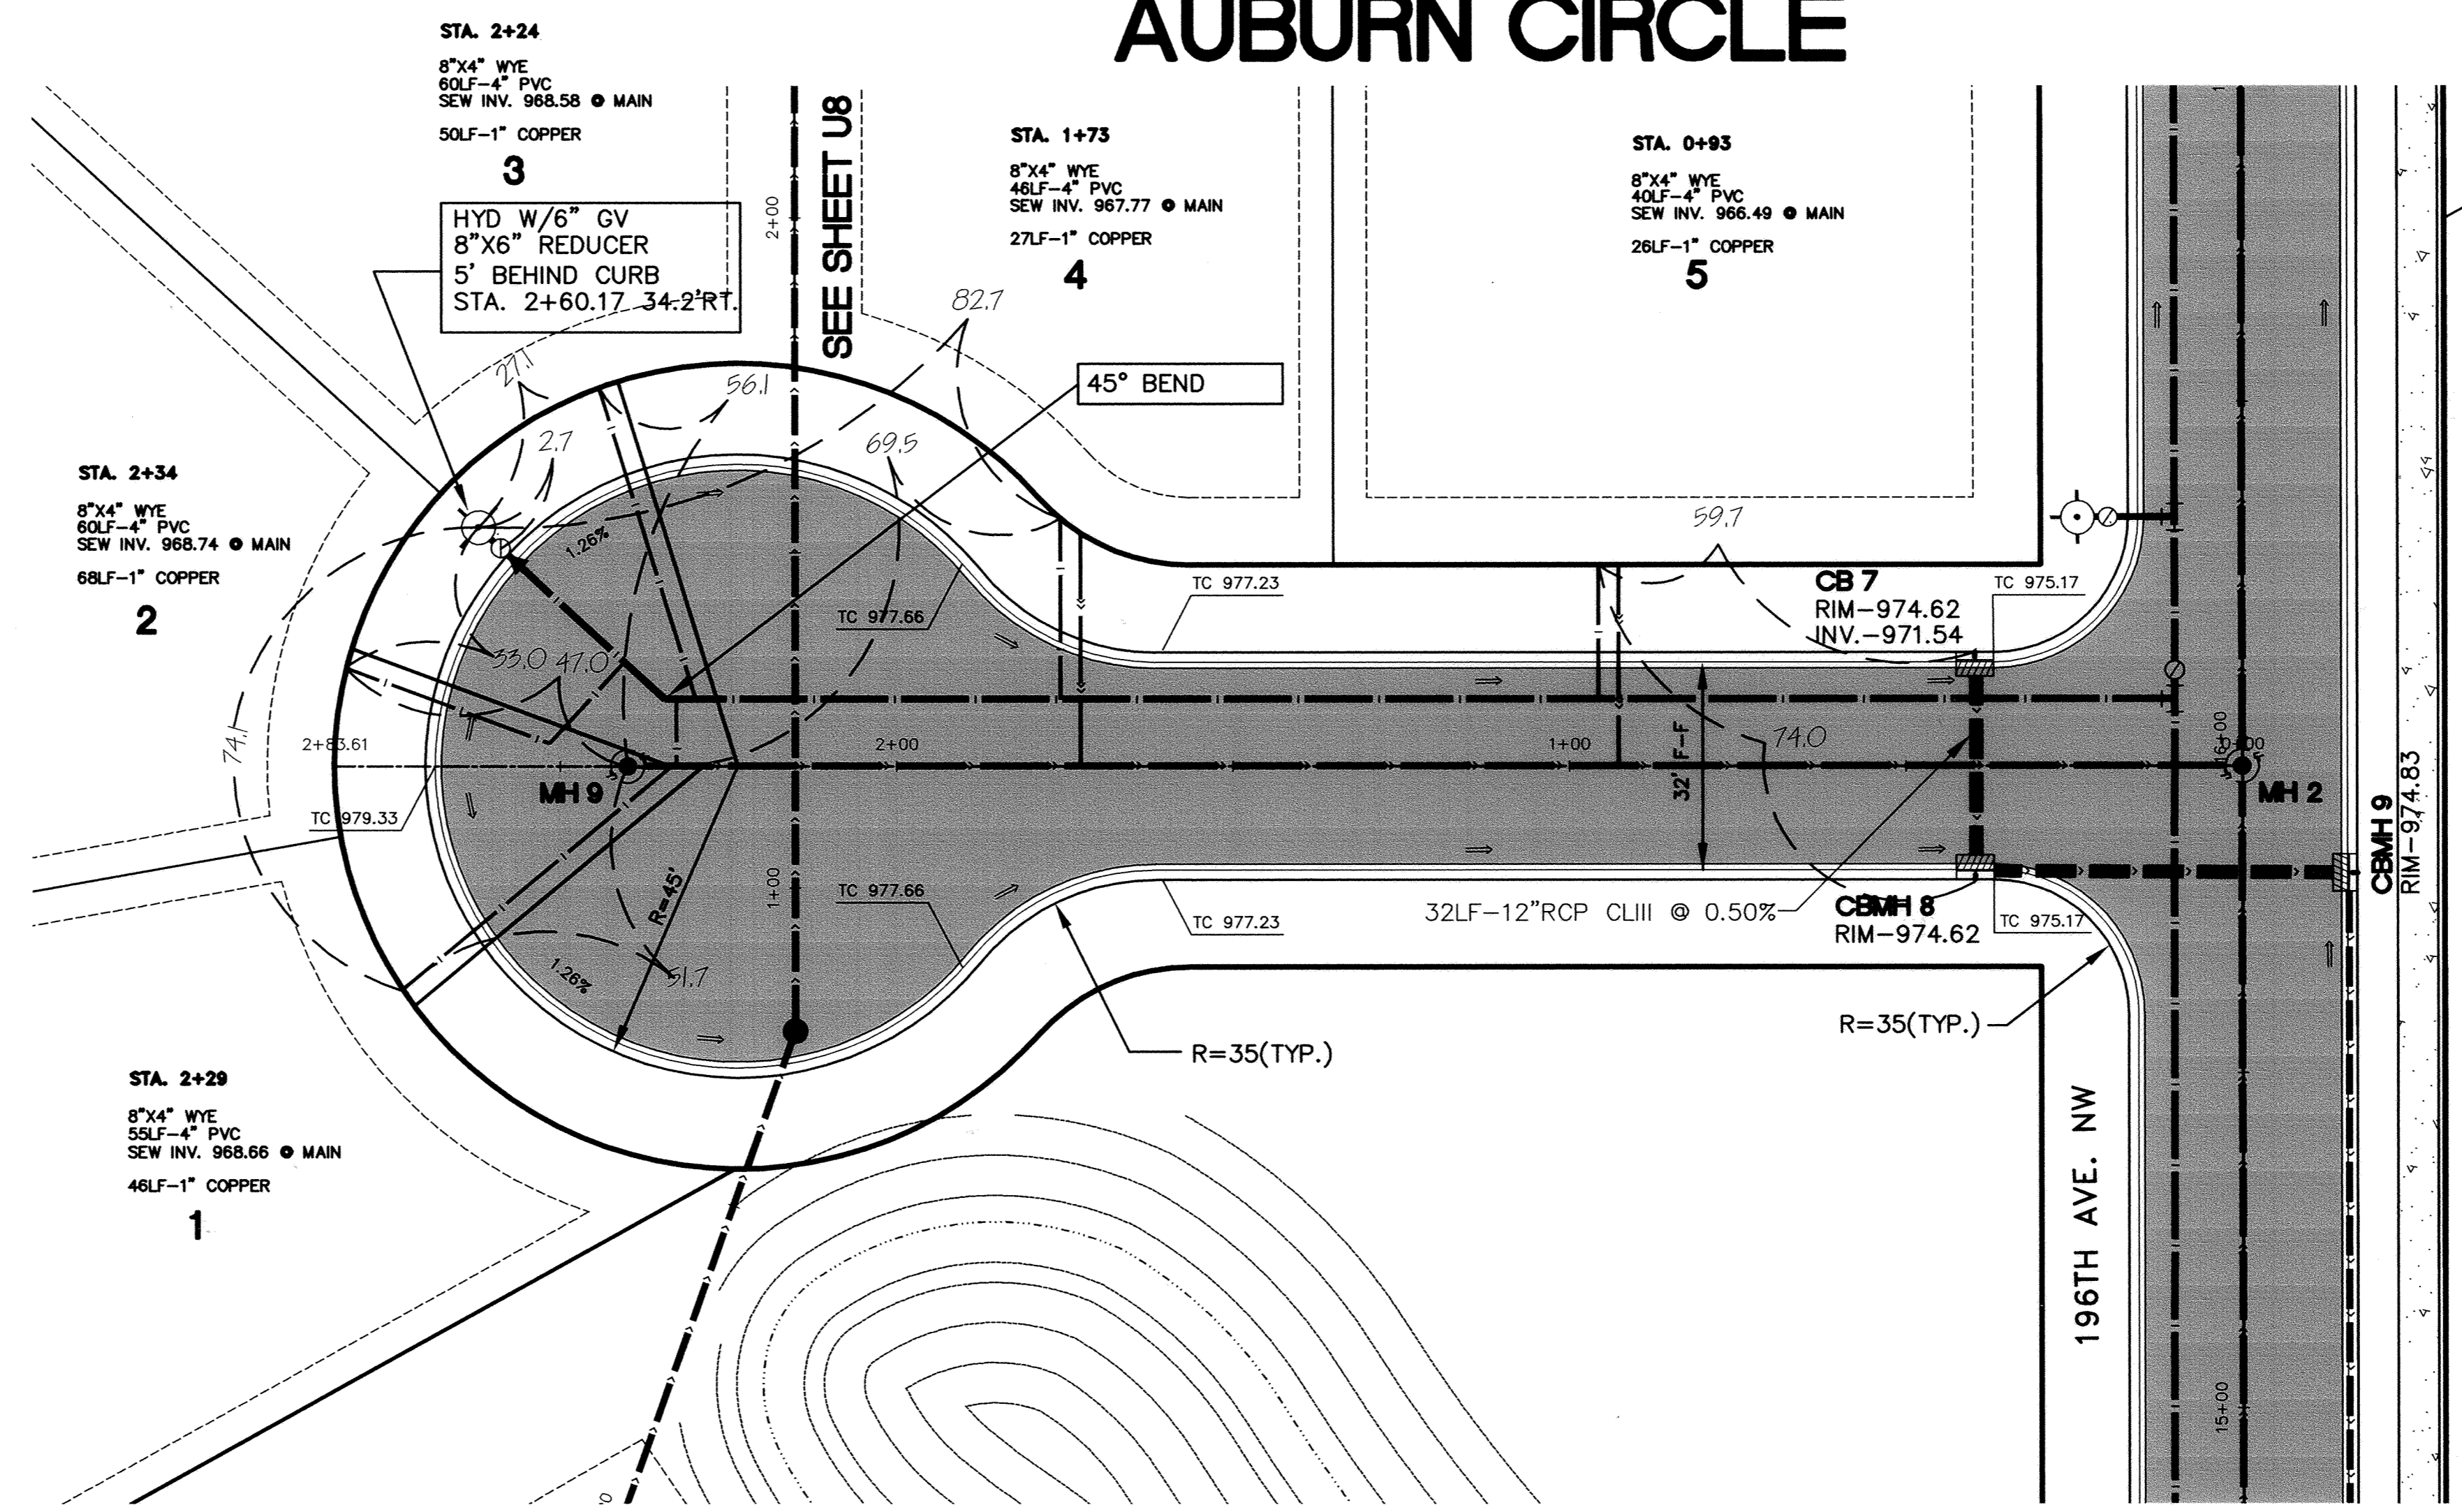


SEE SHEET U4

RECORD DRAWING - JANUARY 2004

SANITARY SEWER, WATERMAIN, STORM SEWER AND STREET CONSTRUCTION HILLSIDE ESTATES 9TH ADDITION 196TH LANE NW STA. 0+00 TO 5+00 CITY OF ELK RIVER, MINNESOTA

RIVERSIDE COMPANES
19230 EVANS STREET, SUITE 115
ELK RIVER, MINNESOTA
PHONE: 763-241-1801

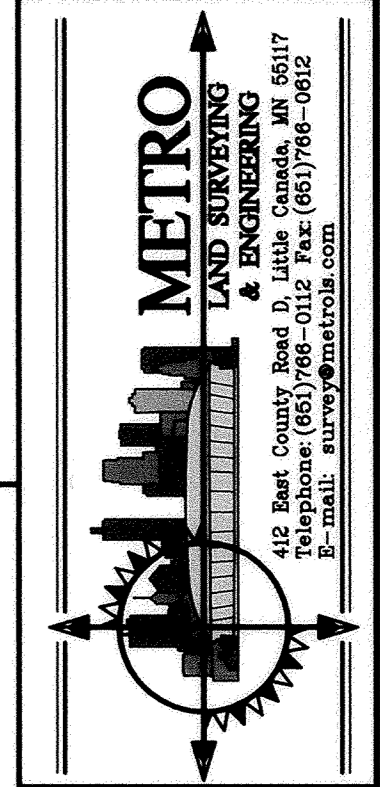

I HEREBY CERTIFY THAT THIS PLAN, SPECIFICATION OR REPORT WAS PREPARED BY ME OR UNDER MY SUPERVISION AND THAT I AM A DULY LICENSED PROFESSIONAL ENGINEER UNDER THE LAWS OF THE STATE OF MINNESOTA.

John E. Johnson
JOHN E. JOHNSON
DATE: 5/21/05 LICENSE NO. 17546

DATE	REVISIONS	BY
6/25/03	PER CITY REVIEW	PK

U9

