
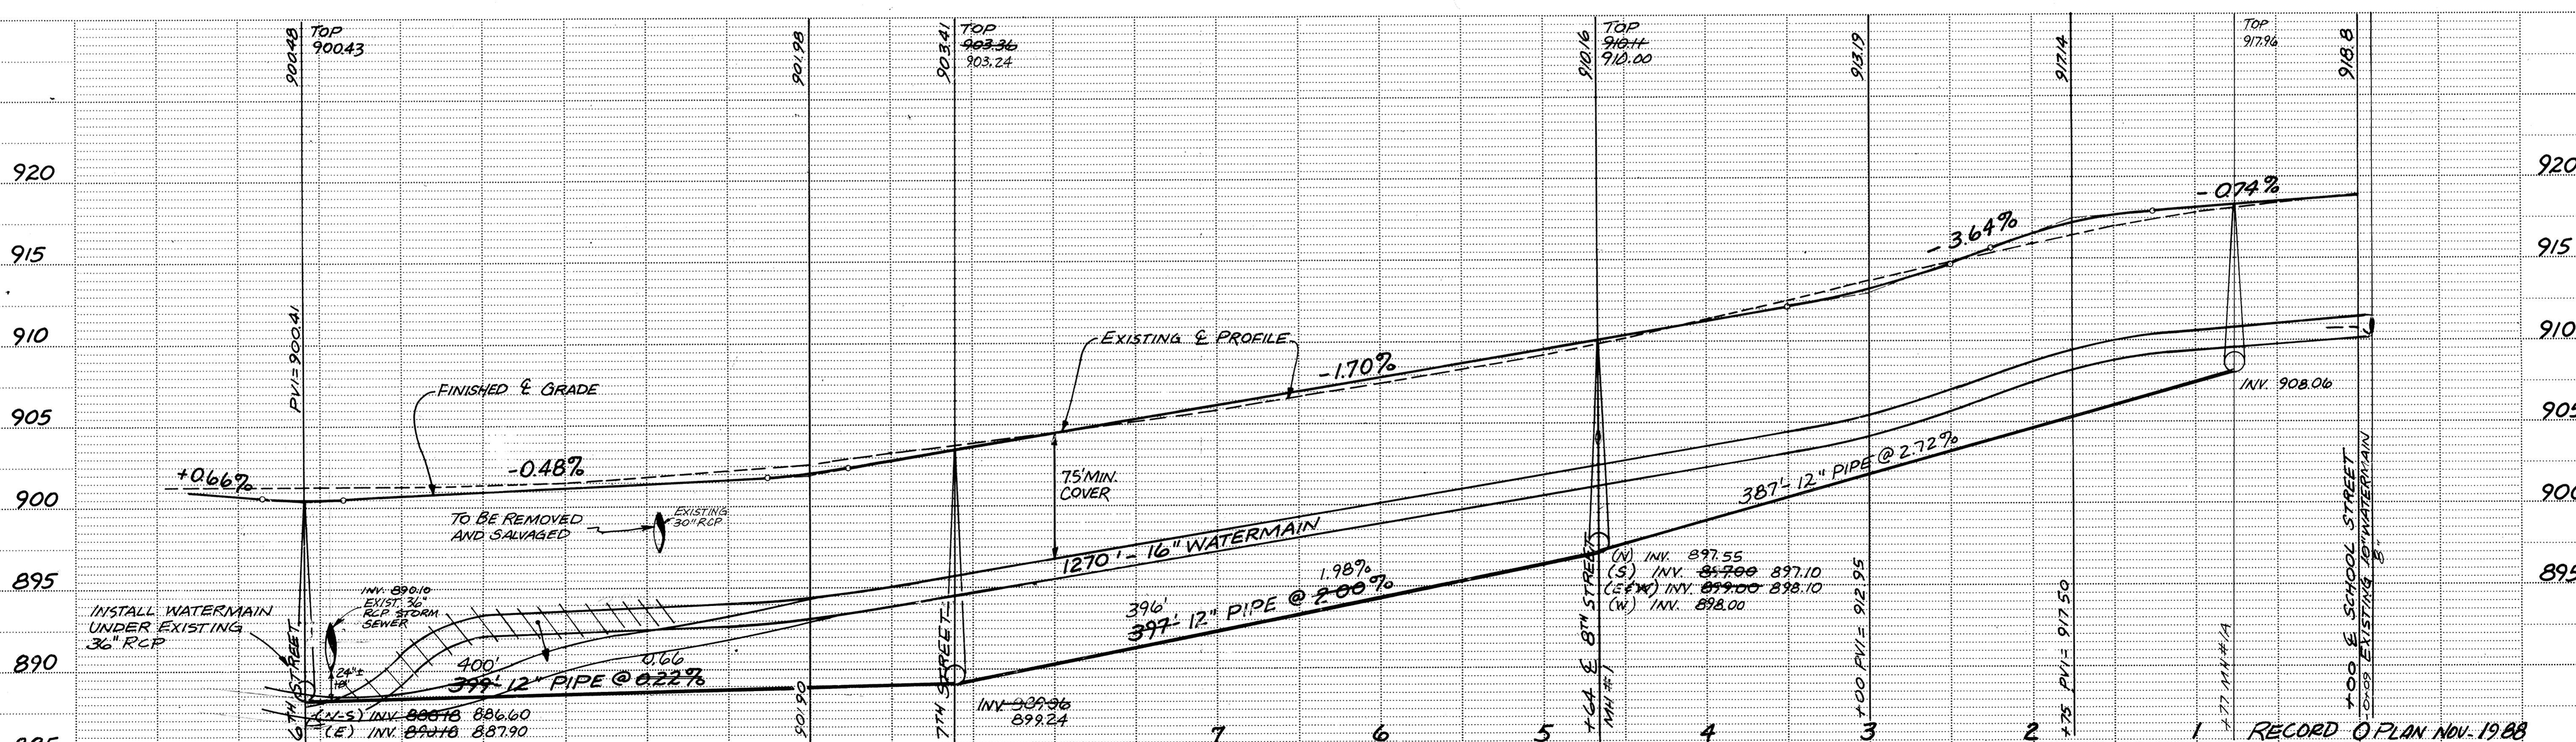



JACKSON AVENUE

MORREL TRUCKING

NOTE: INSTALL SANITARY SEWER AND WATER SERVICES TO WEST R.O.W. AS DIRECTED BY ENGINEER.

EXISTING 4" WATERMAIN TO BE ABANDON. EXTEND EXISTING WATER SERVICES TO NEW 16" WATERMAIN.

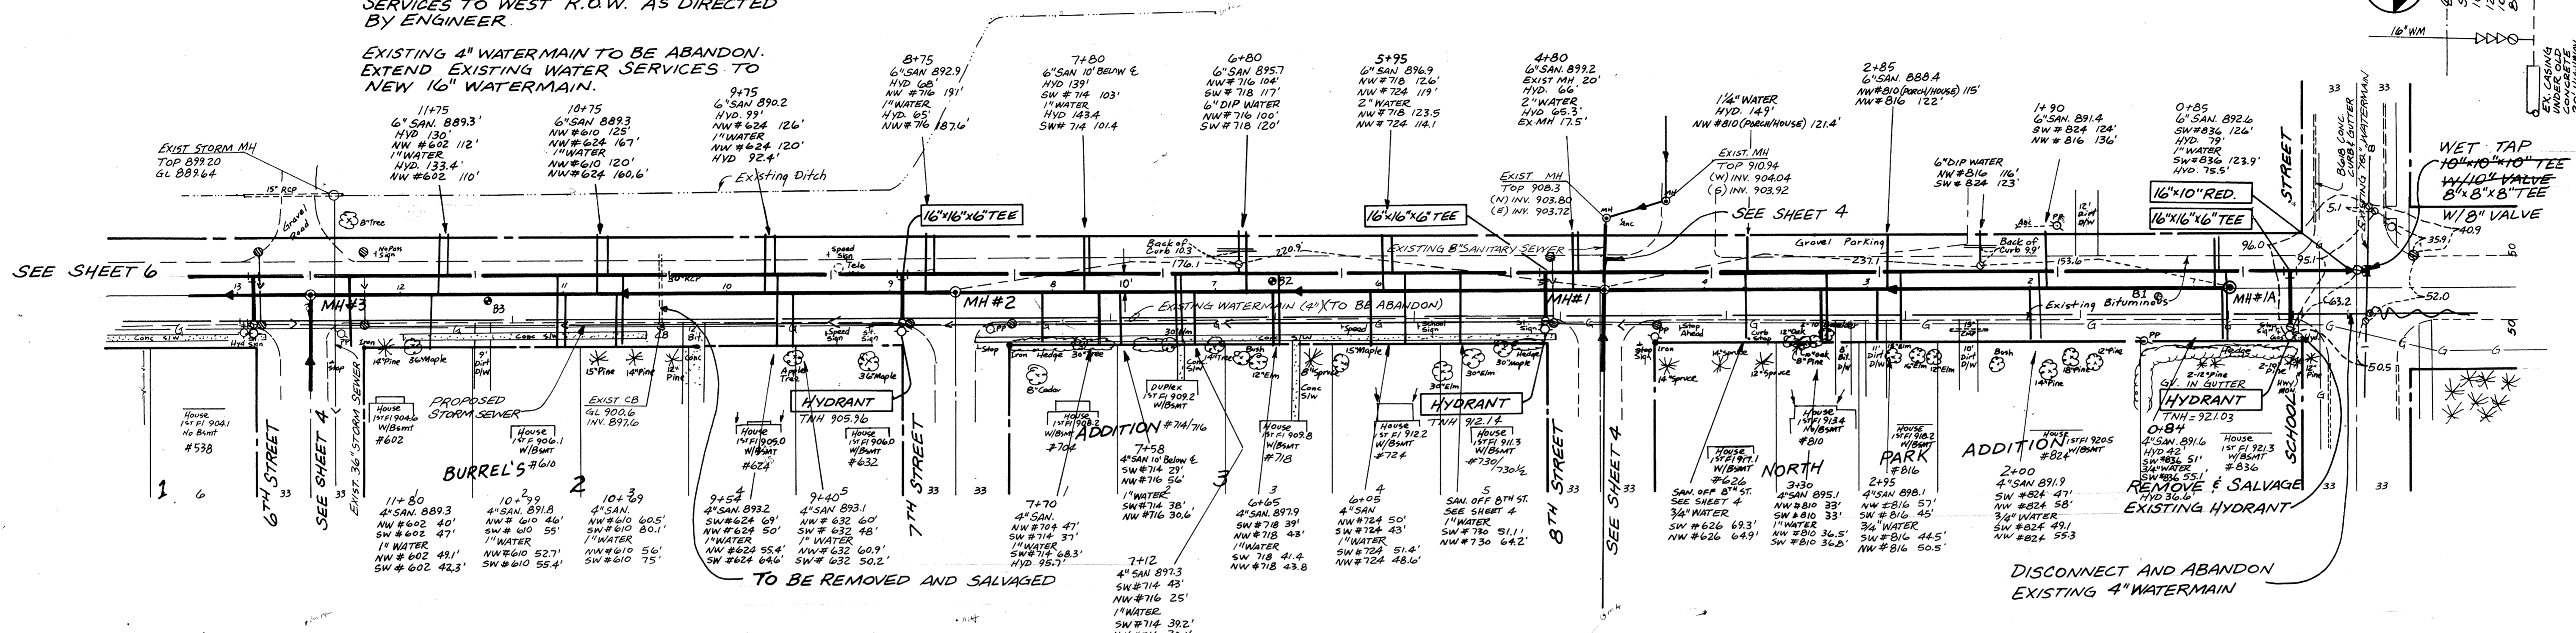



Maier Stewart & Associates Inc.
CONSULTING ENGINEERS
480 CEDAR STREET (612)227-9475 ST. PAUL, MINNESOTA 55101

DATE	DESCRIPTION	DESIGNED

CITY OF ELK RIVER
SANITARY SEWER AND WATERMAIN
JACKSON AVENUE
DATE MAY 1987 SHEET 5 OF 28 SHEETS PROJECT NO. 230-032

DRAWING NUMBER JACKS. 87

DRAWING NUMBER 5

DRAWING NUMBER 221