

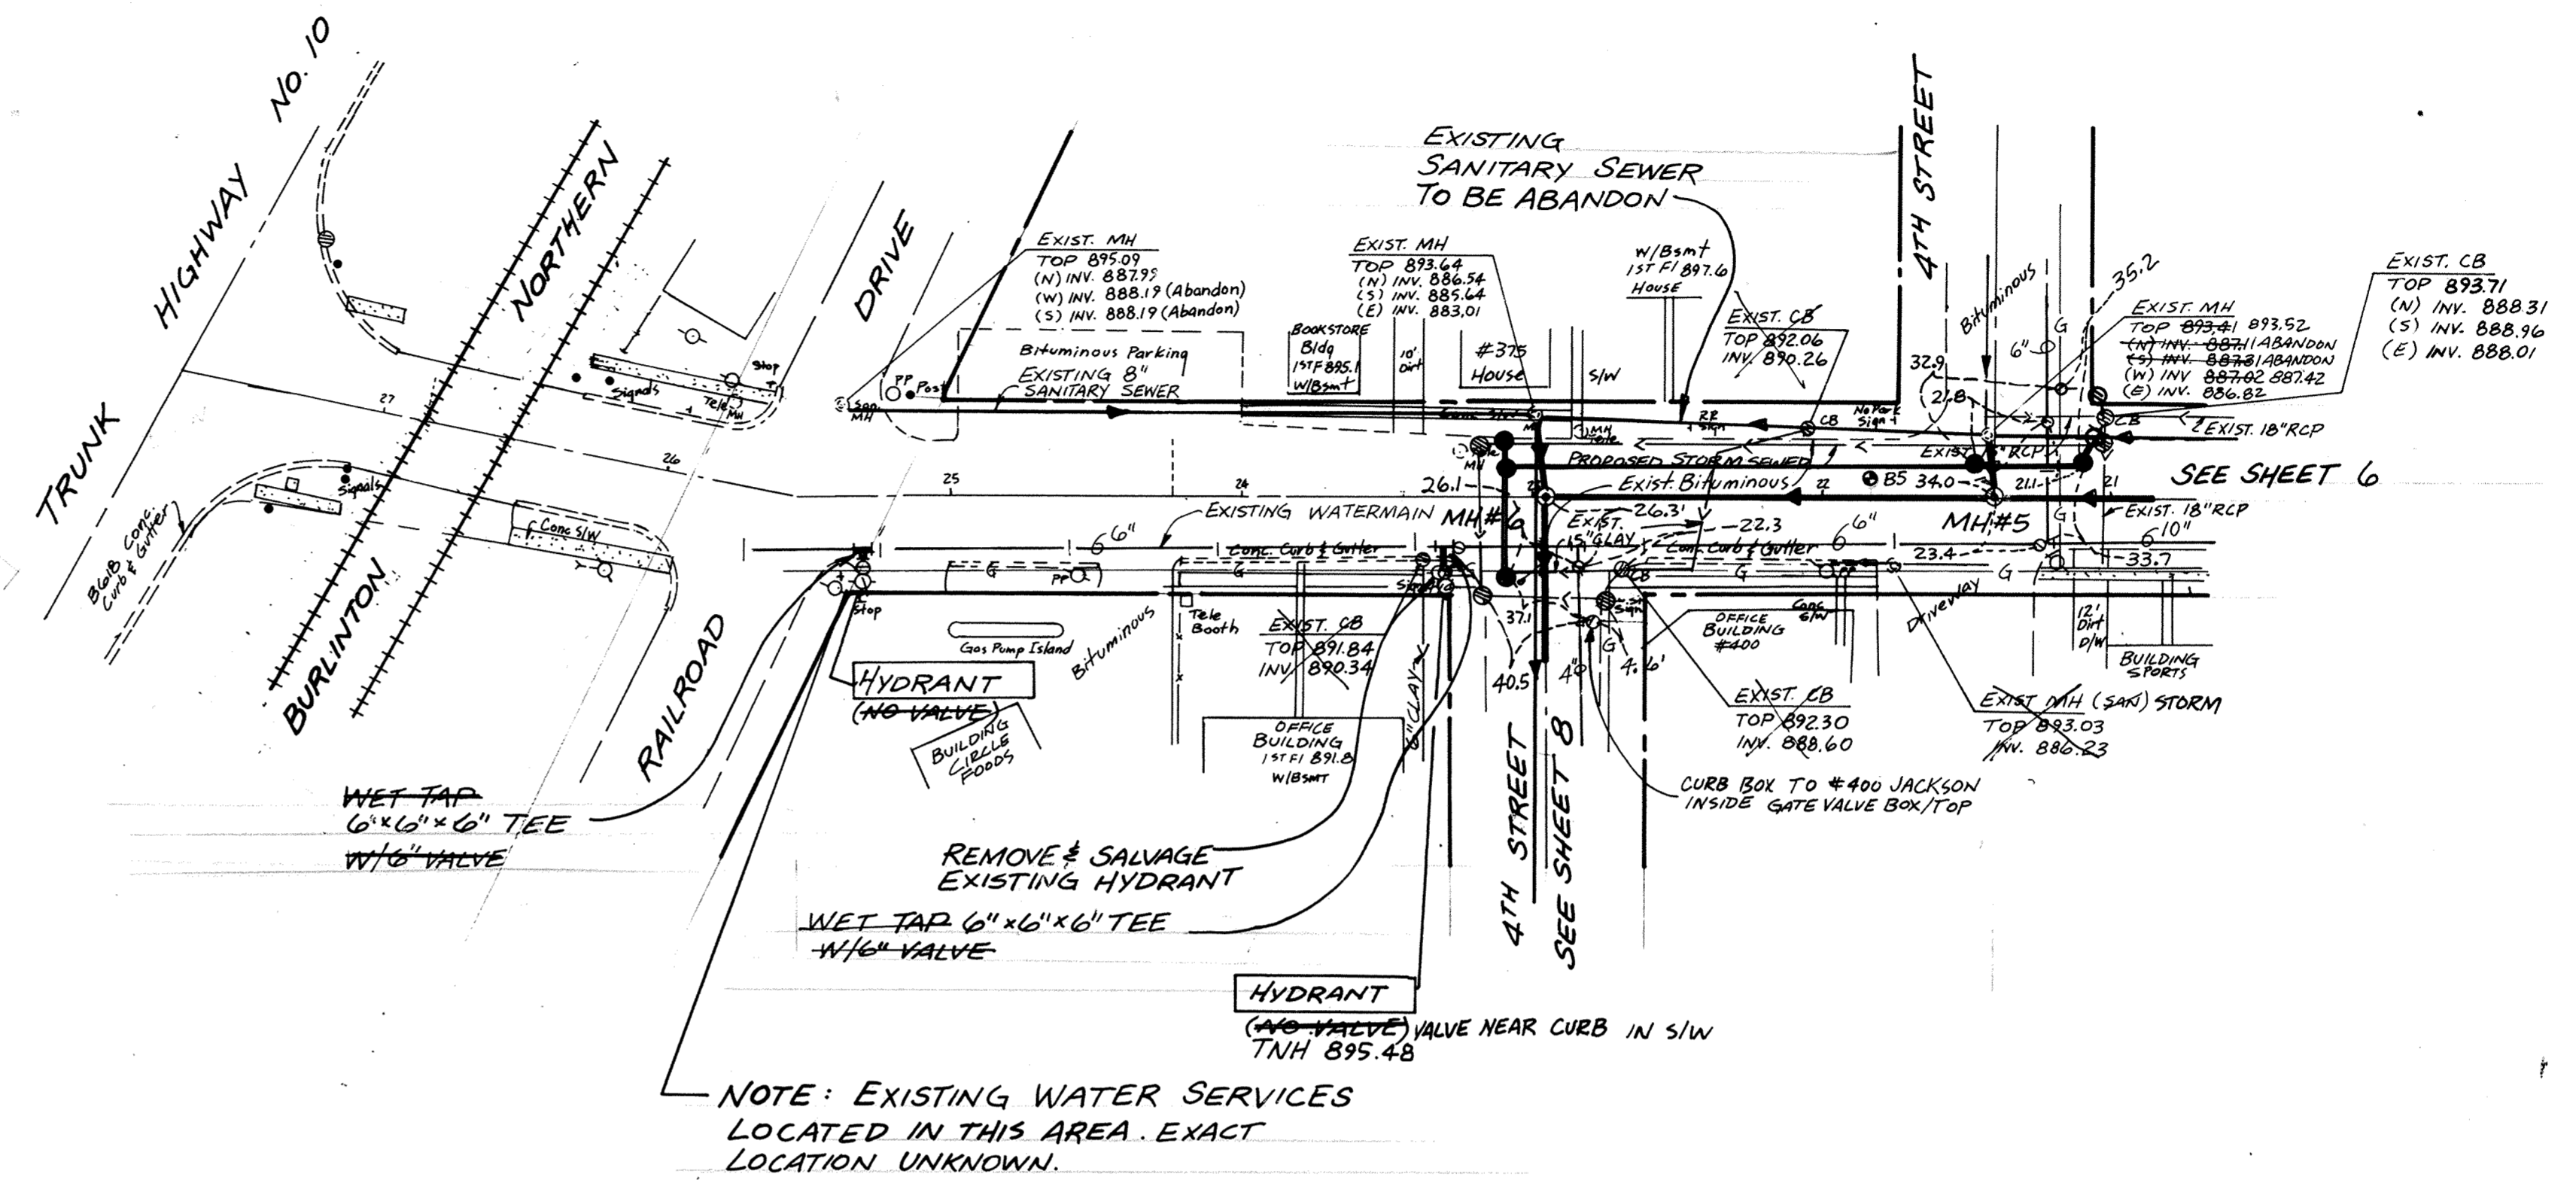


JACKSON AVENUE

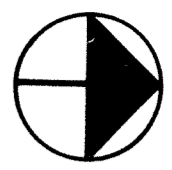

NOTE: EXISTING WATER SERVICES LOCATED IN THIS AREA. EXACT LOCATION UNKNOWN.

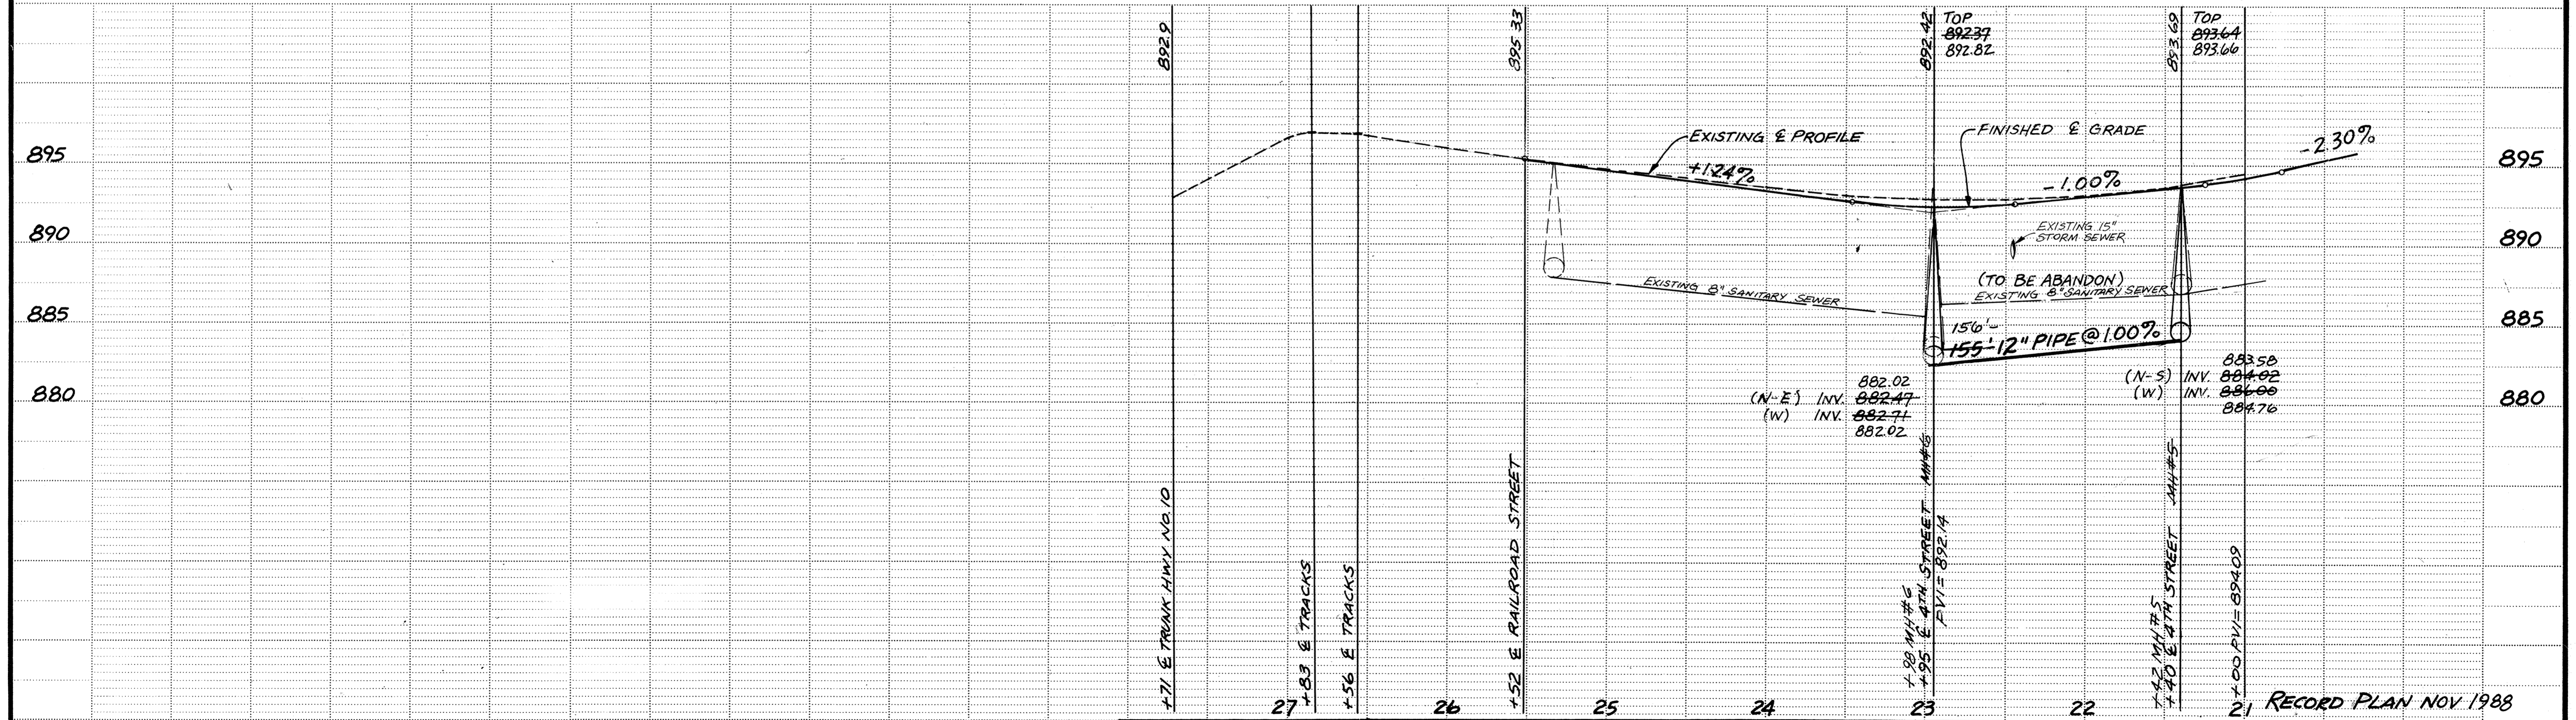

<p>Maier Stewart & Associates Inc. CONSULTING ENGINEERS 480 CEDAR STREET (612)227-9475 ST. PAUL, MINNESOTA 55101</p>	DATE _____ DESCRIPTION _____ DESIGNED _____ CHECKED _____ DRAWN <i>MRJ</i> GRAPHIC SCALE 0' HORIZ. 50' 0' VERT. 3'	CITY OF ELK RIVER SANITARY SEWER AND WATERMAIN JACKSON AVENUE DATE <u>MAY 1987</u> SHEET <u>7</u> OF <u>28</u> SHEETS PROJECT NO. <u>230-032</u>
	REVISIONS 1 2 3	RECORD PLAN NOV 1988

DRAWING NUMBER JACKS 87