
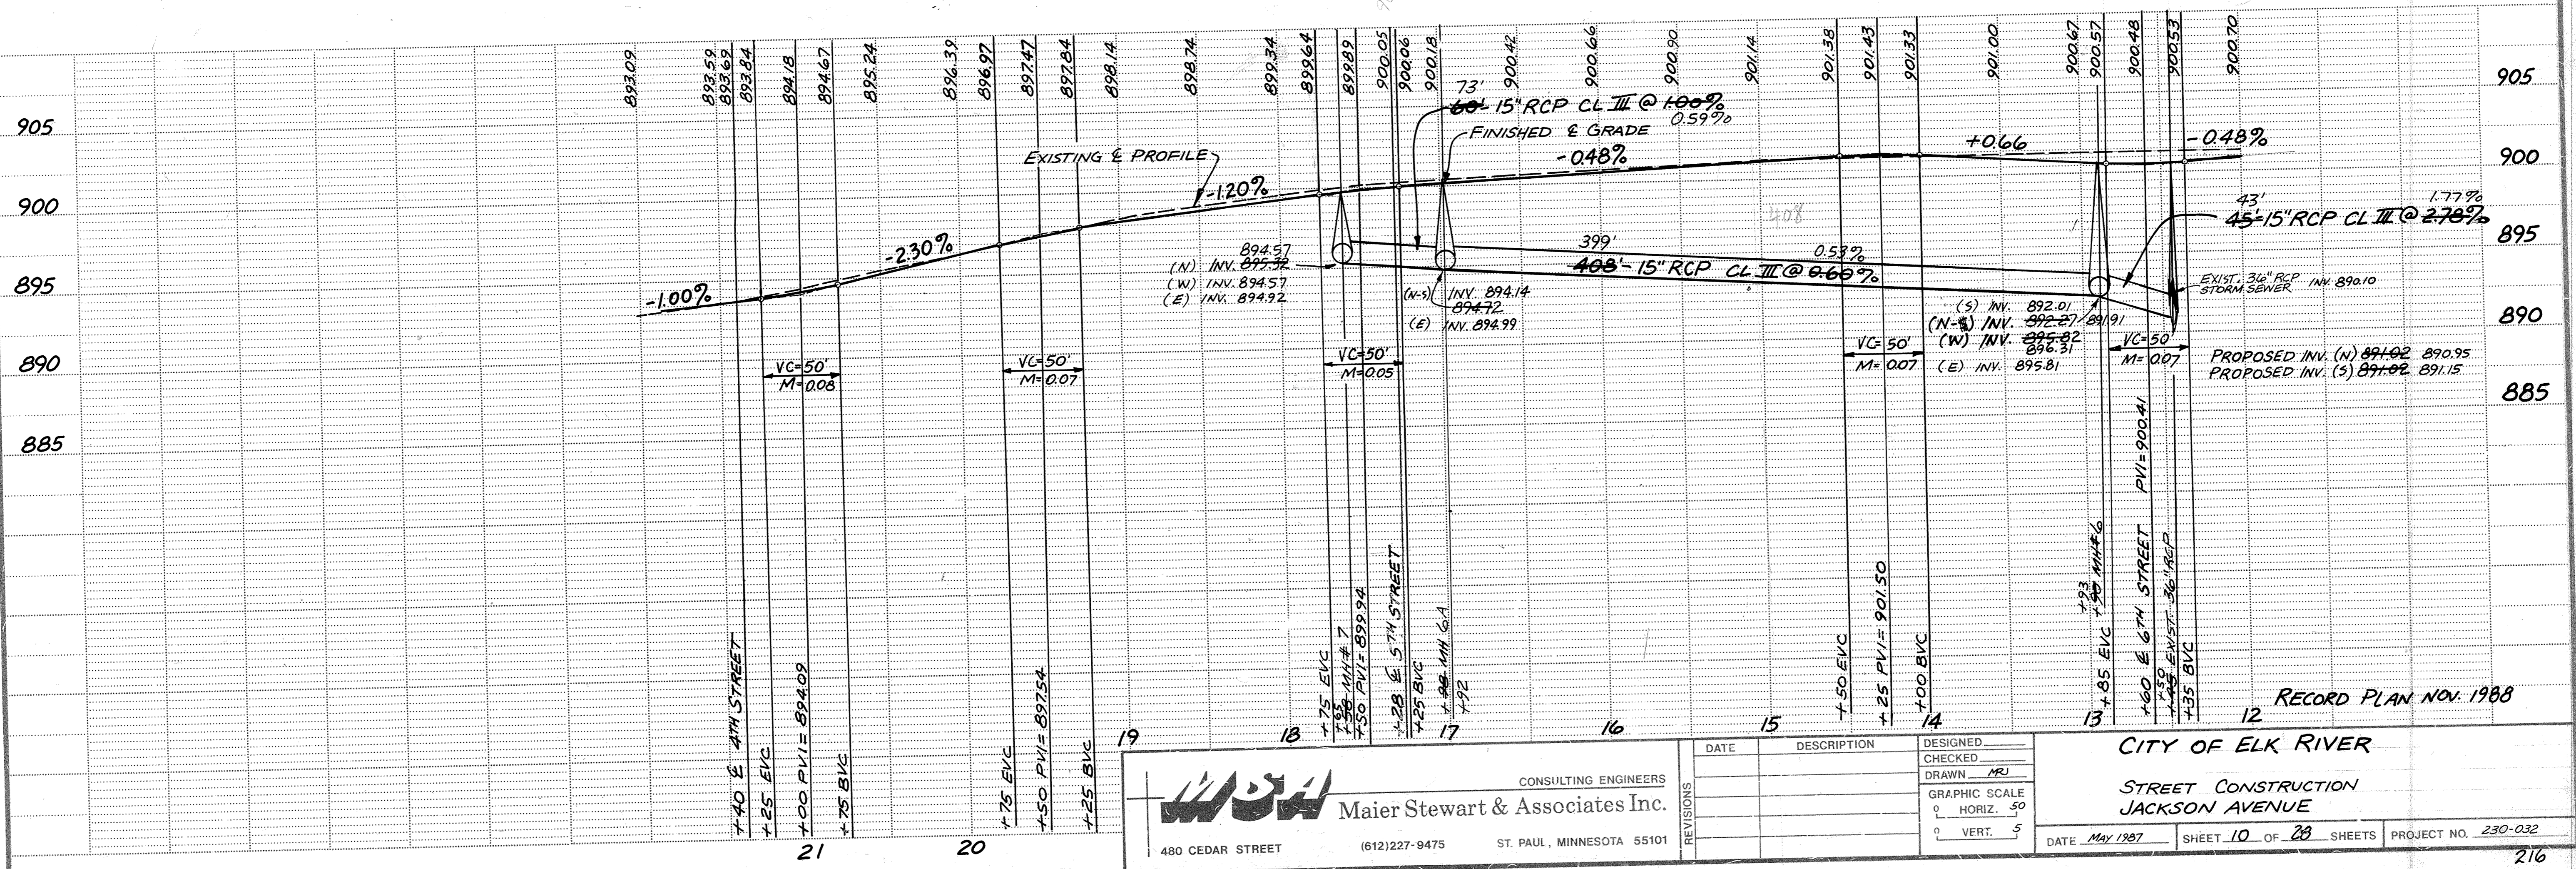
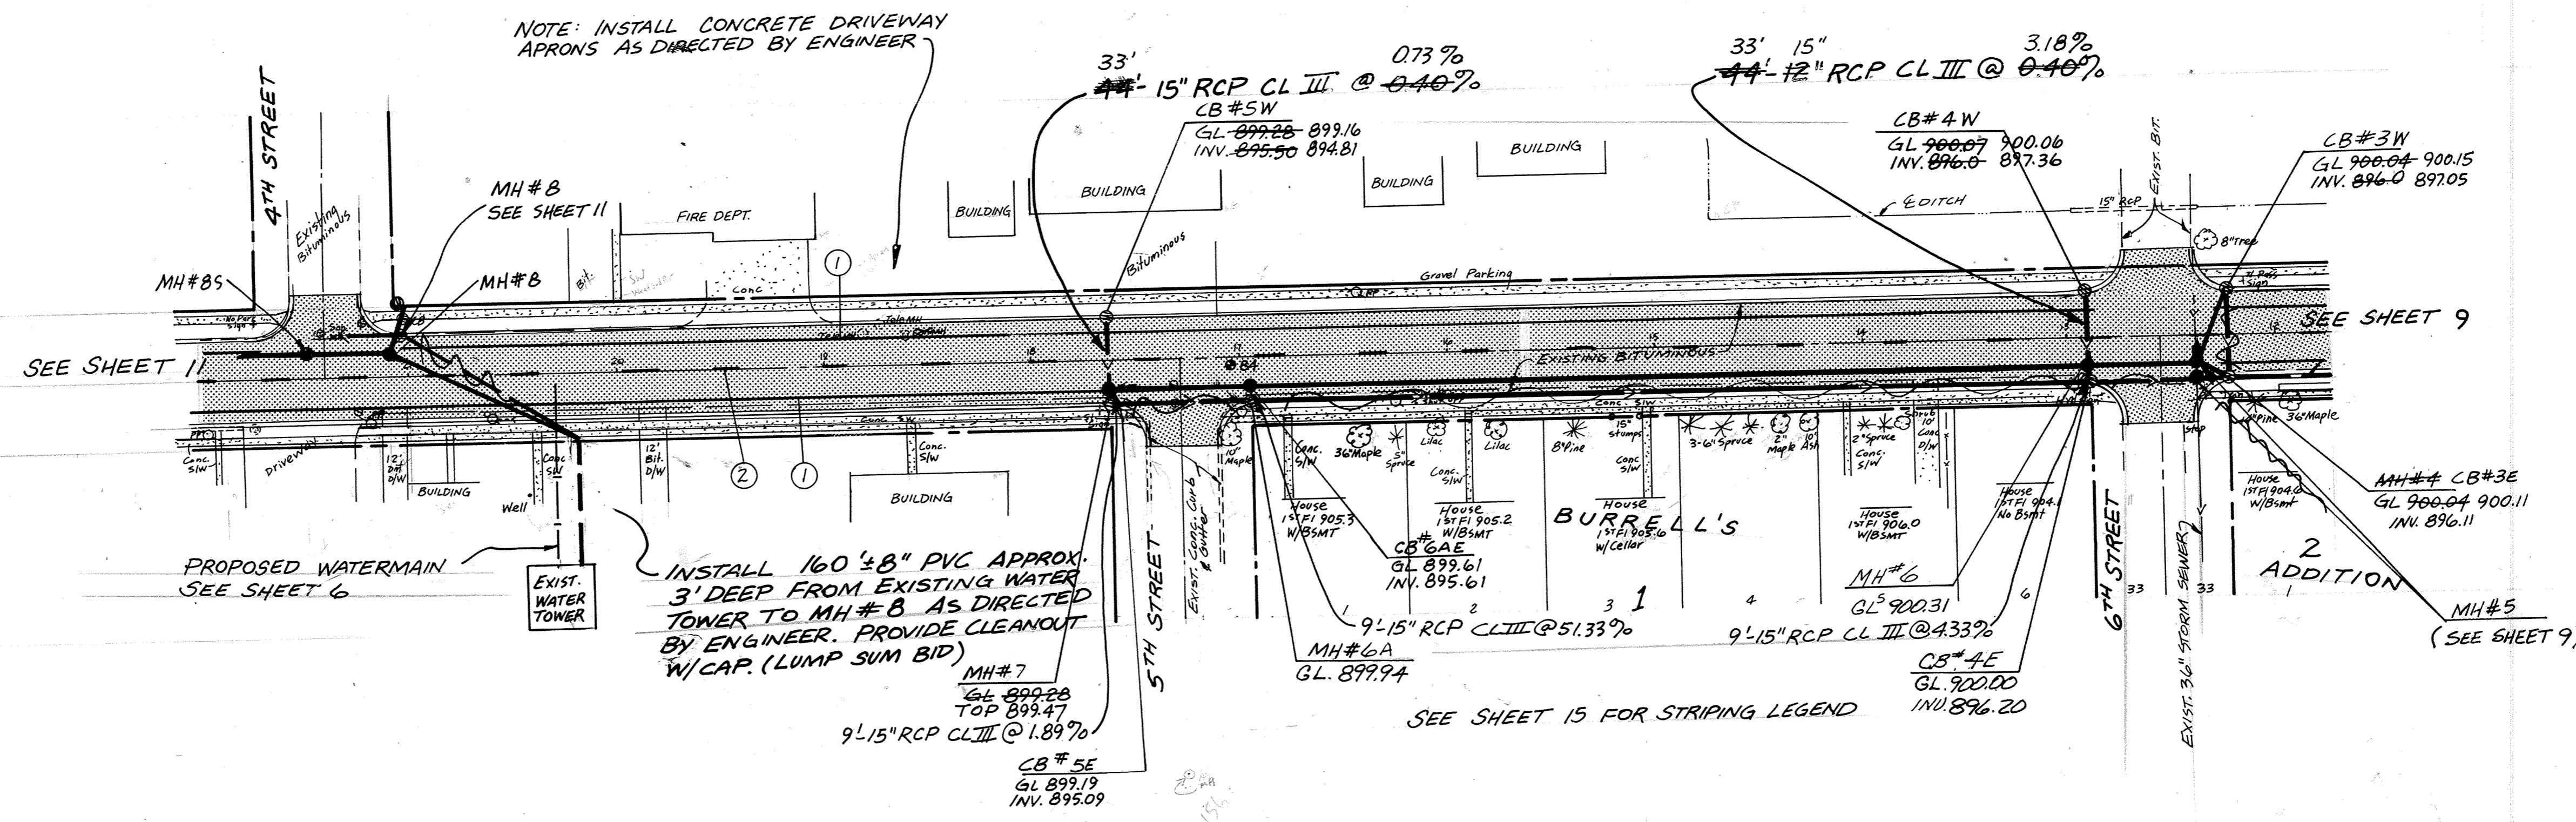


# JACKSON AVENUE

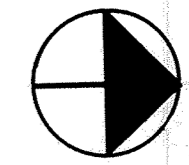

CONSULTING ENGINEERS  
**Maier Stewart & Associates Inc.**  
 480 CEDAR STREET (612)227-9475 ST. PAUL, MINNESOTA 55101

DATE	DESCRIPTION

DESIGNED \_\_\_\_\_  
 CHECKED MRJ  
 DRAWN MRJ  
 GRAPHIC SCALE  
 HORIZ. 50'  
 VERT. 5'

**CITY OF ELK RIVER**  
 STREET CONSTRUCTION  
 JACKSON AVENUE  
 DATE May 1987 SHEET 10 OF 28 SHEETS PROJECT NO. 230-032

DRAWING NUMBER JACKS 87 10