

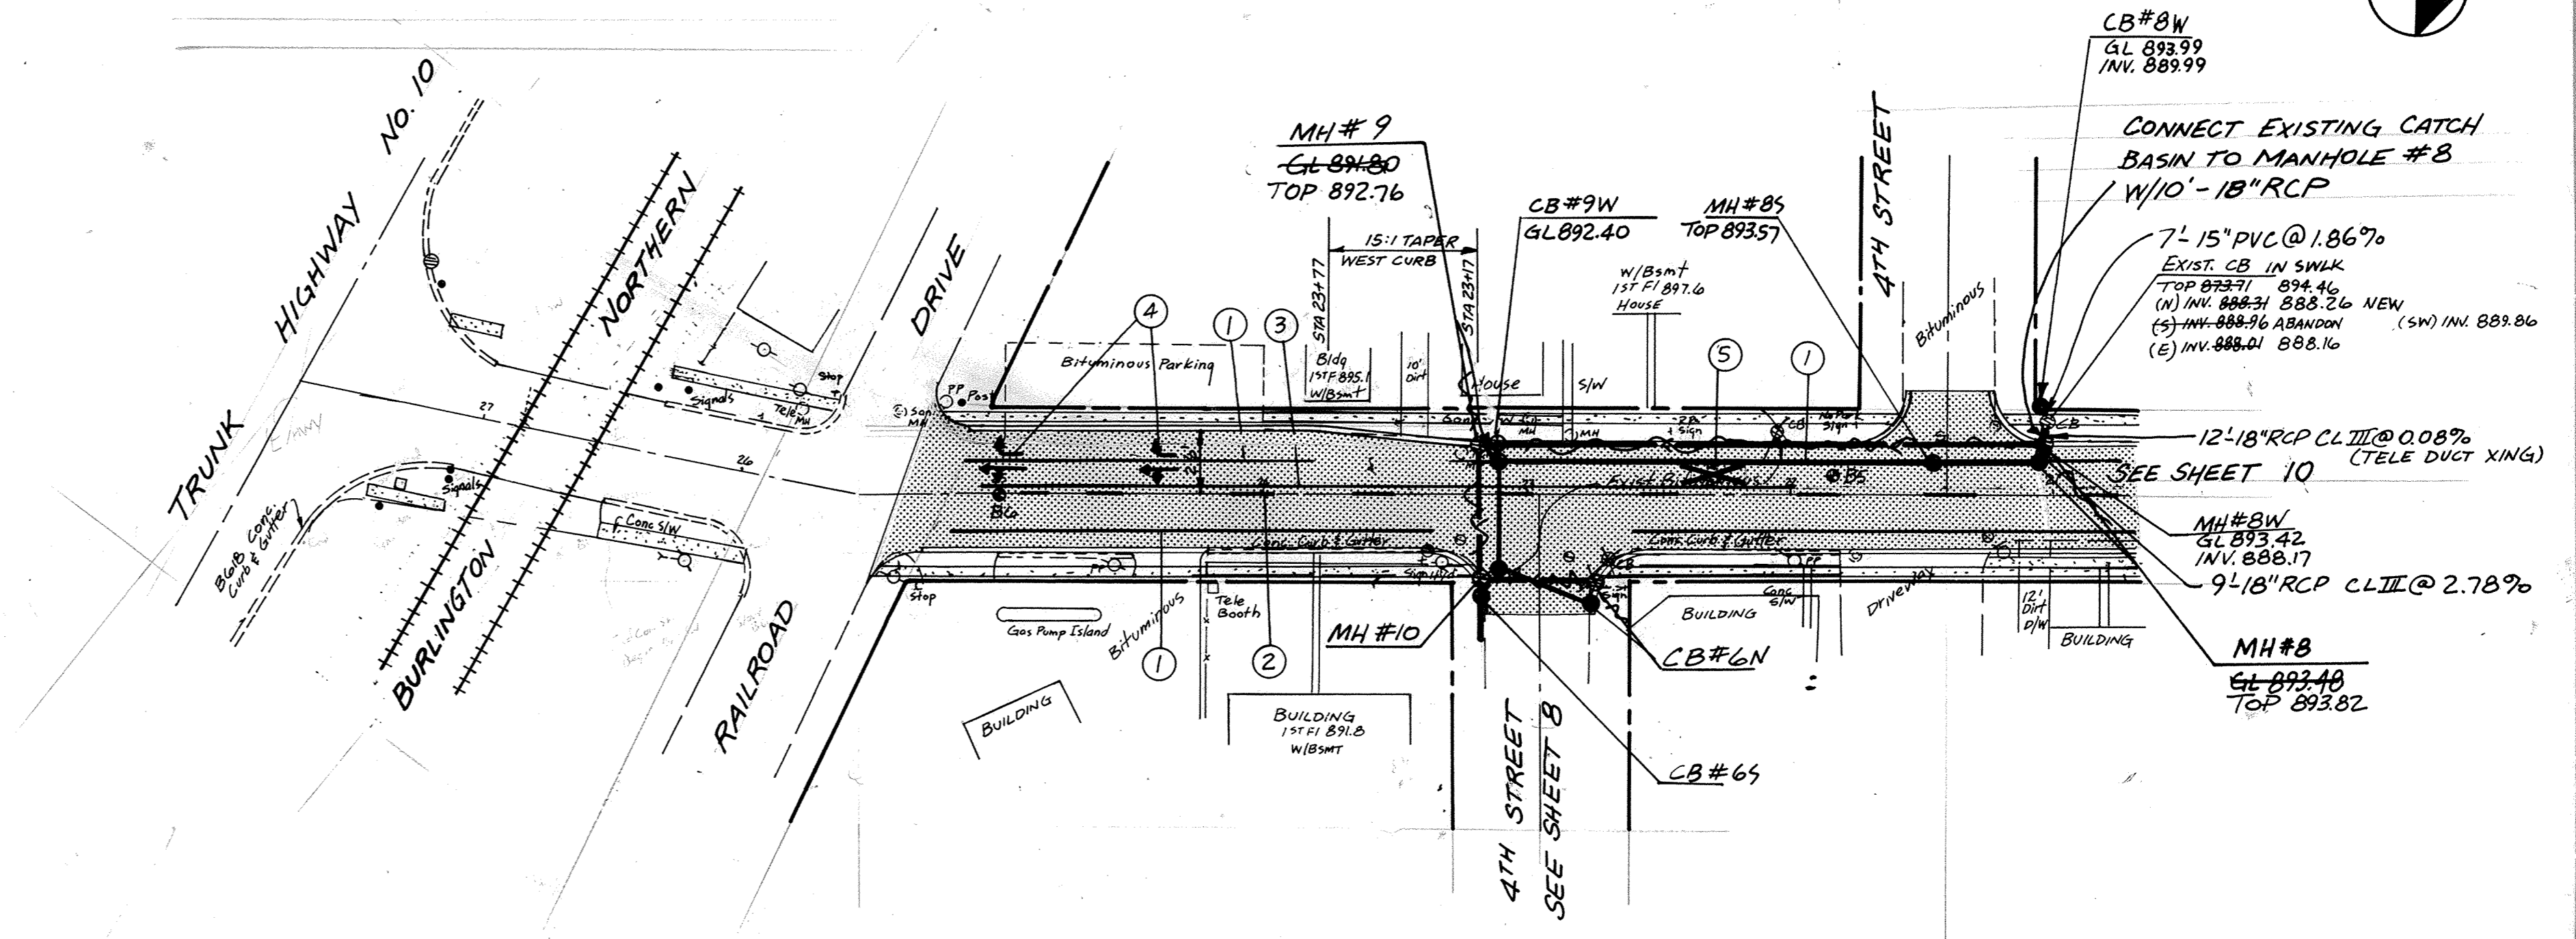


JACKSON AVENUE

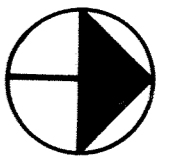

SEE SHEET 15 FOR STRIPING LEGEND.

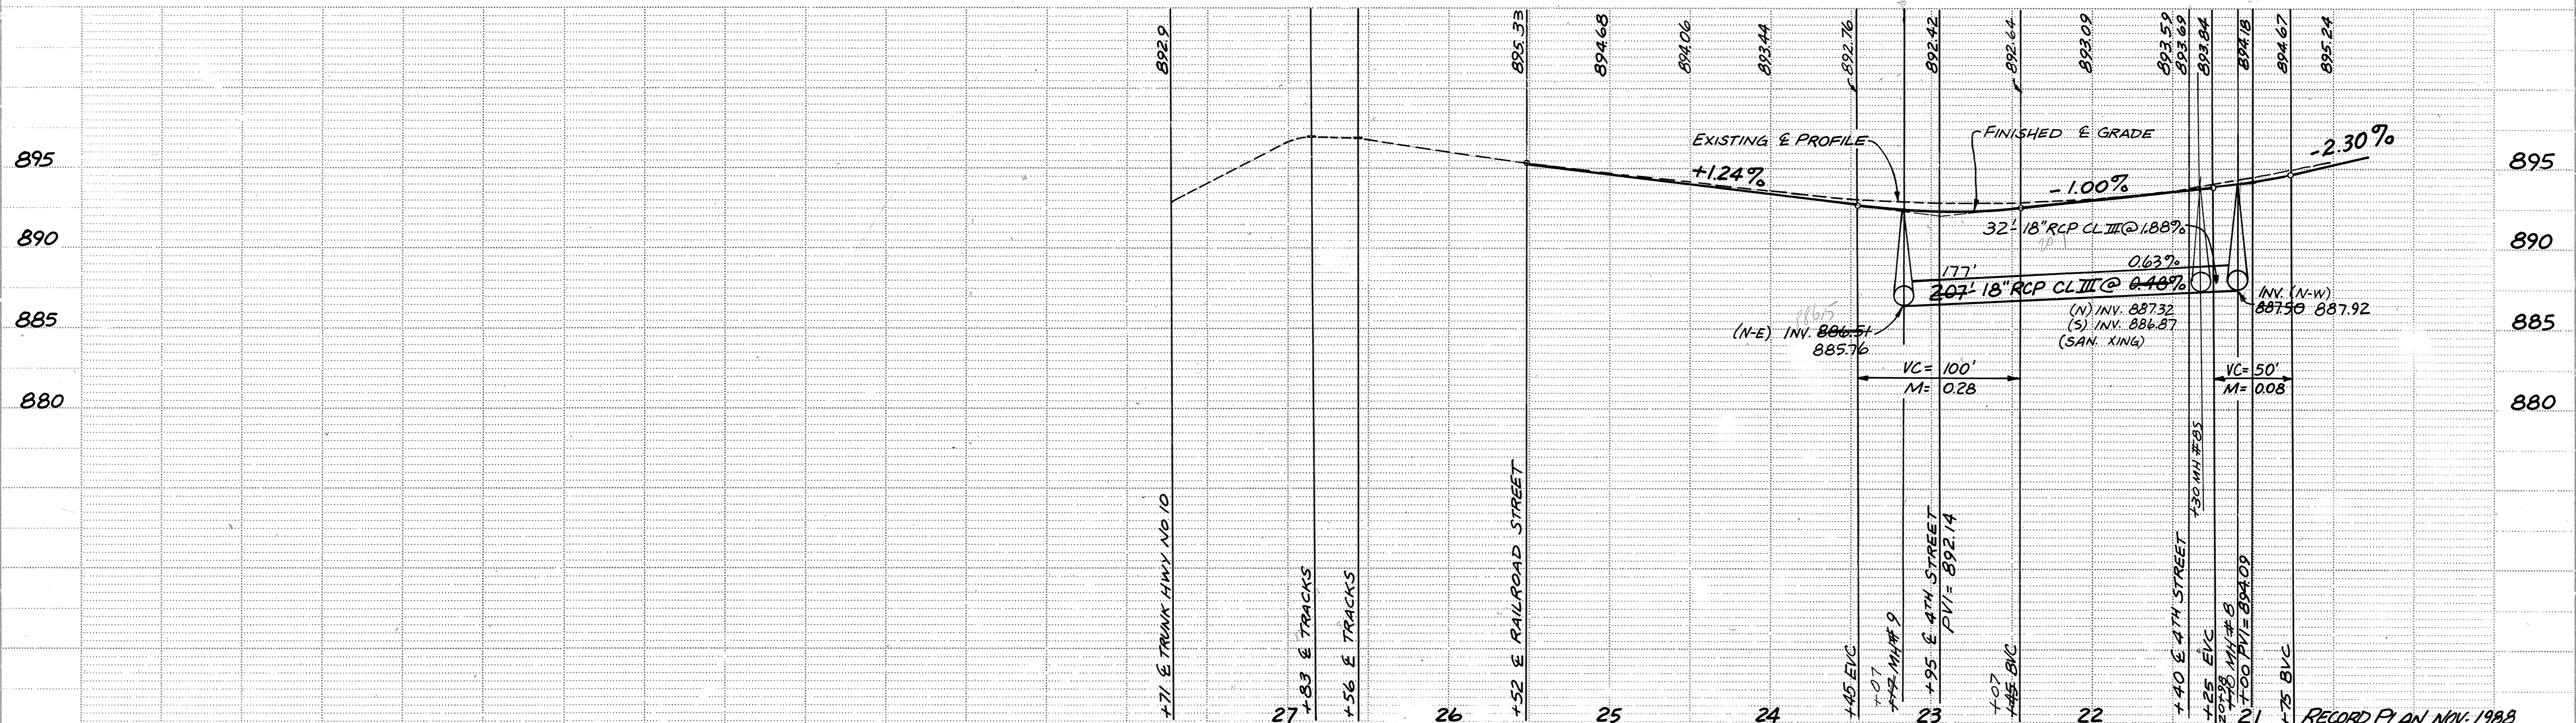

<p>CONSULTING ENGINEERS Maier Stewart & Associates Inc. 480 CEDAR STREET (612)227-9475 ST. PAUL, MINNESOTA 55101</p>	DATE	DESCRIPTION	DESIGNED	<p>CITY OF ELK RIVER SAP NO 204-104-01 STREET CONSTRUCTION & STORM SEWER JACKSON AVENUE</p>	
	DATE	DESCRIPTION	CHECKED		
	DATE	DESCRIPTION	DRAWN		MRJ
	DATE	DESCRIPTION	GRAPHIC SCALE		0 HORIZ. 50 0 VERT. 5
DATE	MAY 1987	SHEET 11 OF 28 SHEETS	PROJECT NO. 230-032		

DRAWING NUMBER
JACKS 87

DRAWING NUMBER
11

DRAWING NUMBER
215

DRAWING NUMBER
JACKS 87