



JACKSON AVENUE

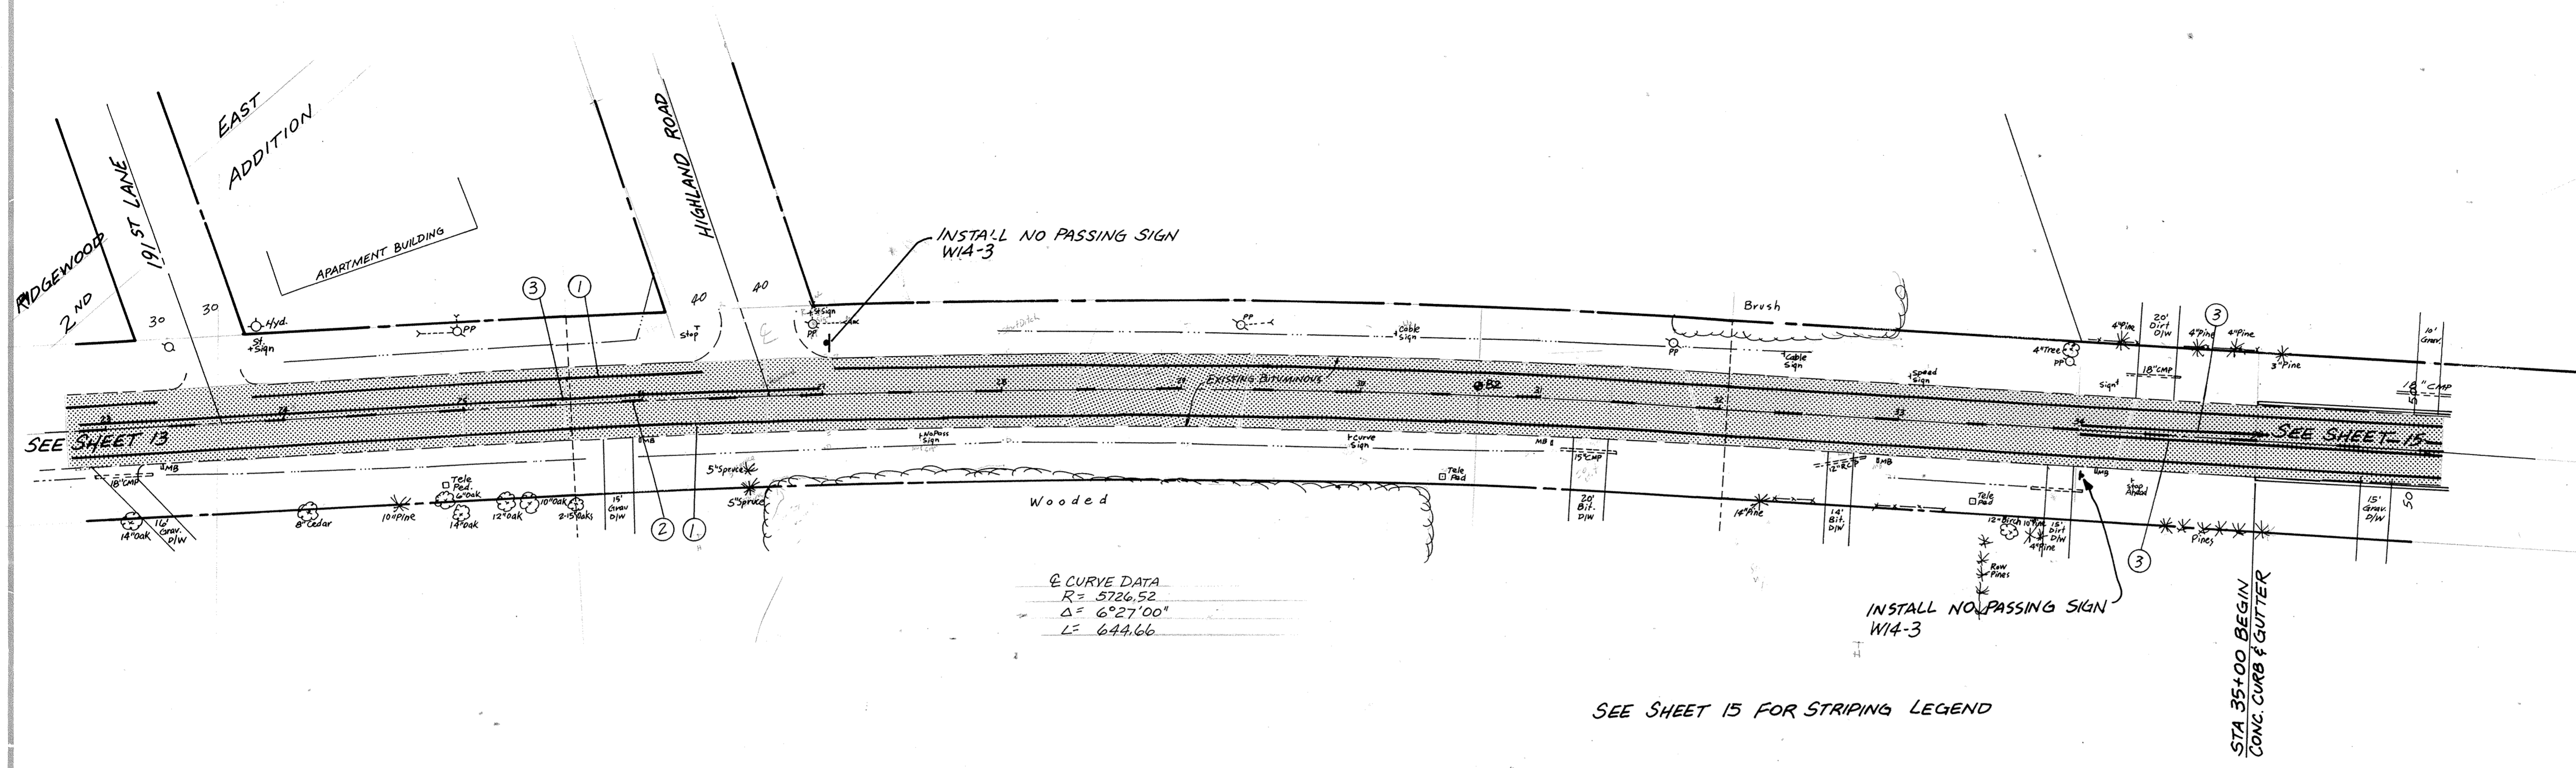

② CURVE DATA
 R = 5726.52
 Δ = 6°27'00"
 L = 644.66

SEE SHEET 15 FOR STRIPING LEGEND

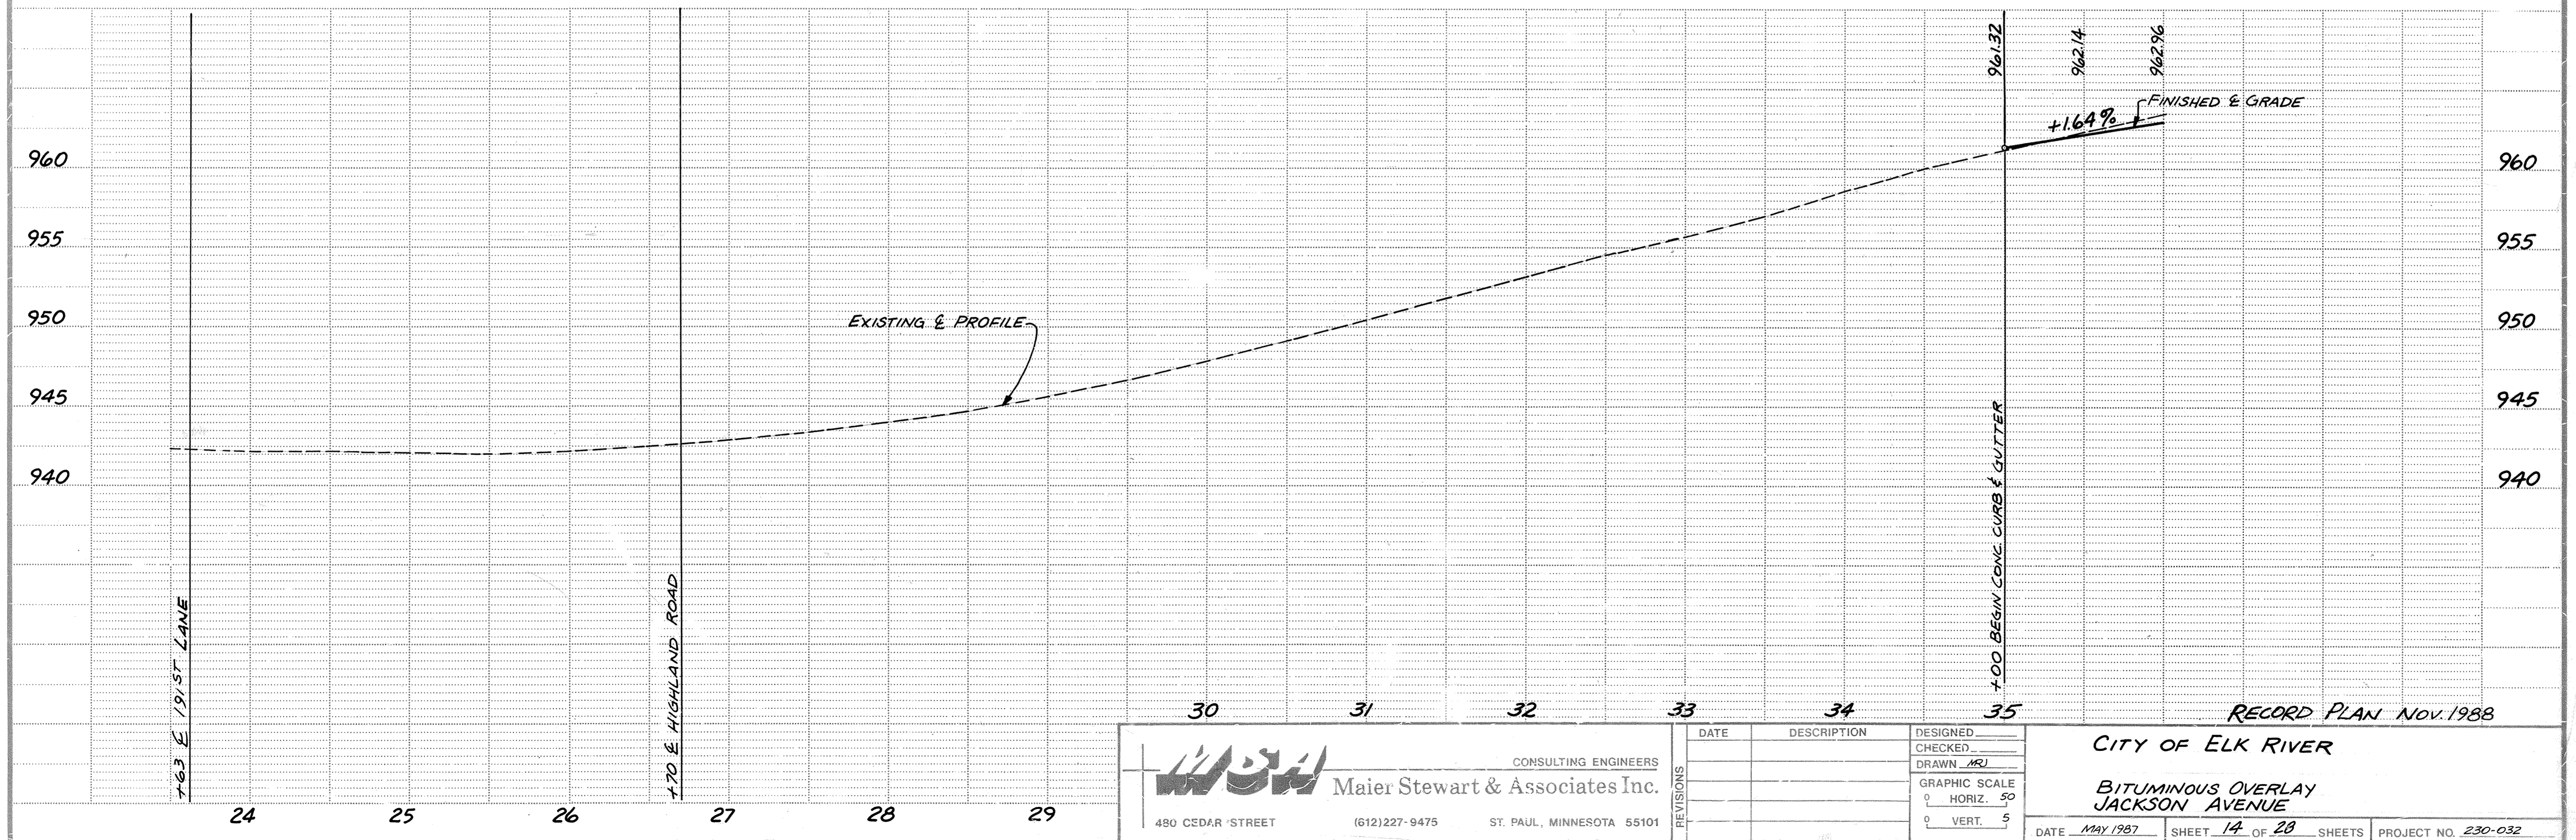

Maier Stewart & Associates Inc.
 CONSULTING ENGINEERS
 480 CEDAR STREET (612)227-9475 ST. PAUL, MINNESOTA 55101

REVISIONS	DATE	DESCRIPTION	DESIGNED	CHECKED	DRAWN

CITY OF ELK RIVER
 BITUMINOUS OVERLAY
 JACKSON AVENUE
 RECORD PLAN NOV. 1988
 DATE MAY 1987 SHEET 14 OF 28 SHEETS PROJECT NO. 230-032

DRAWING NUMBER
 JACKS. 87

DRAWING NUMBER
 JACKS. 87

DRAWING NUMBER
 JACKS. 87

DRAWING NUMBER
 JACKS. 87

DESIGN PROJECTS • NEW URBAN MINNESOTA
 REVISIONS BY PLANT NUMBER 8833