

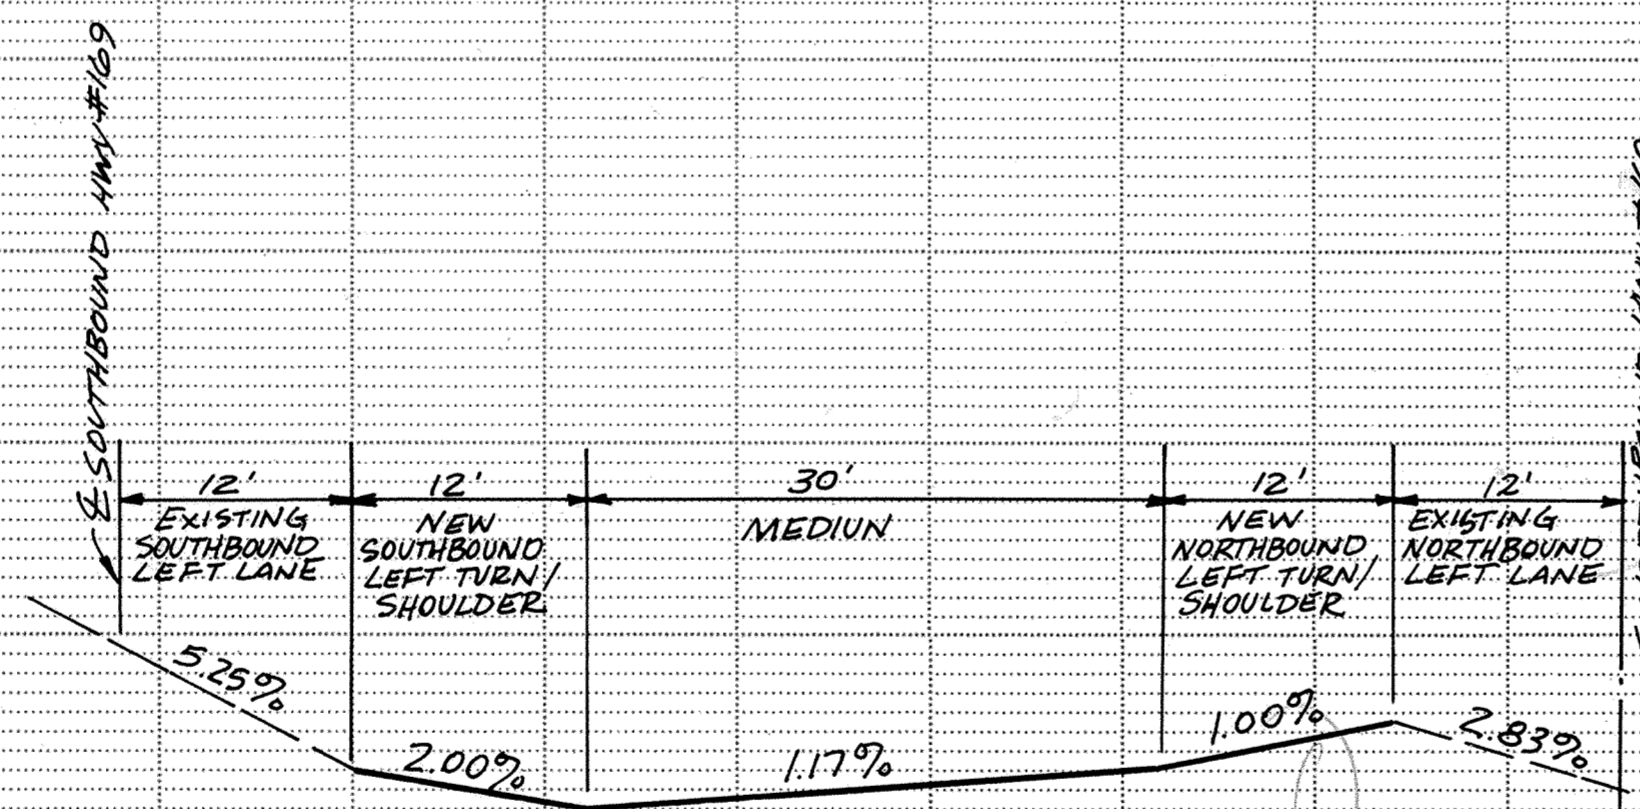
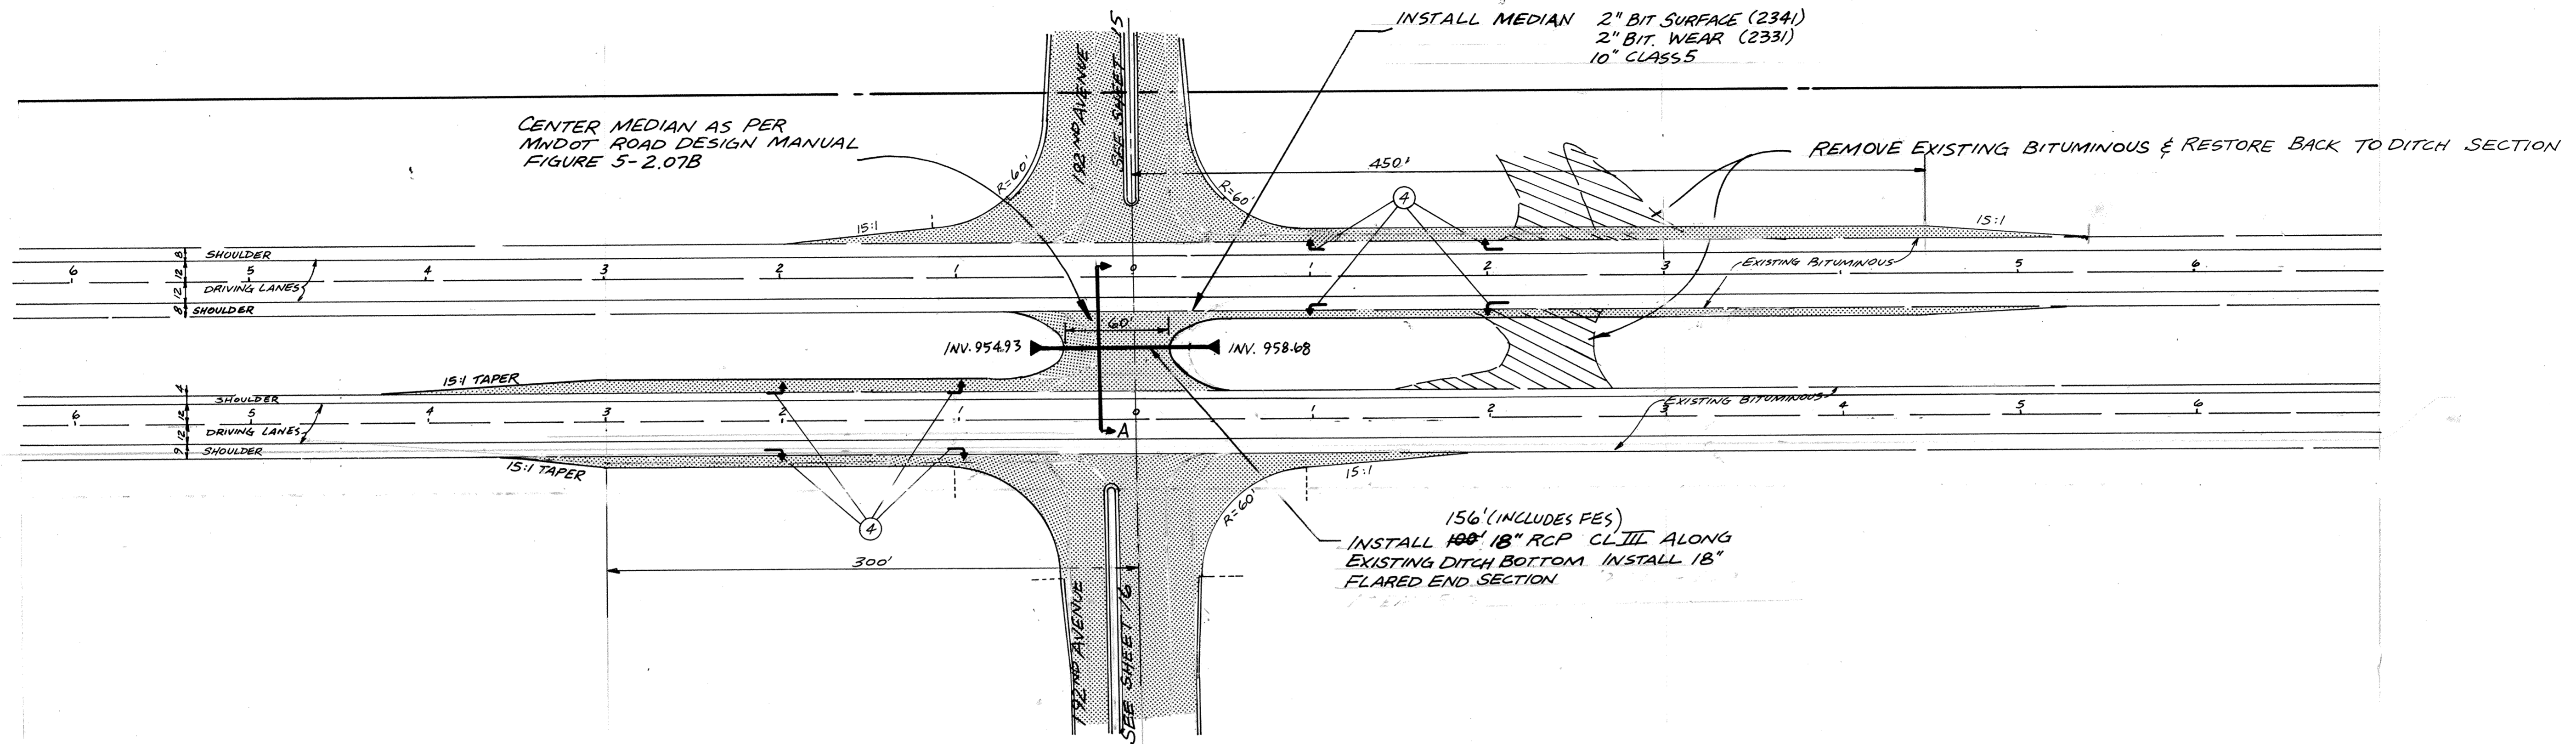


U.S. HIGHWAY NO. 169

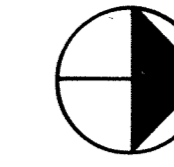

MEDIAN SECTION A-A

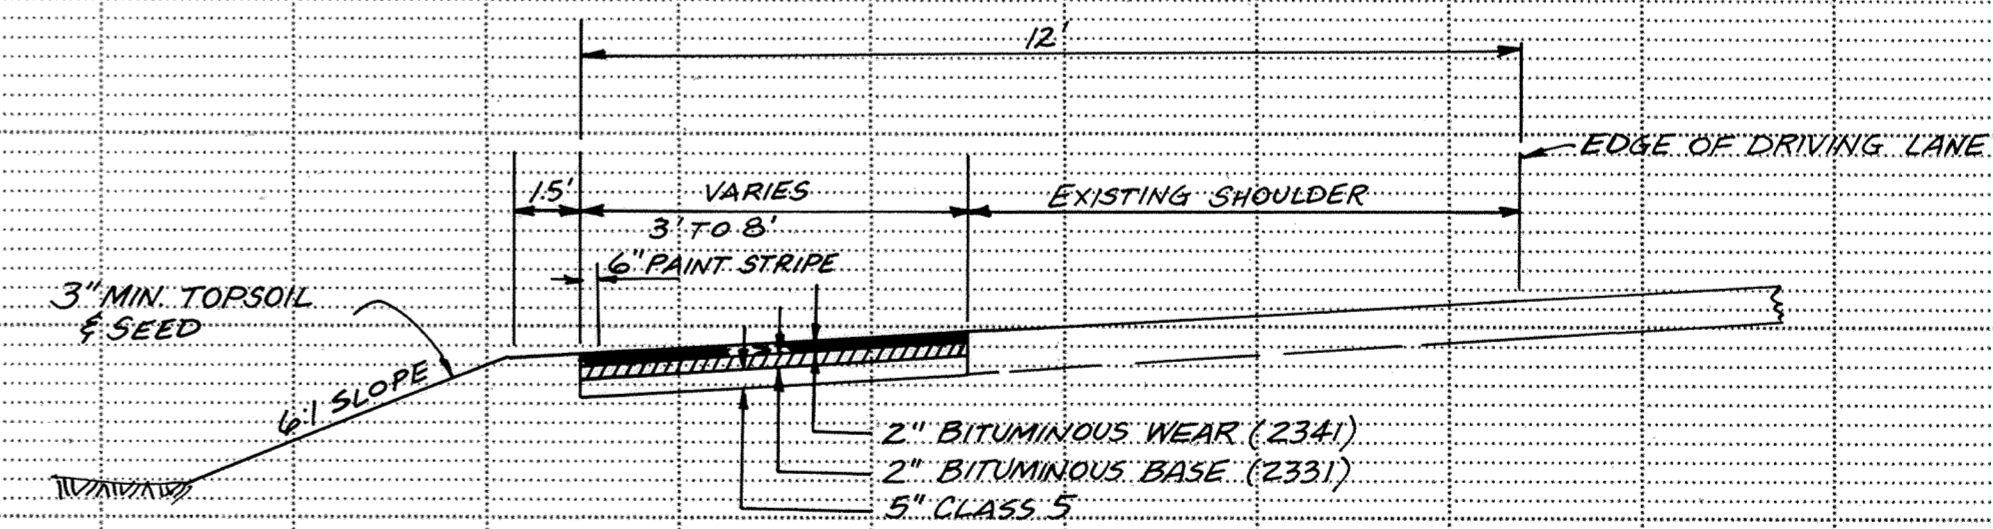

TURN LANE SECTION

RECORD PLAN NOV. 1988

SAP 204-104-01

MS&A CONSULTING ENGINEERS
Maier Stewart & Associates Inc.
 1959 SLOAN PLACE (612)774-6021 ST. PAUL, MINNESOTA 55117

DATE	DESCRIPTION	DESIGNED
5/1/88	Median	
		CHECKED
		DRAWN <i>MRJ</i>
		GRAPHIC SCALE
		0 HORIZ. 50
		0 VERT.

CITY OF ELK RIVER
 TURN LANES
 US HIGHWAY NO. 169

DATE OCT 1987 SHEET 17 OF 28 SHEETS PROJECT NO. 230-032

DRAWING NUMBER

DRAWING NUMBER

DRAWING NUMBER

DRAWING NUMBER
 JACKS 87
 17