

DRAWING NUMBER

DRAWING NUMBER

DRAWING NUMBER


DRAWING NUMBER
JACKS 87
20

STATE PROJECTS - NEW URBAN MINNESOTA
REVISION BY PART NUMBER 0000

STATE PROJECTS - NEW URBAN MINNESOTA
REVISION BY PART NUMBER 0000

STATE PROJECTS - NEW URBAN MINNESOTA
REVISION BY PART NUMBER 0000

STATE PROJECTS - NEW URBAN MINNESOTA
REVISION BY PART NUMBER 0000

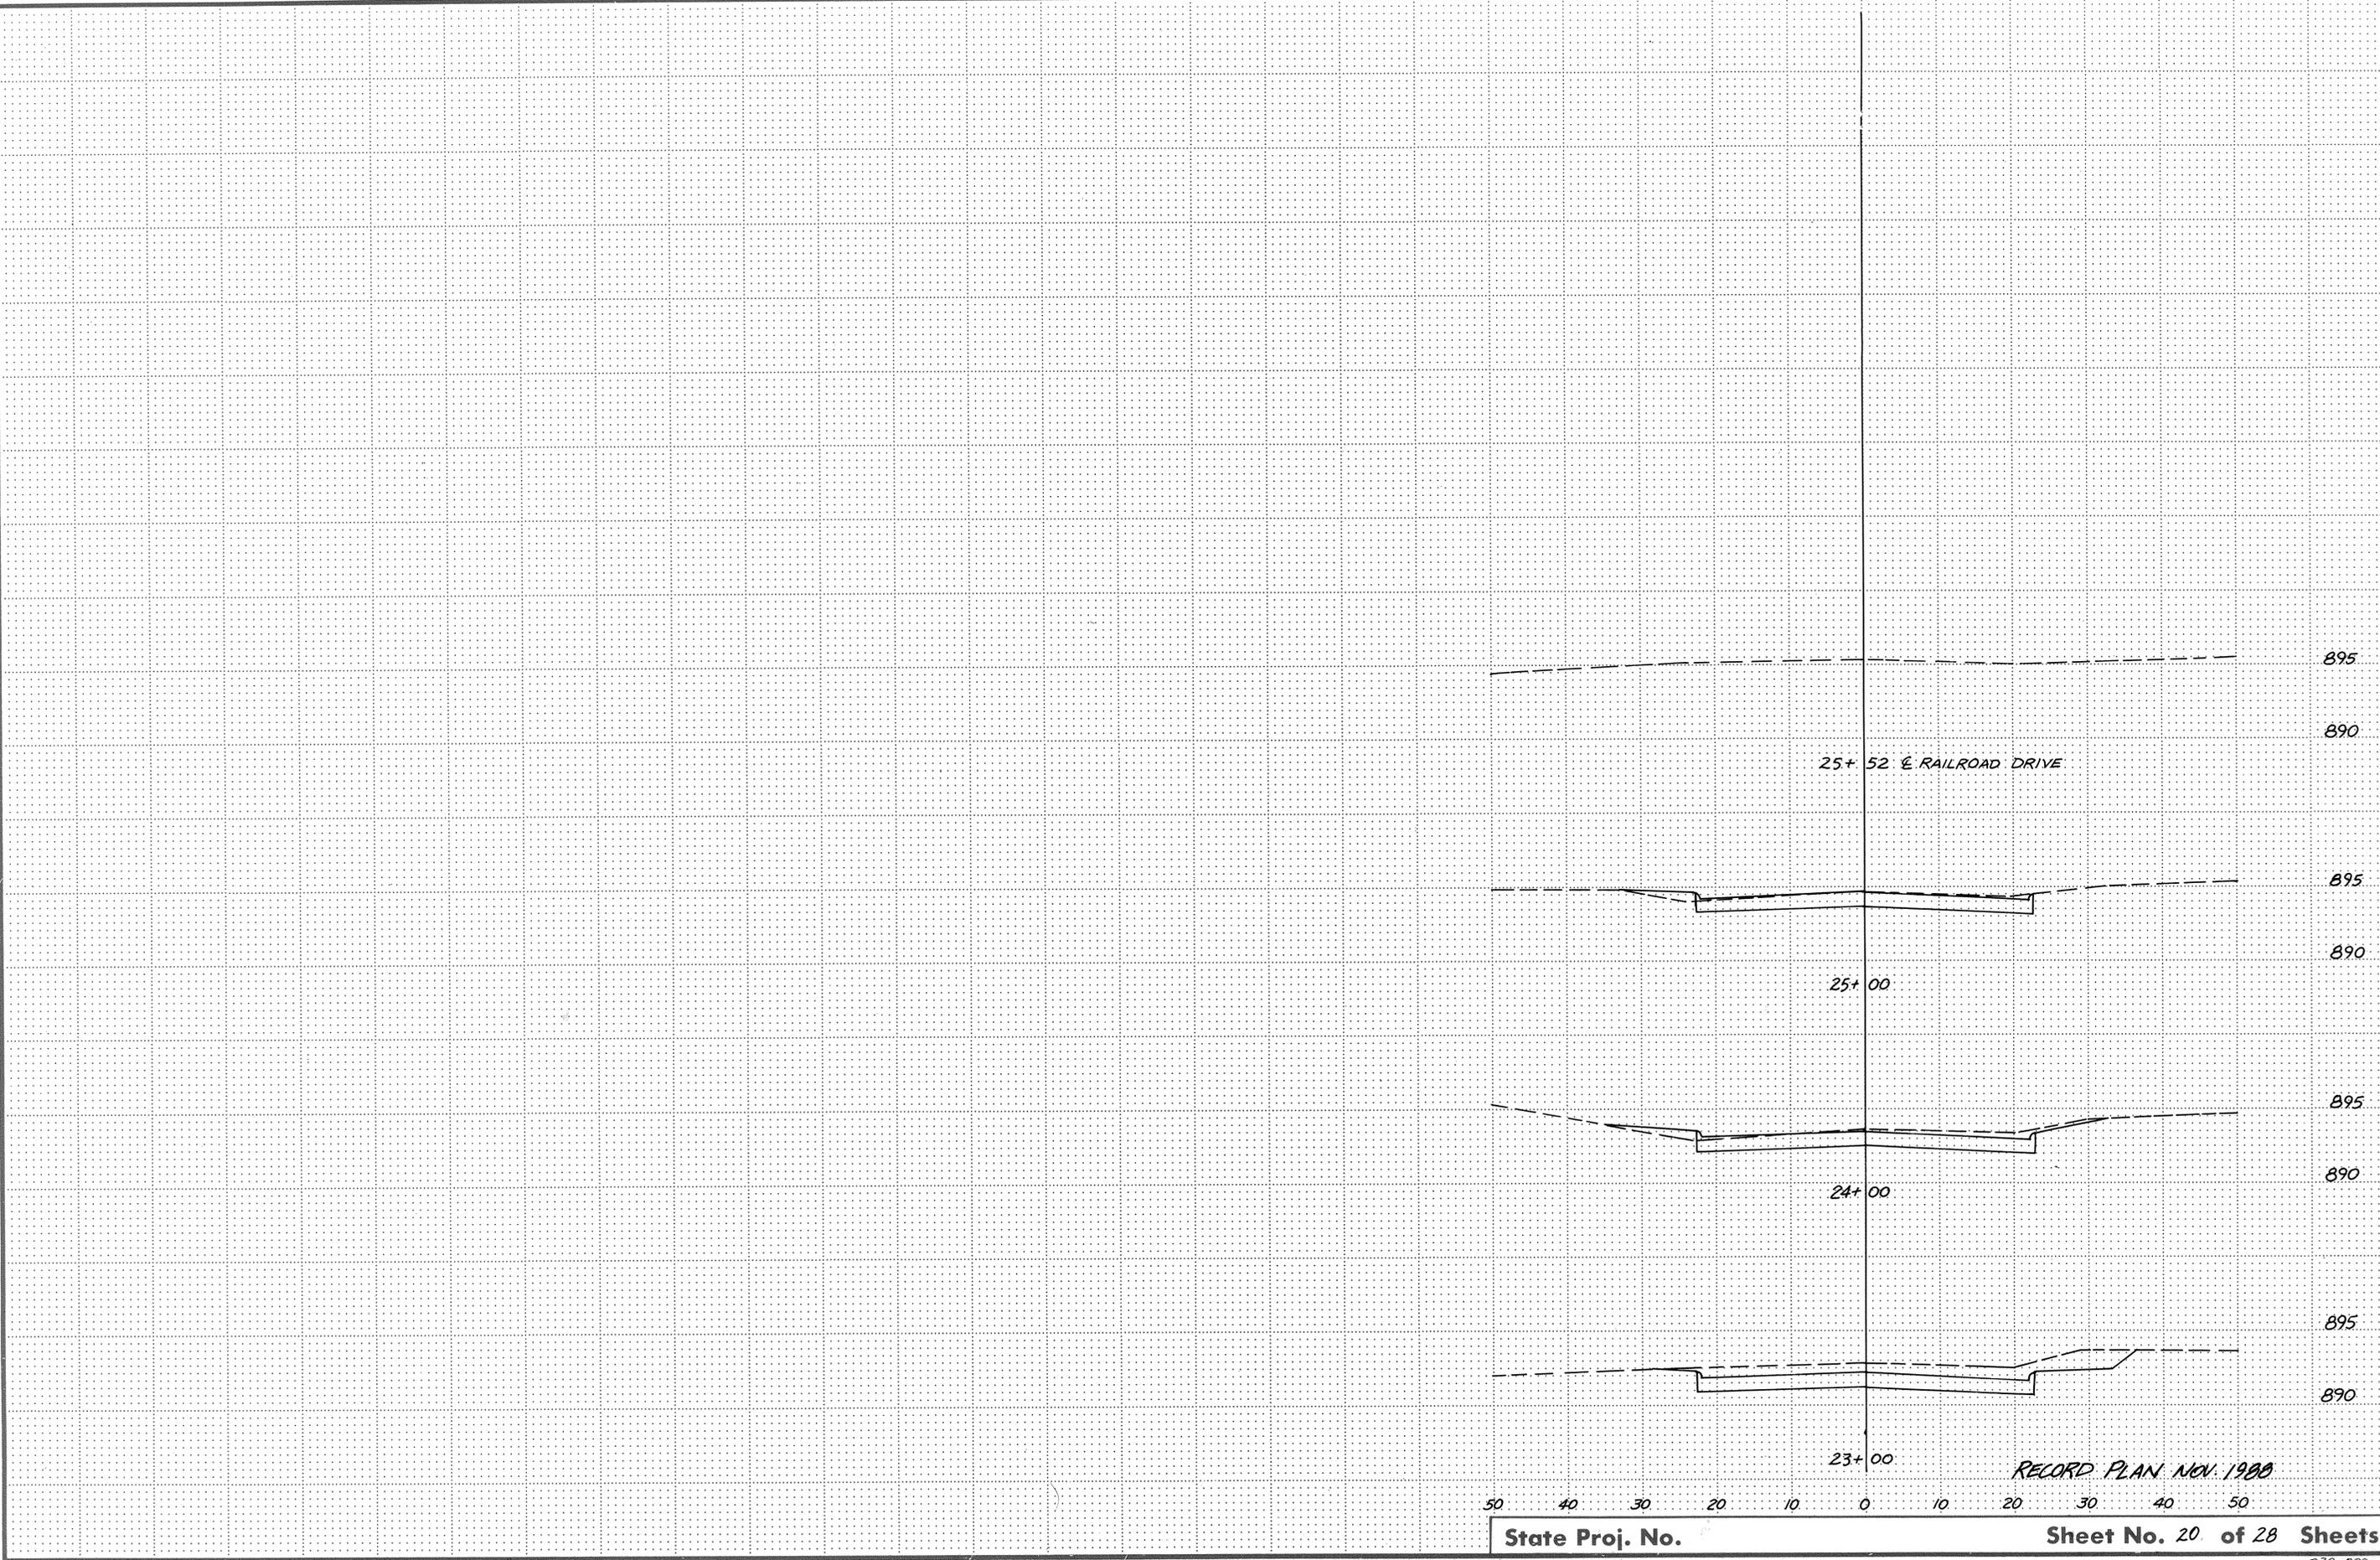

State Proj. No. _____ Sheet No. 20 of 28 Sheets

SCALE HORIZ. 1"=10'
VERT. 1"=5'

JACKSON AVENUE SOUTH OF SCHOOL STREET

230-032 206