

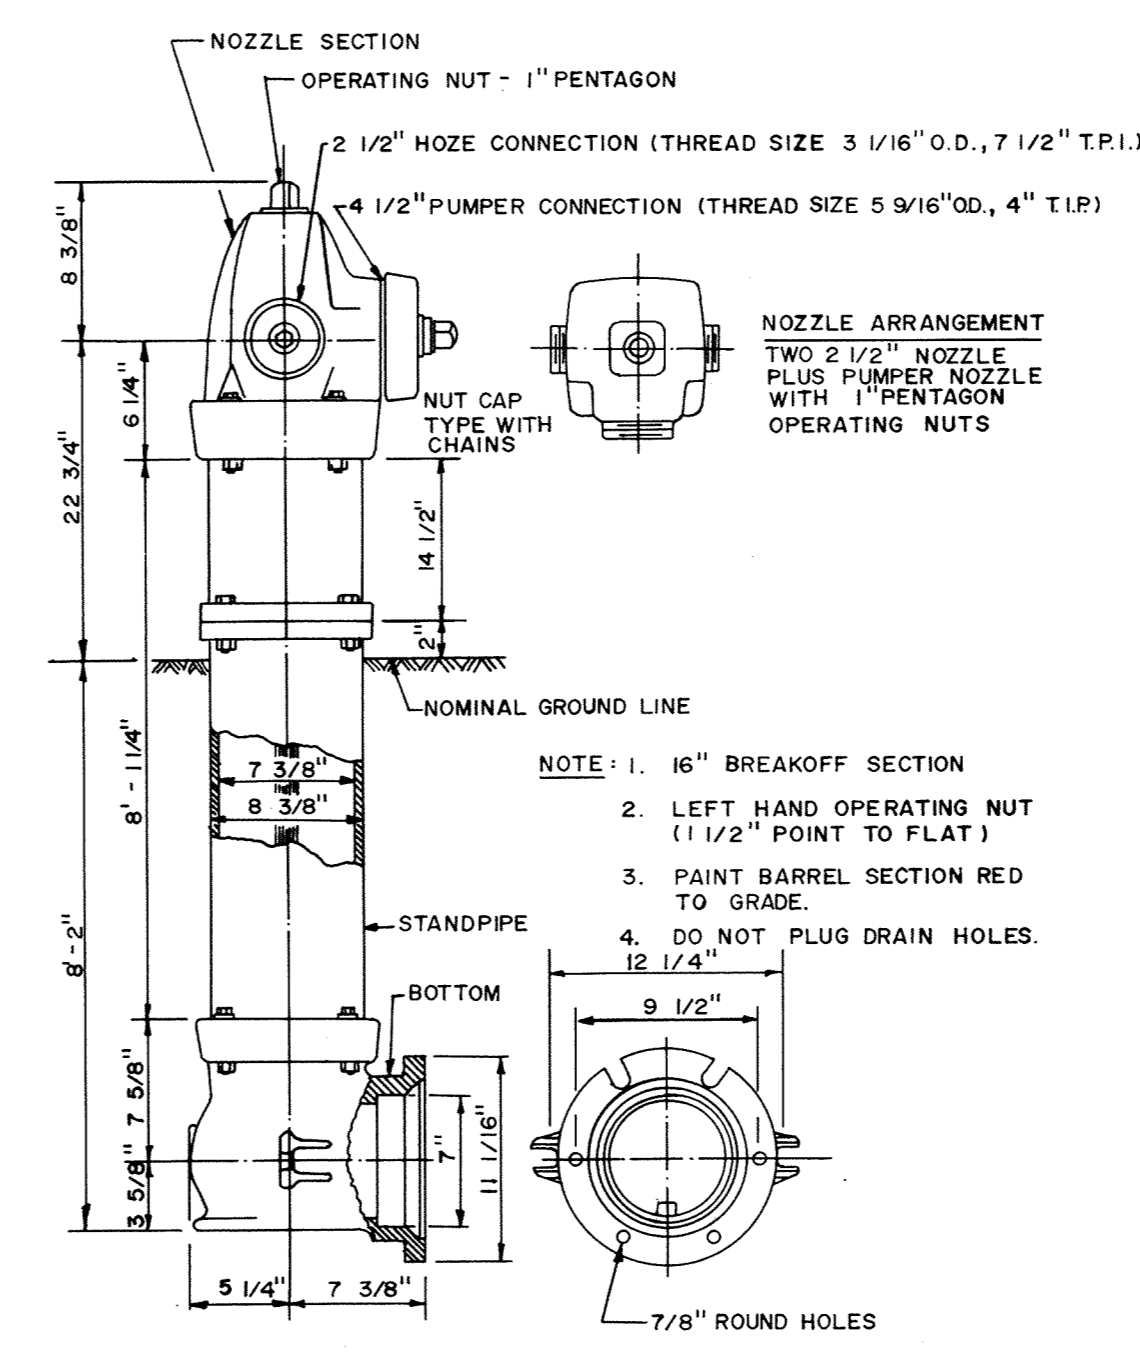


NOMINAL FITTING SIZE, INCHES	TEE, WYE, PLUG OR CAP	90° BEND, PLUGGED CROSS		TEE PLUGGED ON RUN		45° BEND	22 1/2° BEND	11 1/4° BEND
		A'	A''	A'	A''			
4	1.0	1.4	1.9	1.4	1.0	—	—	—
6	2.1	3.0	4.3	3.0	1.6	—	—	—
8	3.8	5.3	7.6	5.4	2.9	1.5	1.0	—
10	5.9	8.4	11.8	8.4	4.6	2.6	1.2	—
12	8.5	12.0	17.0	12.0	6.6	3.4	1.7	—
14	11.5	16.3	23.0	16.3	8.9	4.6	2.3	—
16	15.0	21.3	30.0	21.3	11.6	6.0	3.0	—
18	19.0	27.0	38.0	27.0	14.6	7.6	3.8	—
20	23.5	33.3	47.0	33.3	18.1	9.4	4.7	—
24	34.0	48.0	68.0	48.0	26.2	13.6	6.8	—


- NOTE:
1. CONCRETE THRUST BLOCKING TO BE POURED AGAINST UNDISTURBED EARTH.
 2. KEEP CONCRETE CLEAR OF JOINT AND ACCESSORIES.
 3. IF NOT SHOWN ON PLANS, REQUIRED BEARING AREAS AT FITTING SHALL BE AS INDICATED ABOVE, ADJUSTED IF NECESSARY, TO CONFORM TO THE TEST PRESSURE (S) AND ALLOWABLE SOIL BEARING STRESS (ES).
 4. BEARING AREAS AND SPECIAL BLOCKING DETAILS SHOWN ON PLANS TAKE PRECEDENCE OVER BEARING AREAS AND BLOCKING DETAILS SHOWN THIS STANDARD DETAIL.
 5. ABOVE BEARING AREAS BASED ON TEST PRESSURE OF 150 P.S.I. AND AN ALLOWABLE SOIL BEARING STRESS OF 2000 POUNDS PER SQUARE FOOT. TO COMPUTE BEARING AREAS FOR DIFFERENT TEST PRESSURES AND SOIL BEARING STRESSES, USE THE FOLLOWING EQUATION: BEARING AREA = (TEST PRESSURE / 150) x (2000 / SOIL BEARING STRESS) x (TABLE VALUE)

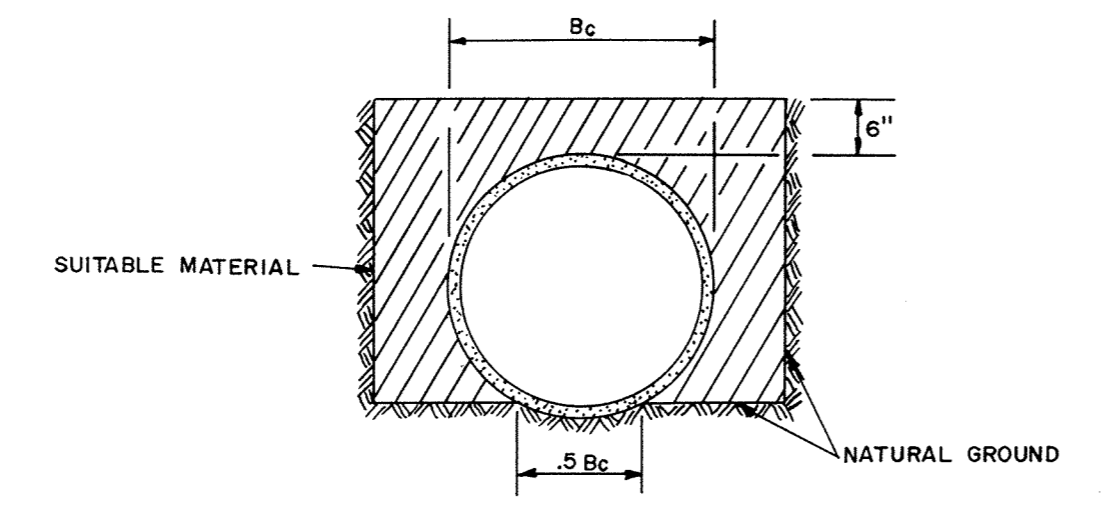

- NOTE:
1. 16" BREAKOFF SECTION
 2. LEFT HAND OPERATING NUT (1 1/2" POINT TO FLAT)
 3. PAINT BARREL SECTION RED TO GRADE.
 4. DO NOT PLUG DRAIN HOLES.

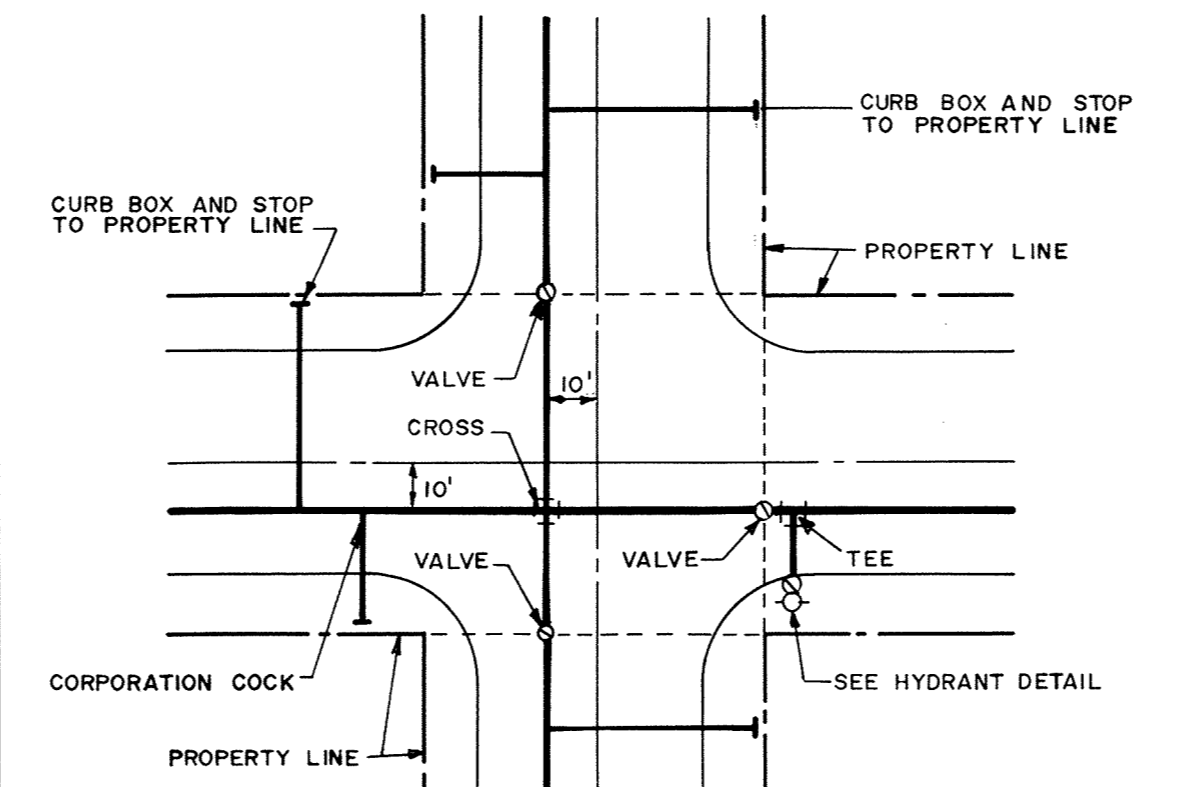


NOTE: ALL COSTS OF EXCAVATION BELOW GRADE AND PLACEMENT OF GRANULAR BEDDING SHALL BE INCLUDED IN THE BID PRICES FOR PIPE ITEMS.

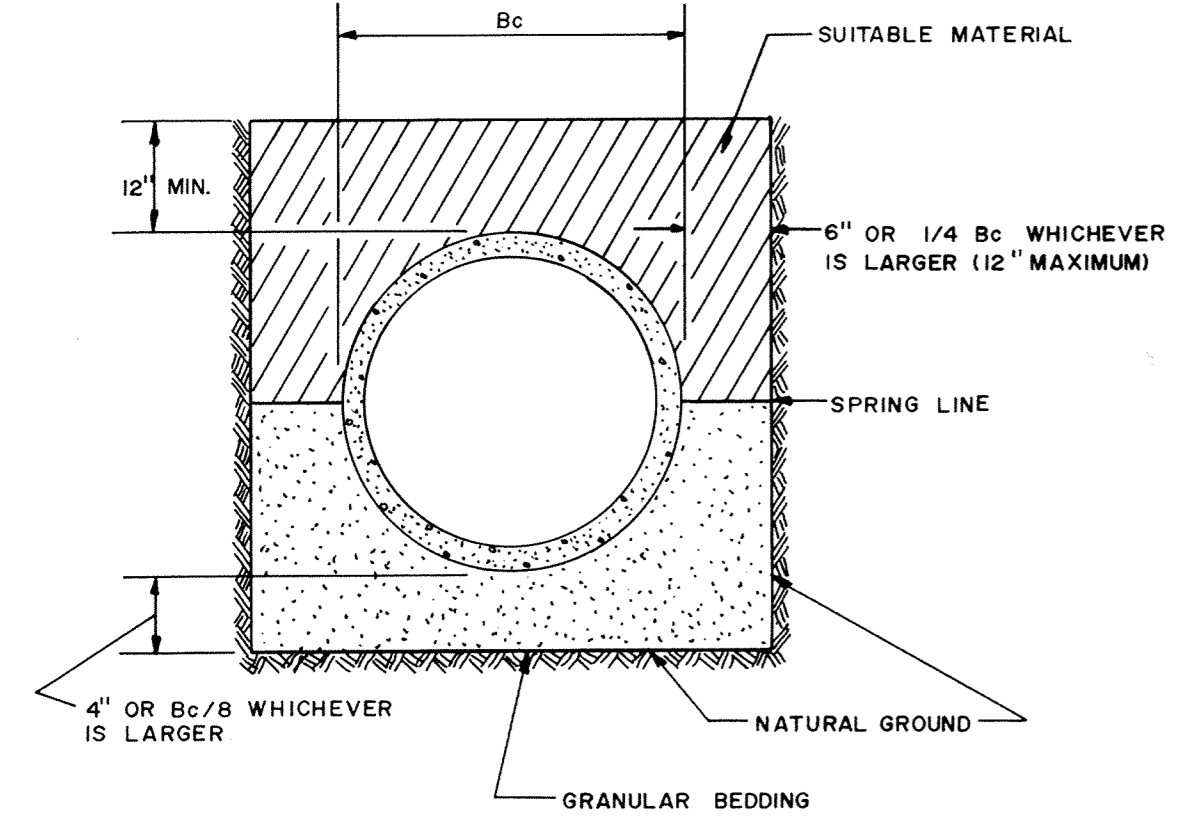


NOTE: ALL COSTS OF EXCAVATION BELOW GRADE AND PLACEMENT OF GRANULAR BEDDING SHALL BE INCLUDED IN THE BID PRICES FOR PIPE ITEMS.


THRUST BLOCKING DETAIL

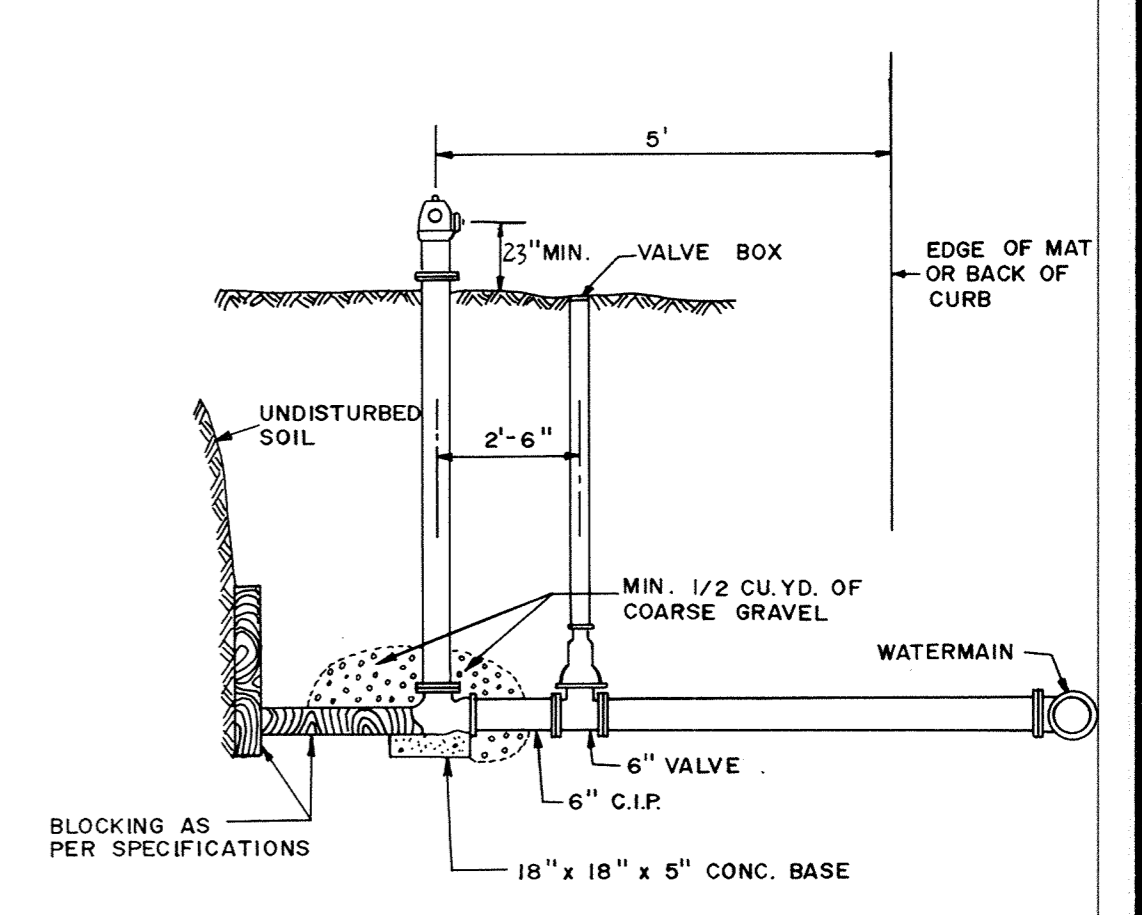



PACER HYDRANT DETAIL

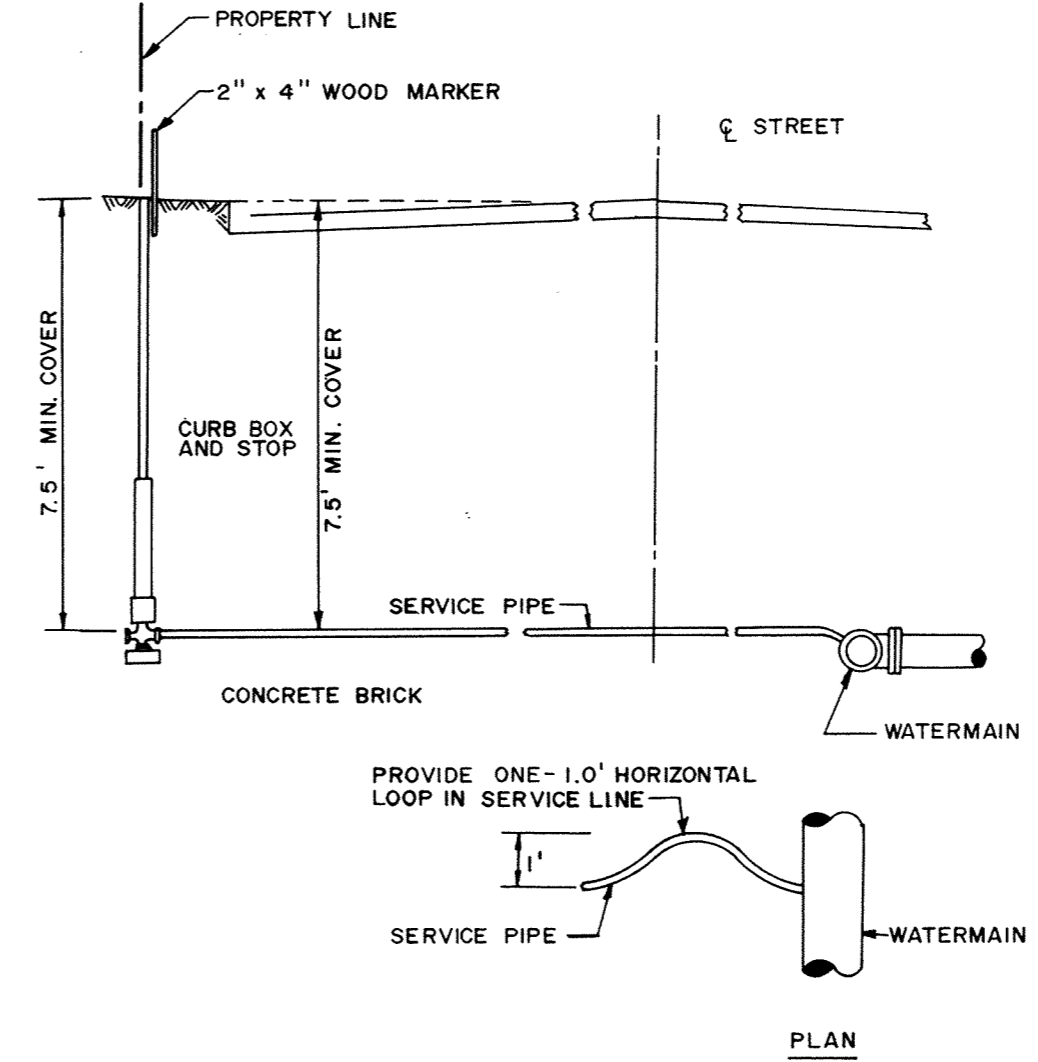

TYPICAL WATER LAYOUT

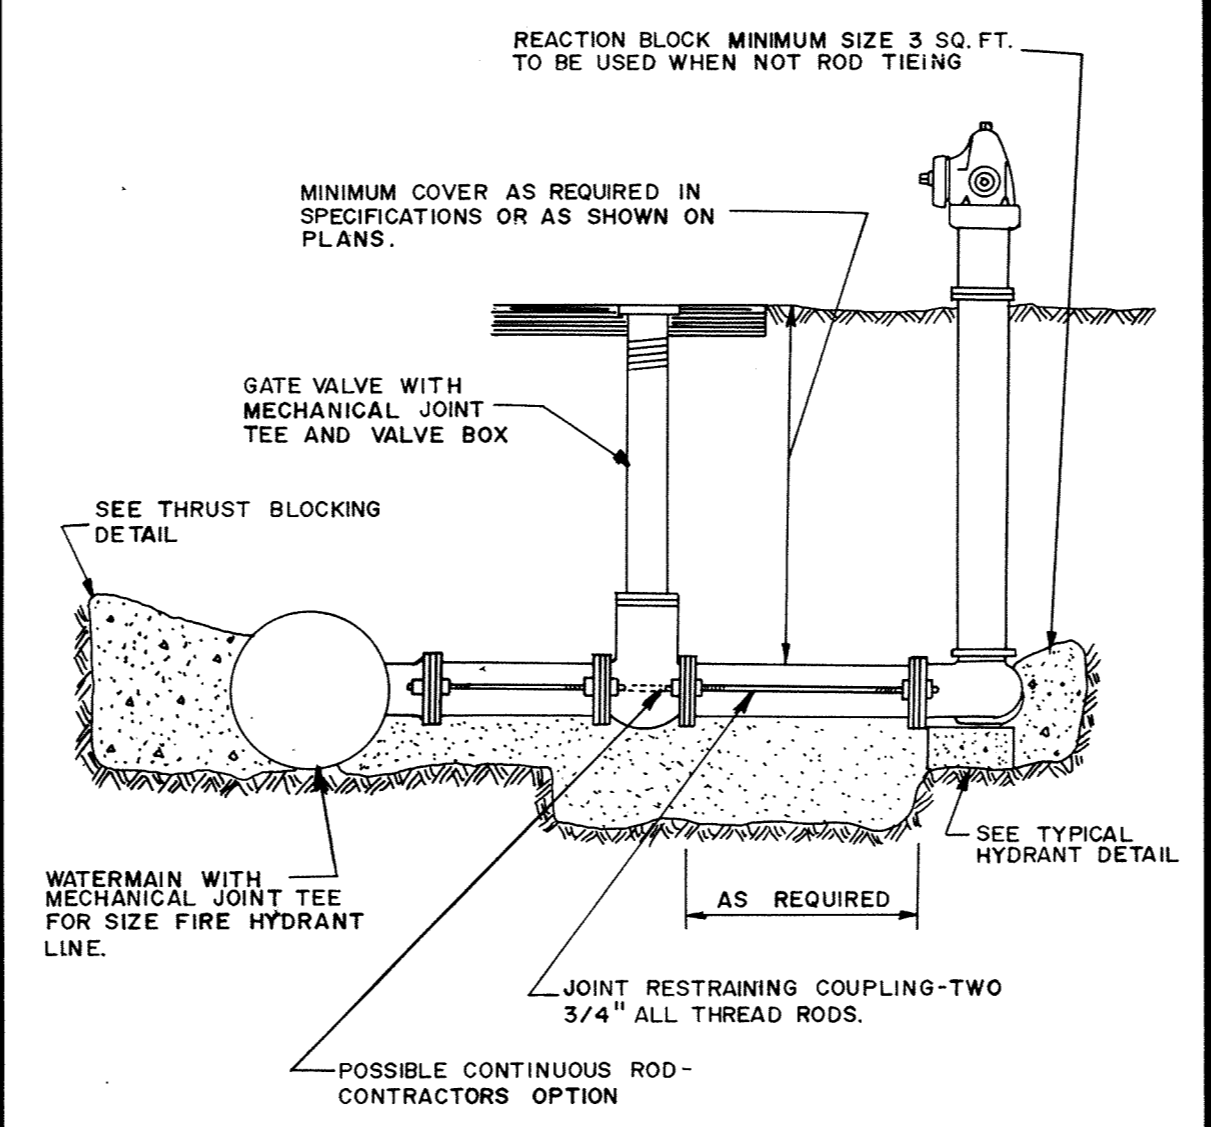

CLASS C PIPE BEDDING

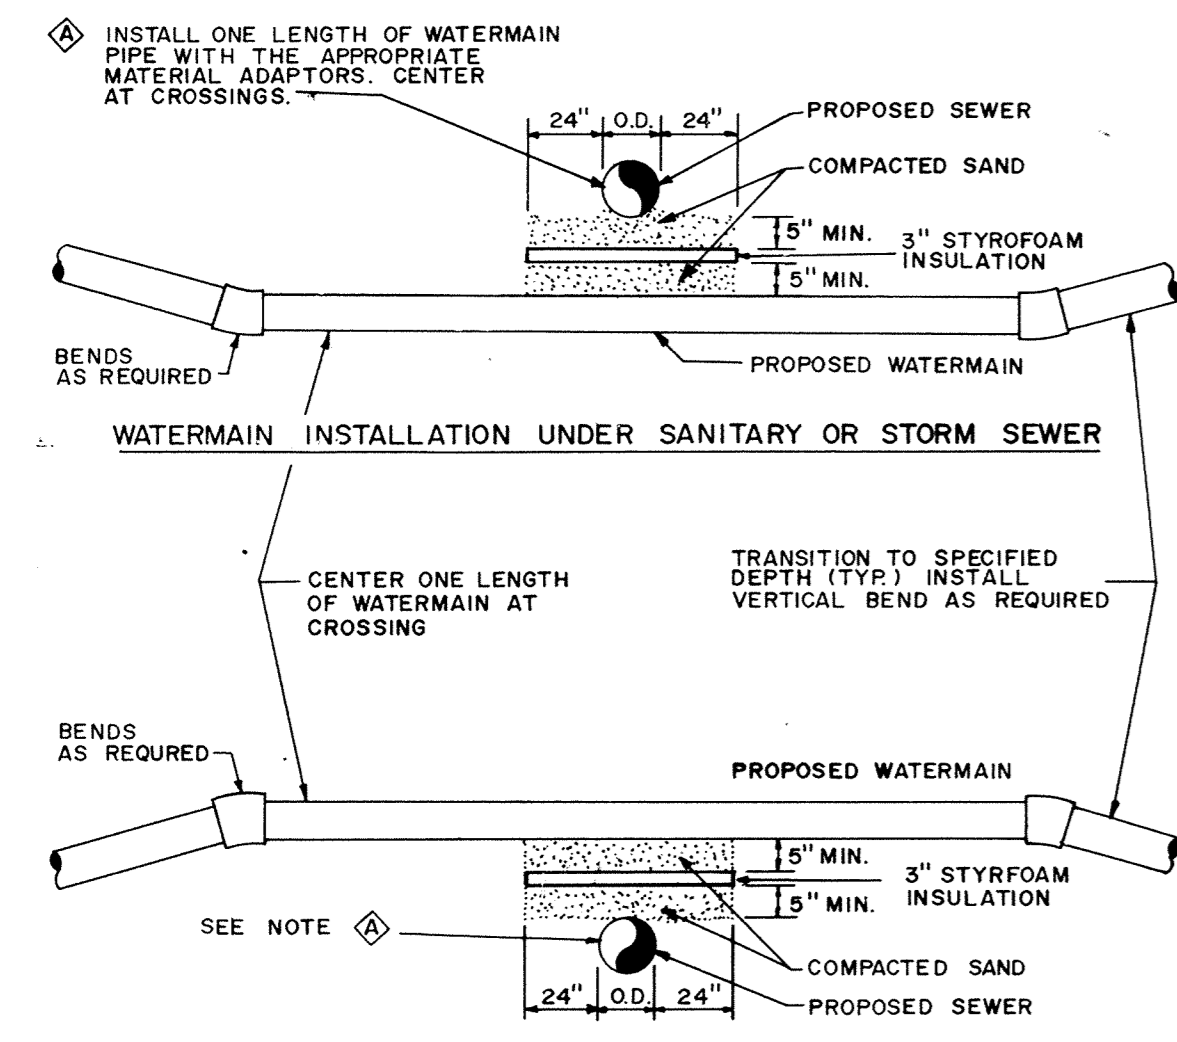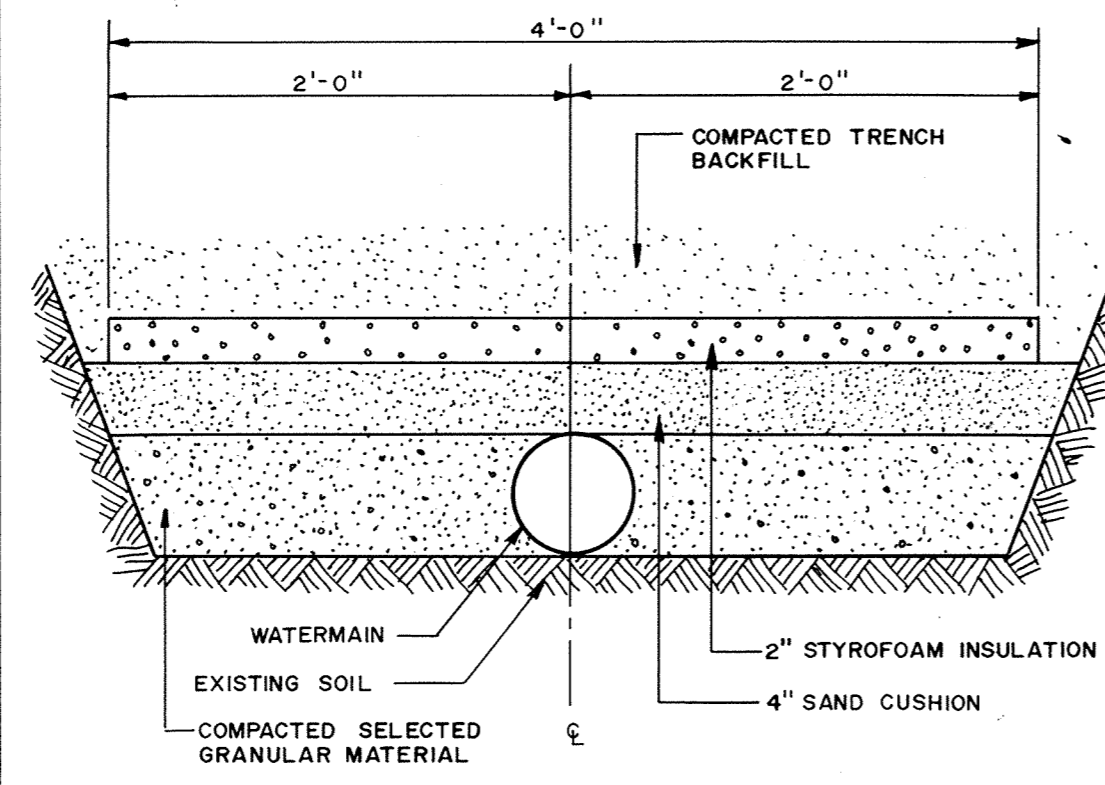

- NOTES:
1. WHEN WATERMAIN AND SANITARY SEWER CROSSINGS HAVE LESS THAN 18" VERTICAL SEPARATION, INSTALL CROSSING AS SHOWN.
 2. WHEN WATERMAIN COVER IS LESS THAN 7.5 FEET, INSTALL WATERMAIN UNDER SANITARY SEWER.

WATERMAIN CROSSING

PIPE INSULATION DETAIL

RODDING DETAIL

TYPICAL SERVICE DETAIL

RECORD PLAN NOV. 1988

TYPICAL HYDRANT DETAIL

Maier Stewart & Associates Inc.
CONSULTING ENGINEERS
1959 SLOAN PLACE (612) 774-6021 ST. PAUL, MINNESOTA 55117

DATE	DESCRIPTION	DESIGNED

REVISIONS

CITY OF ELK RIVER
WATERMAIN DETAILS
DATE SEPT 1987 SHEET 26 OF 28 SHEETS PROJECT NO. 230-032