
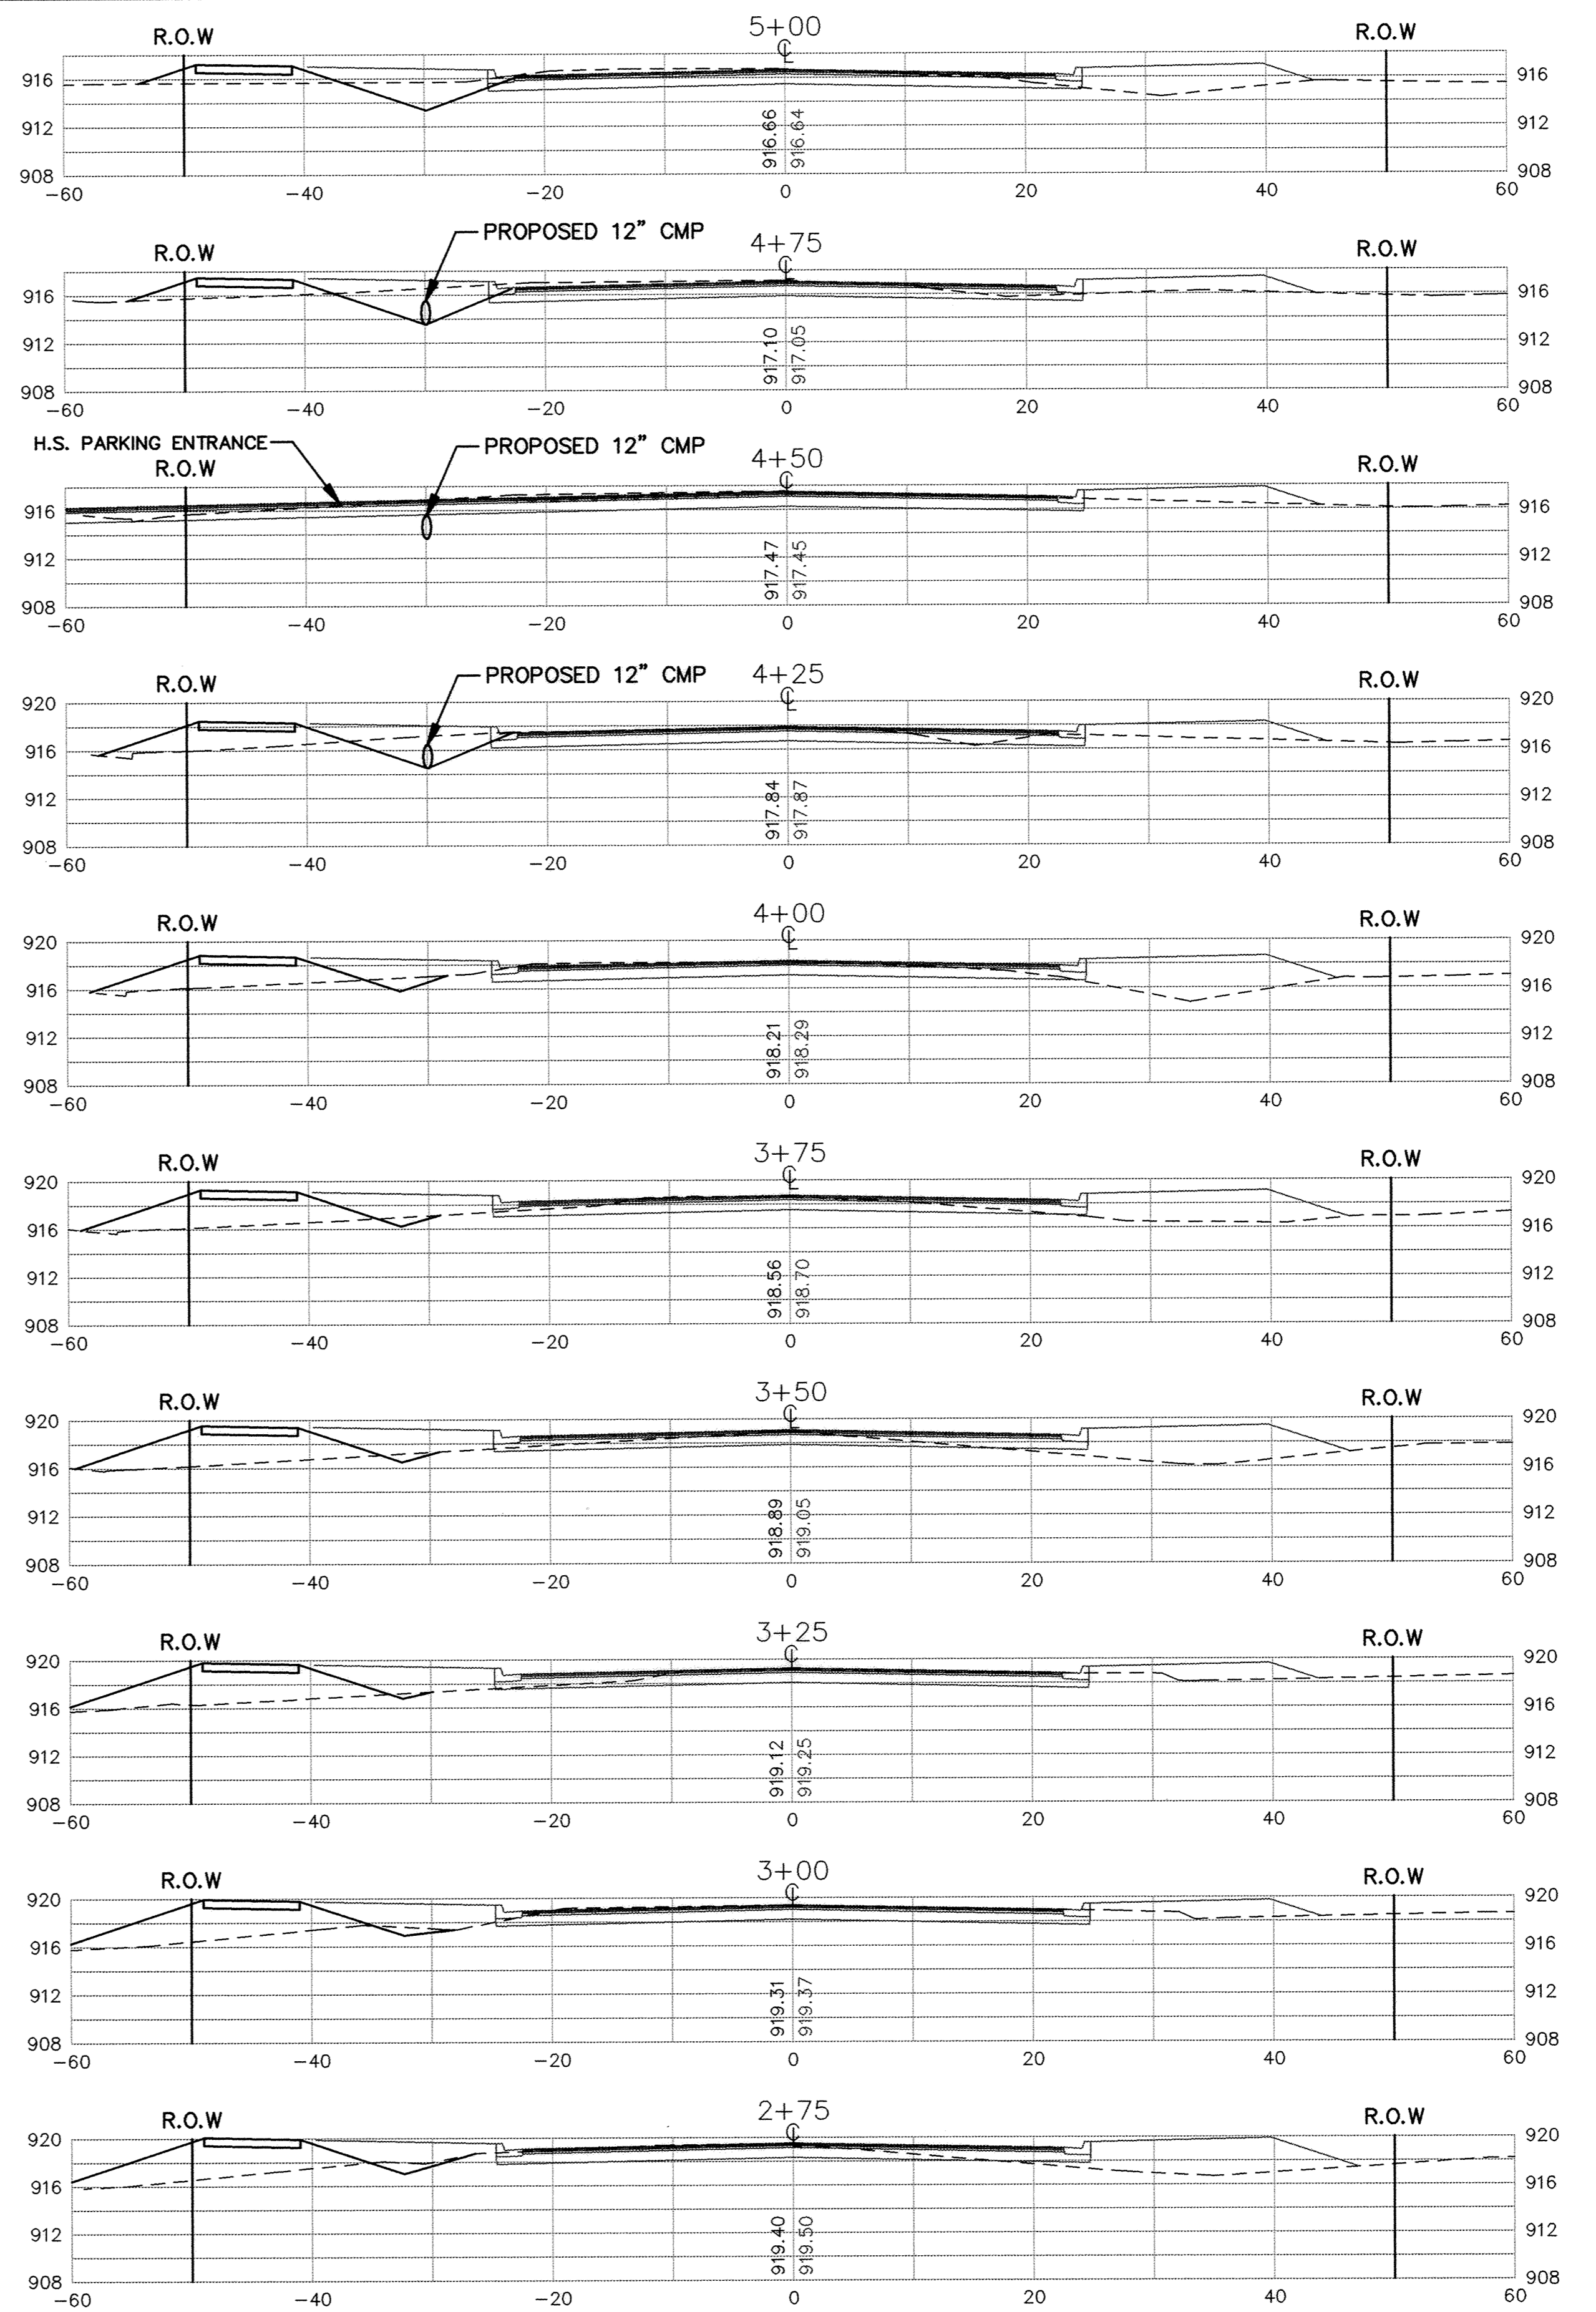


SDCO PRODUCTS • NEW HOPE, MINNESOTA  
REORDER BY PART NUMBER 8252  
SDCO PRODUCTS • NEW HOPE, MINNESOTA  
REORDER BY PART NUMBER 8252  
SDCO PRODUCTS • NEW HOPE, MINNESOTA  
REORDER BY PART NUMBER 8252  
SDCO PRODUCTS • NEW HOPE, MINNESOTA  
REORDER BY PART NUMBER 8252

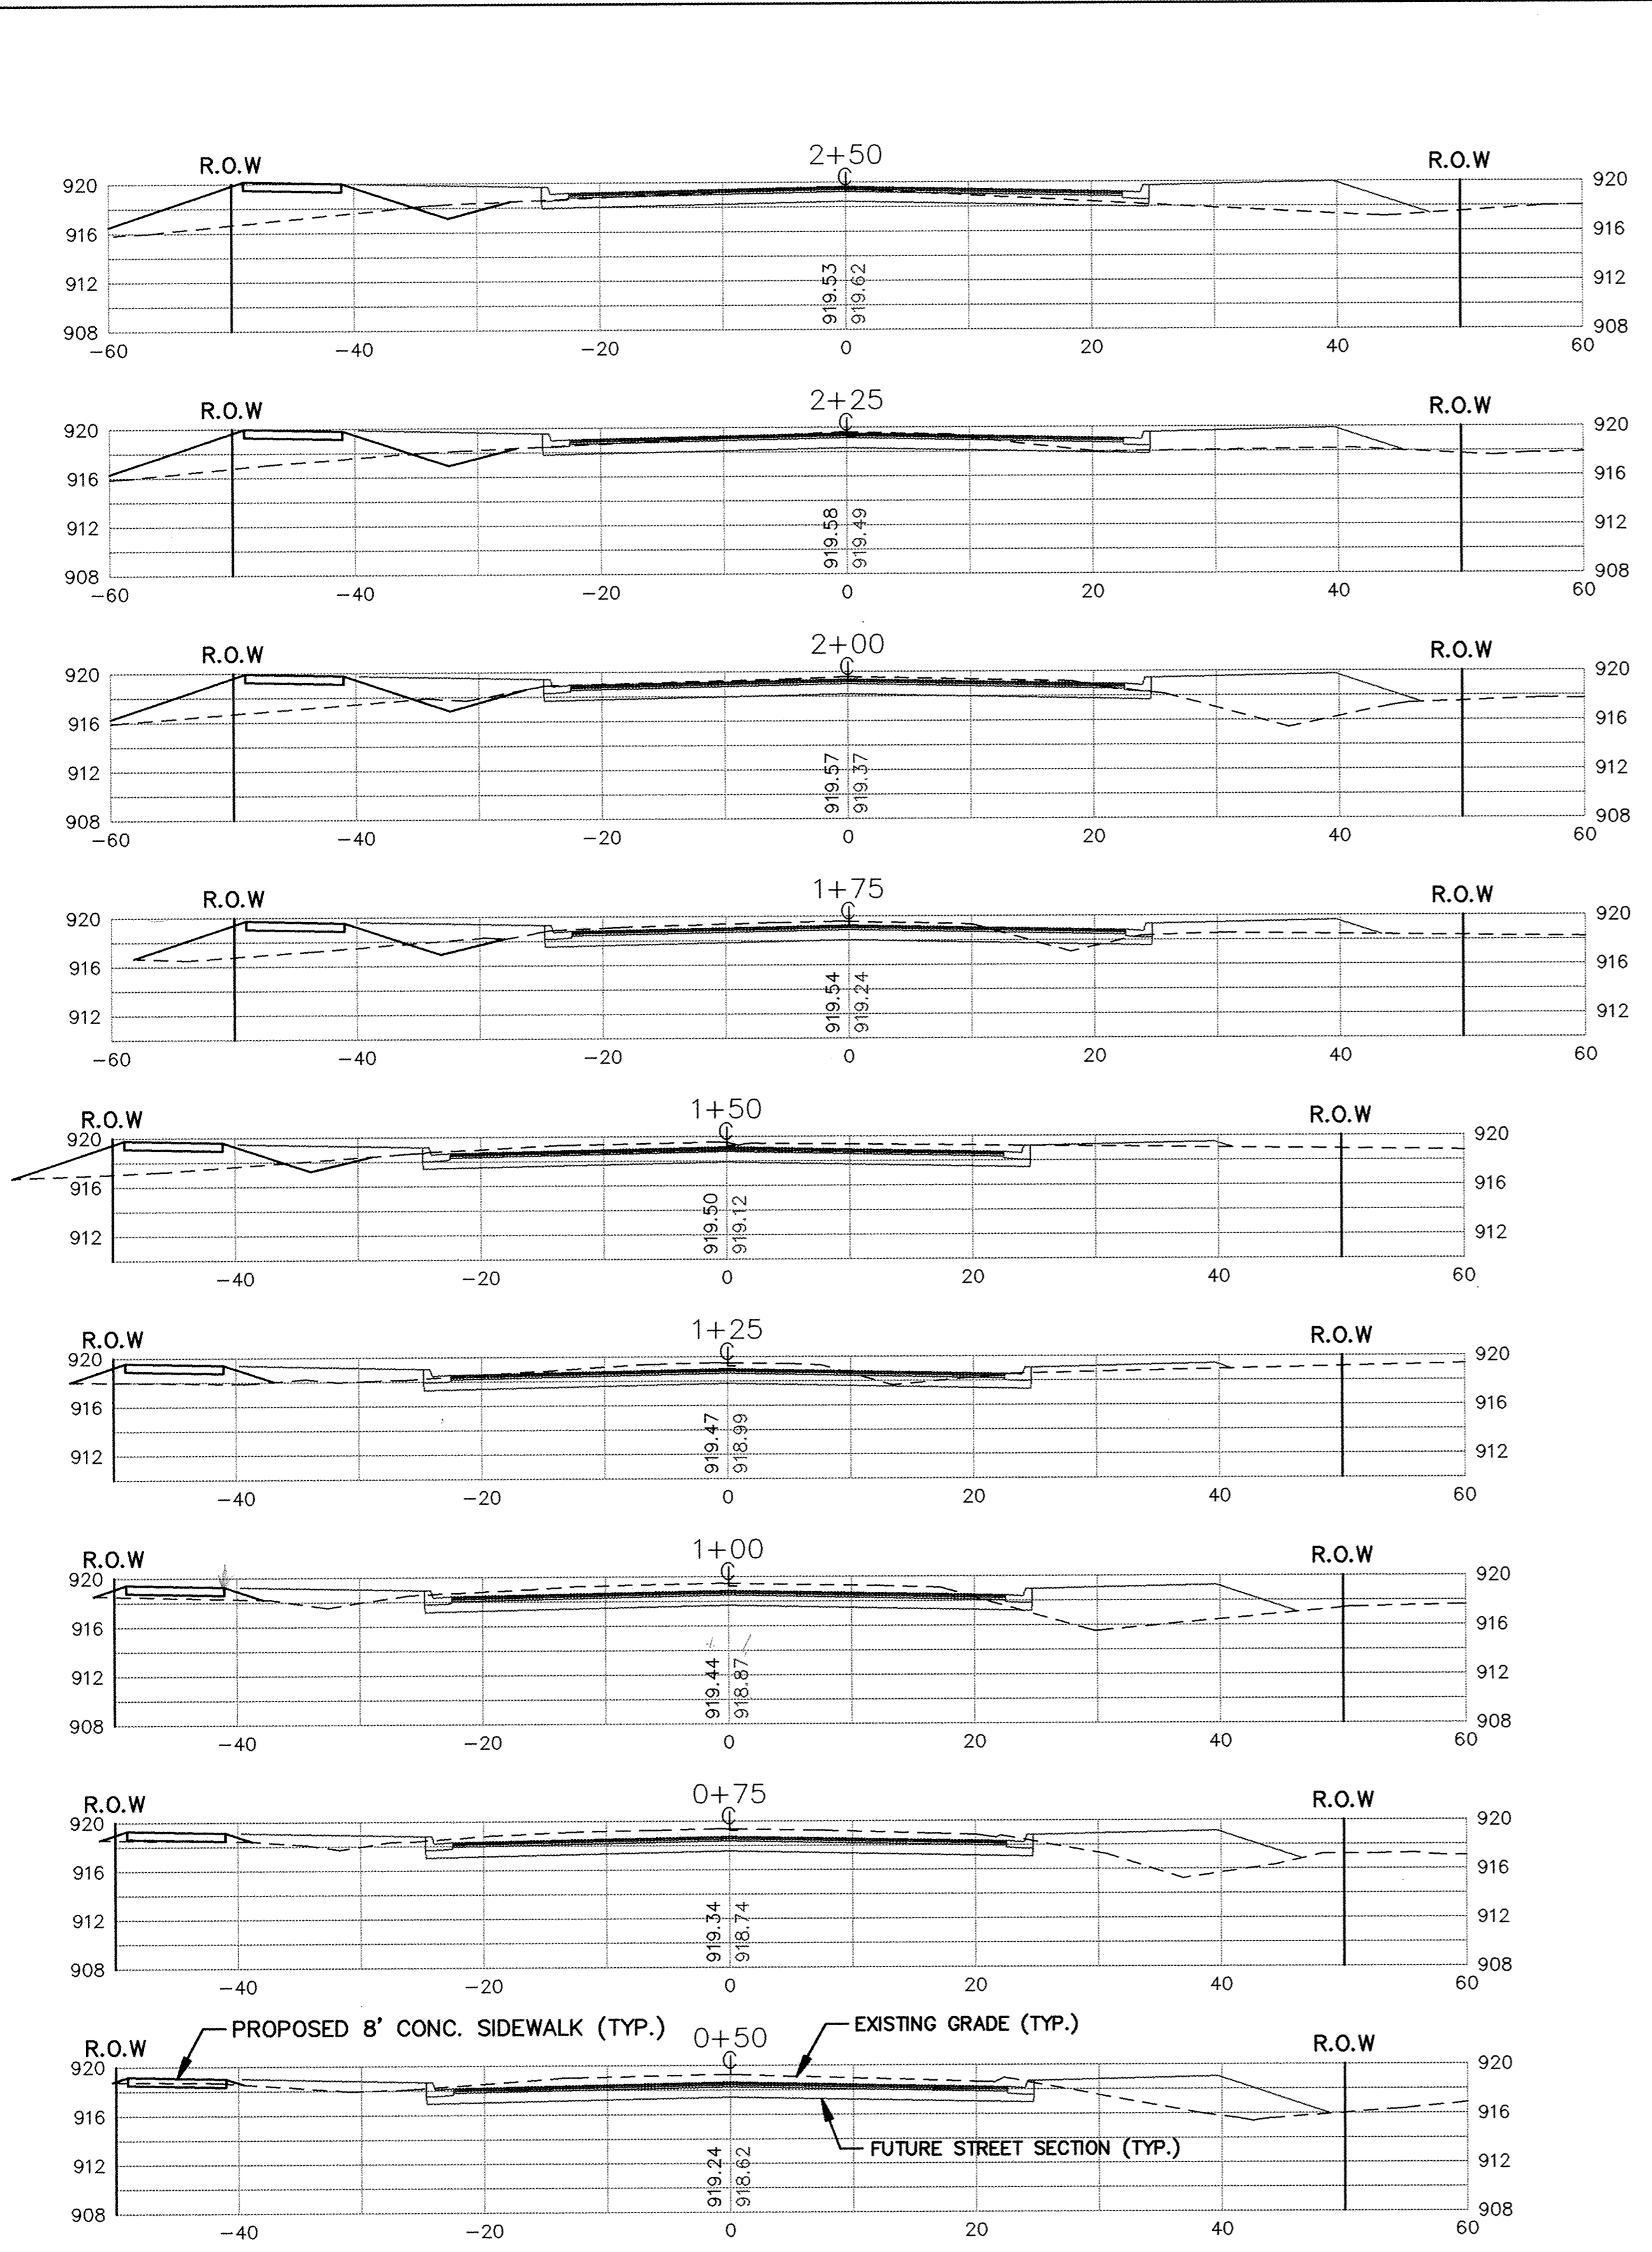

**RECORD PLAN**  
**SEPT. 1994**

I HEREBY CERTIFY THAT THIS PLAN, SPECIFICATION, OR REPORT WAS PREPARED BY ME OR UNDER MY DIRECT SUPERVISION AND THAT I AM A DULY REGISTERED PROFESSIONAL ENGINEER UNDER THE LAWS OF THE STATE OF MINNESOTA.

*Mark J. Abraham*  
DATE 9/17/93 REG. NO. 19130

**MS&A** CONSULTING ENGINEERS  
**Maier Stewart & Associates Inc.**

1959 SLOAN PLACE (612) 774-6021 ST. PAUL, MINNESOTA 55117  
9800 SHELARD PARKWAY (612) 546-0432 MINNEAPOLIS, MINNESOTA 55441

DATE	DESCRIPTION	DESIGNED	GG
		CHECKED	MJG
		DRAWN	GG
REVISIONS		GRAPHIC SCALE	
		0 HORIZ.	10
		0 VERT.	5

CITY OF ELK RIVER			
S.A.P. 204-104-05			
JACKSON AVENUE SIDEWALK			
CROSS SECTIONS			
DATE	SEPT. 1993	SHEET	4 OF 6 SHEETS
PROJECT NO.	230-175		