
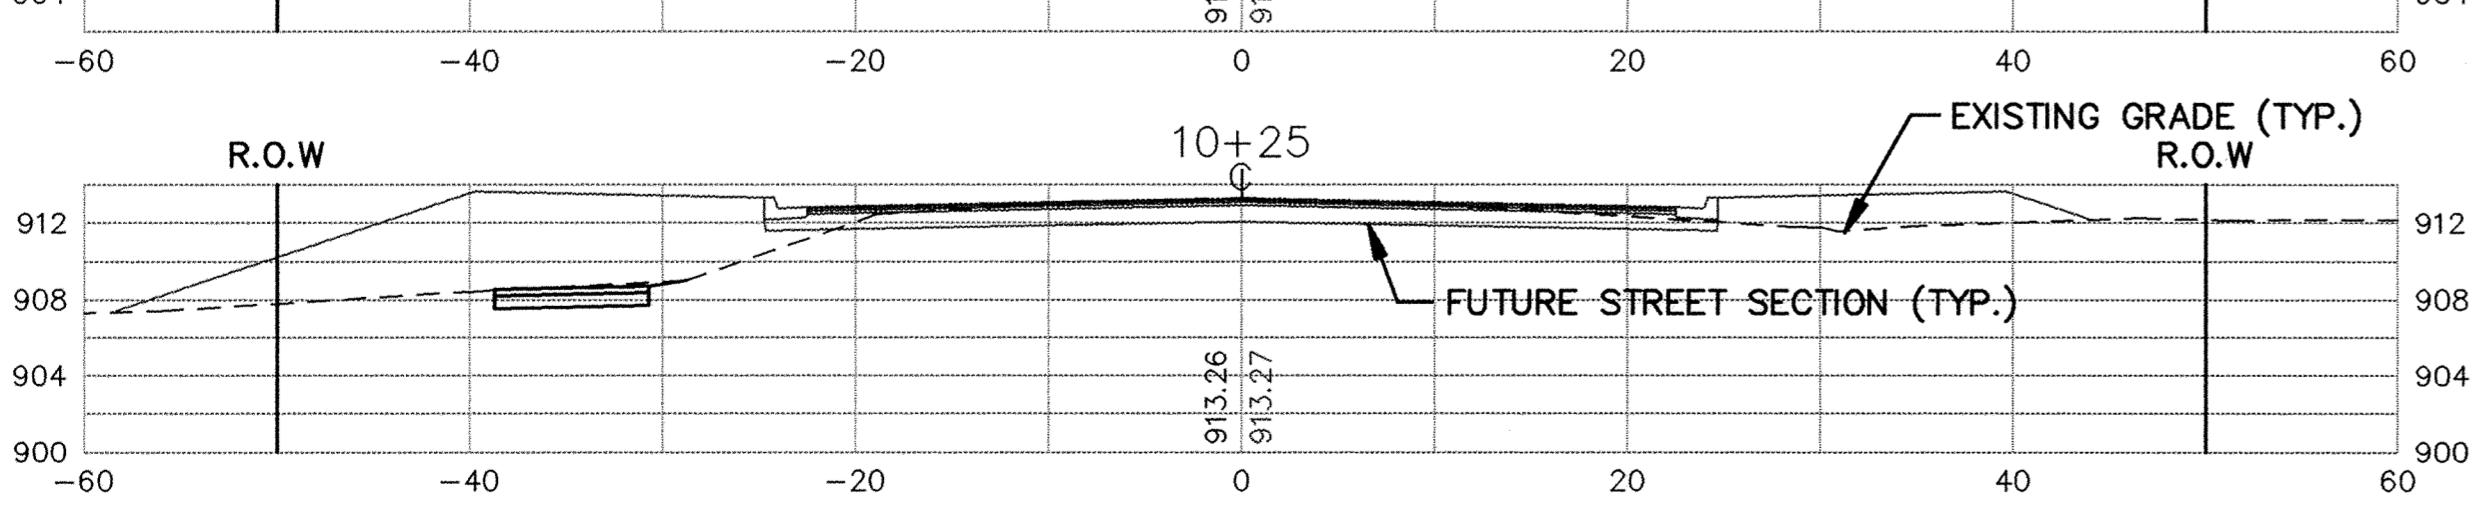
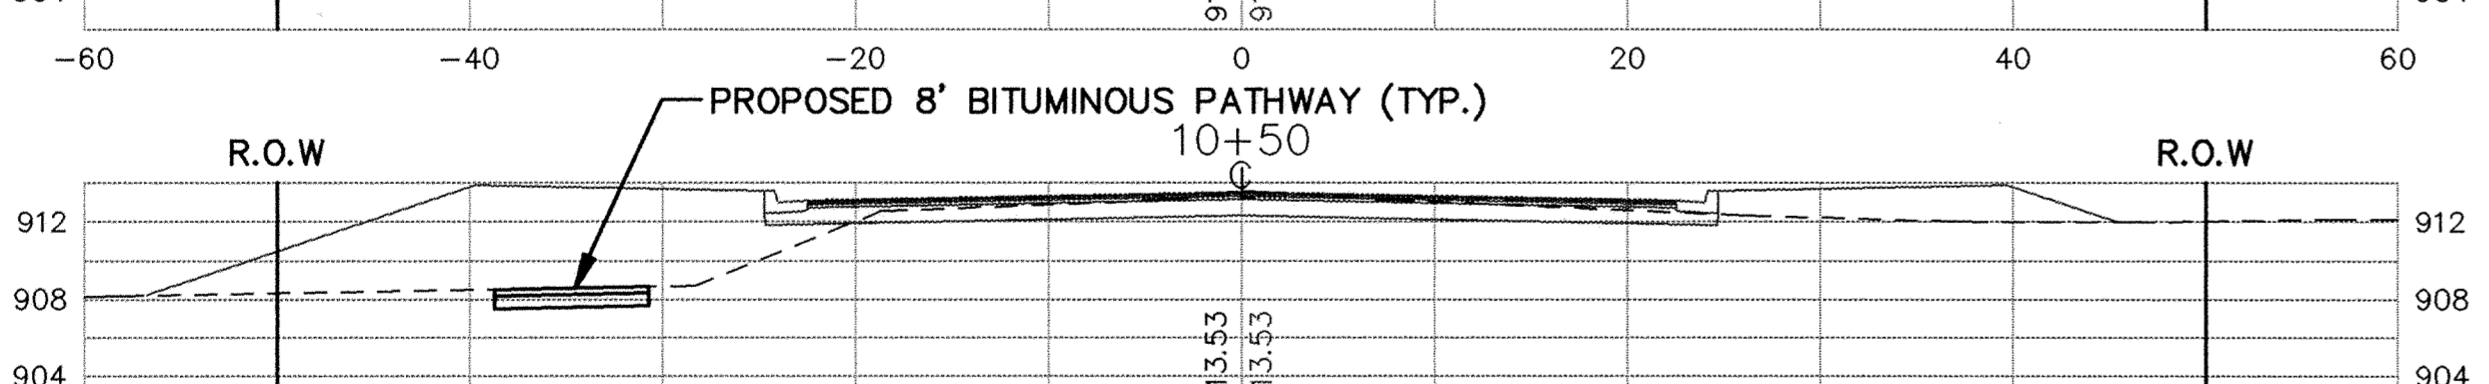
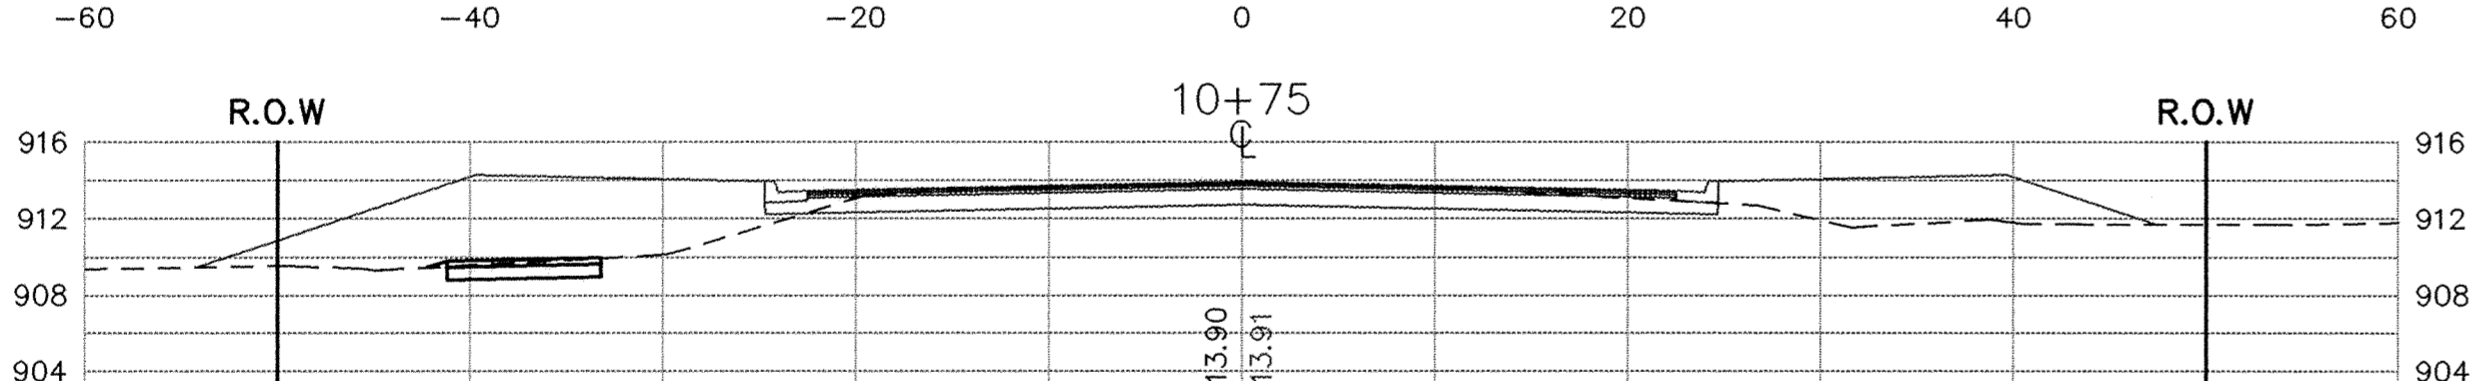
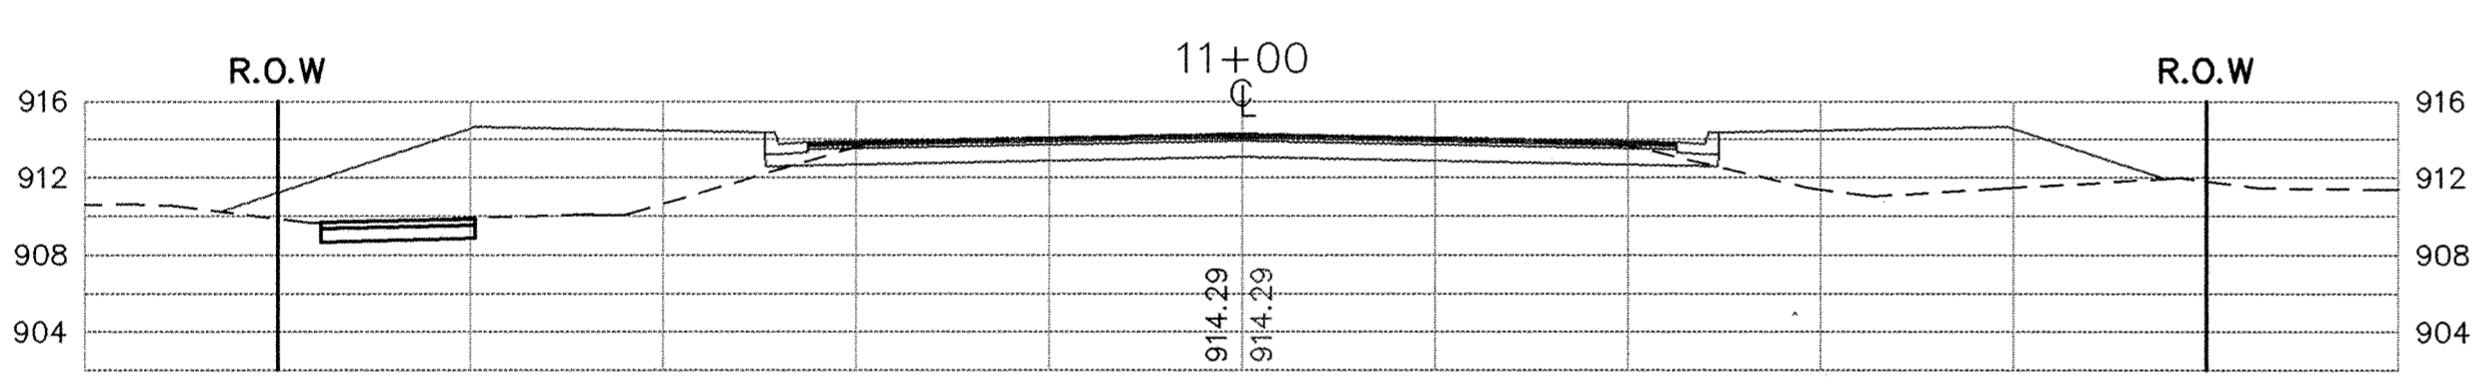
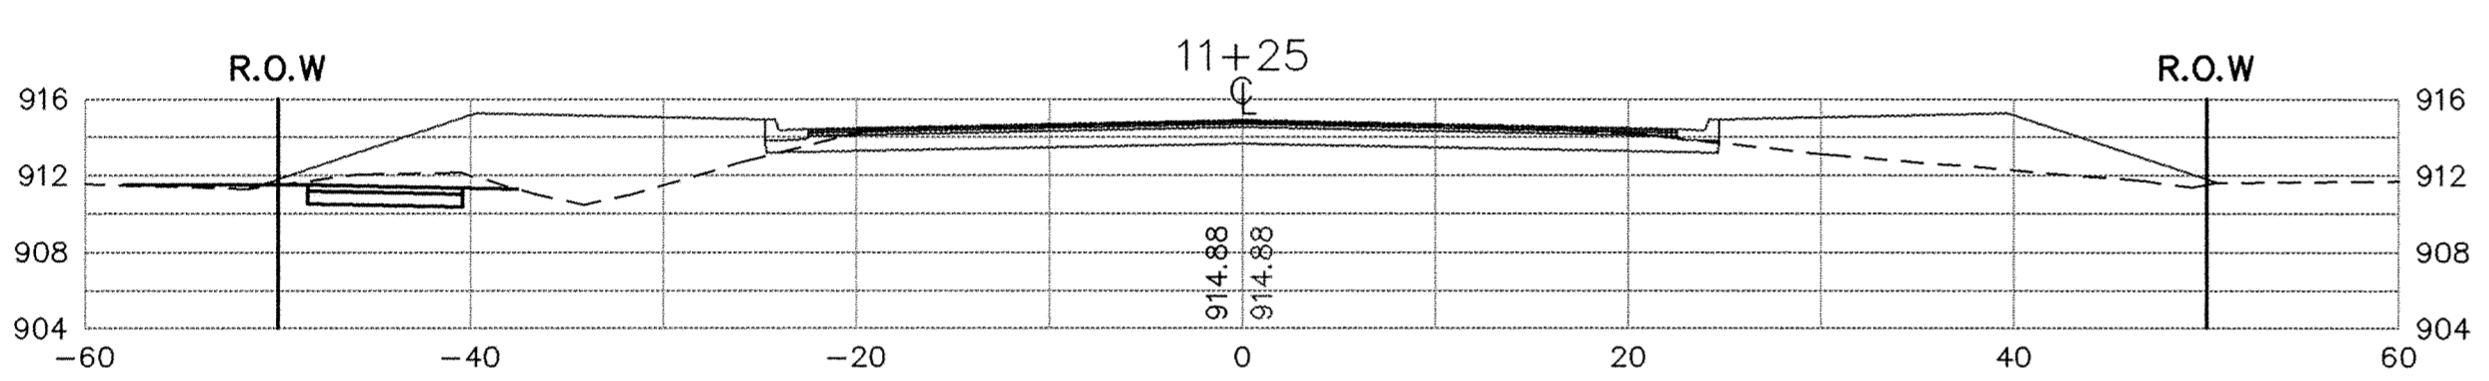
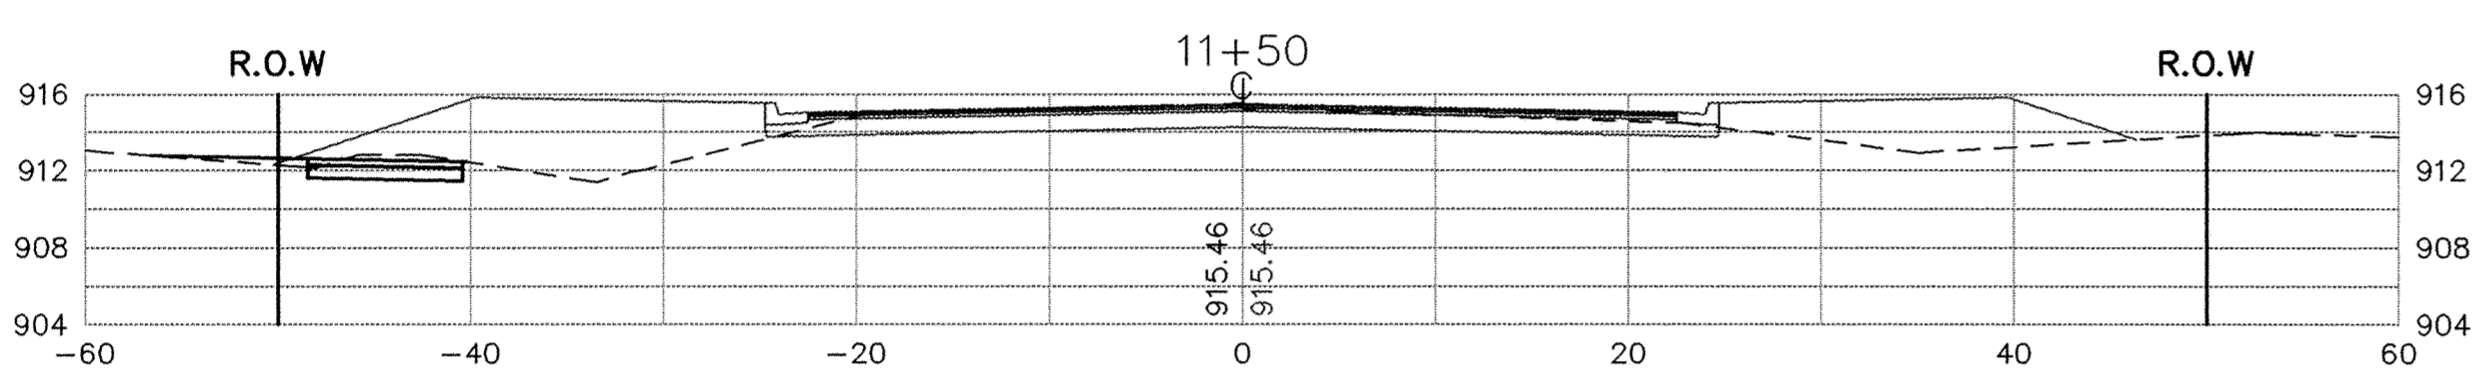
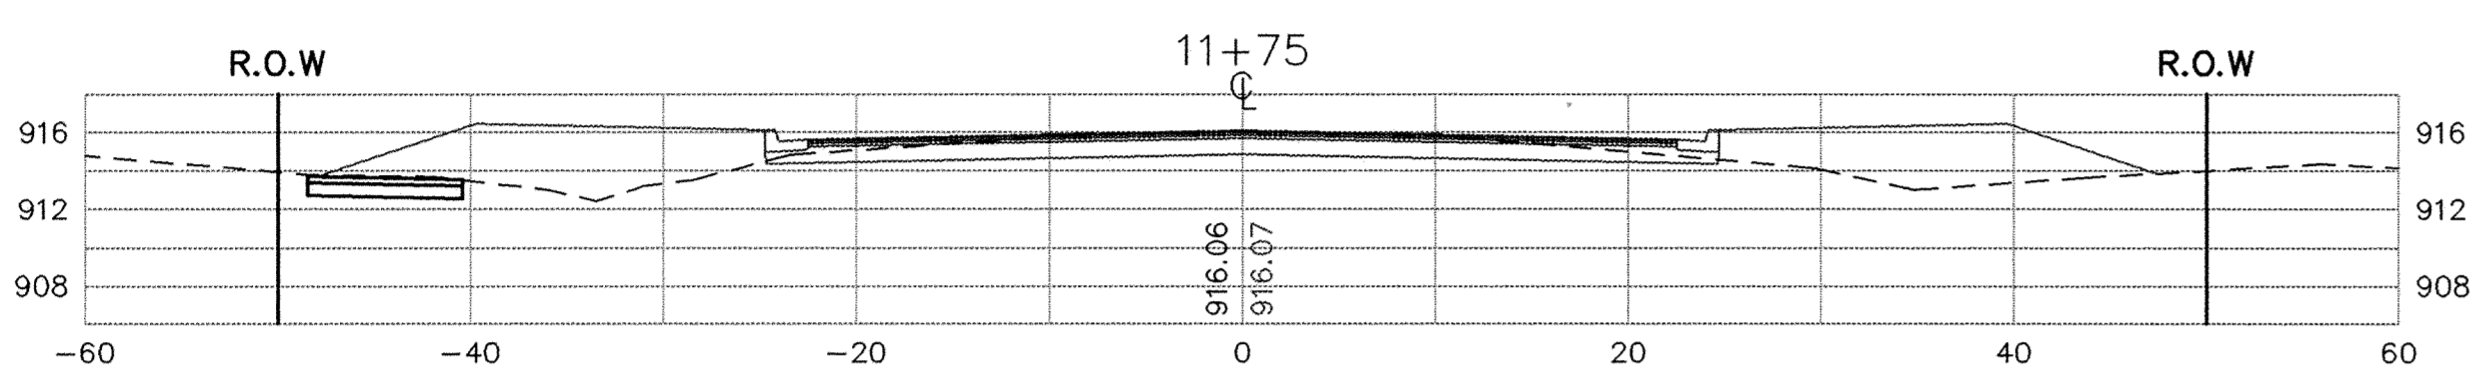
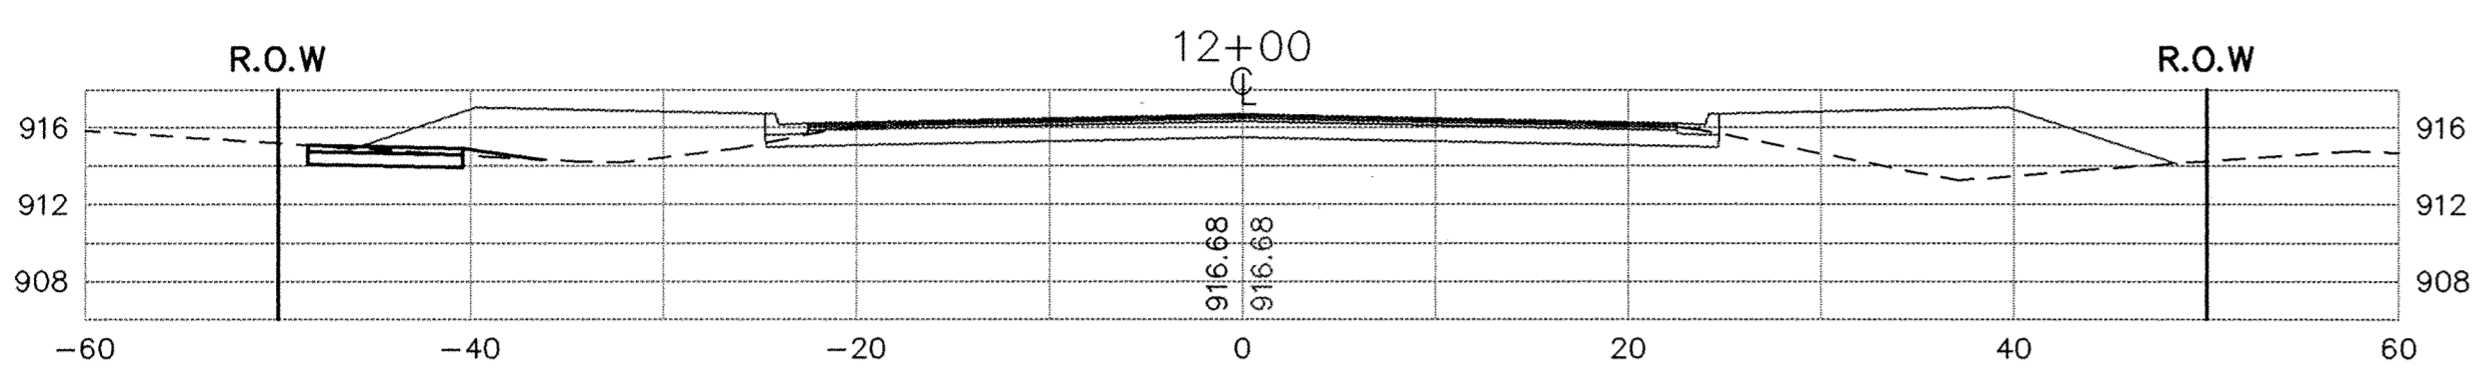


SAECO PRODUCTS • NEW HOPK, MINNESOTA
REVISION BY PART NUMBER 6532

SAECO PRODUCTS • NEW HOPK, MINNESOTA
REVISION BY PART NUMBER 6532

SAECO PRODUCTS • NEW HOPK, MINNESOTA
REVISION BY PART NUMBER 6532

SAECO PRODUCTS • NEW HOPK, MINNESOTA
REVISION BY PART NUMBER 6532

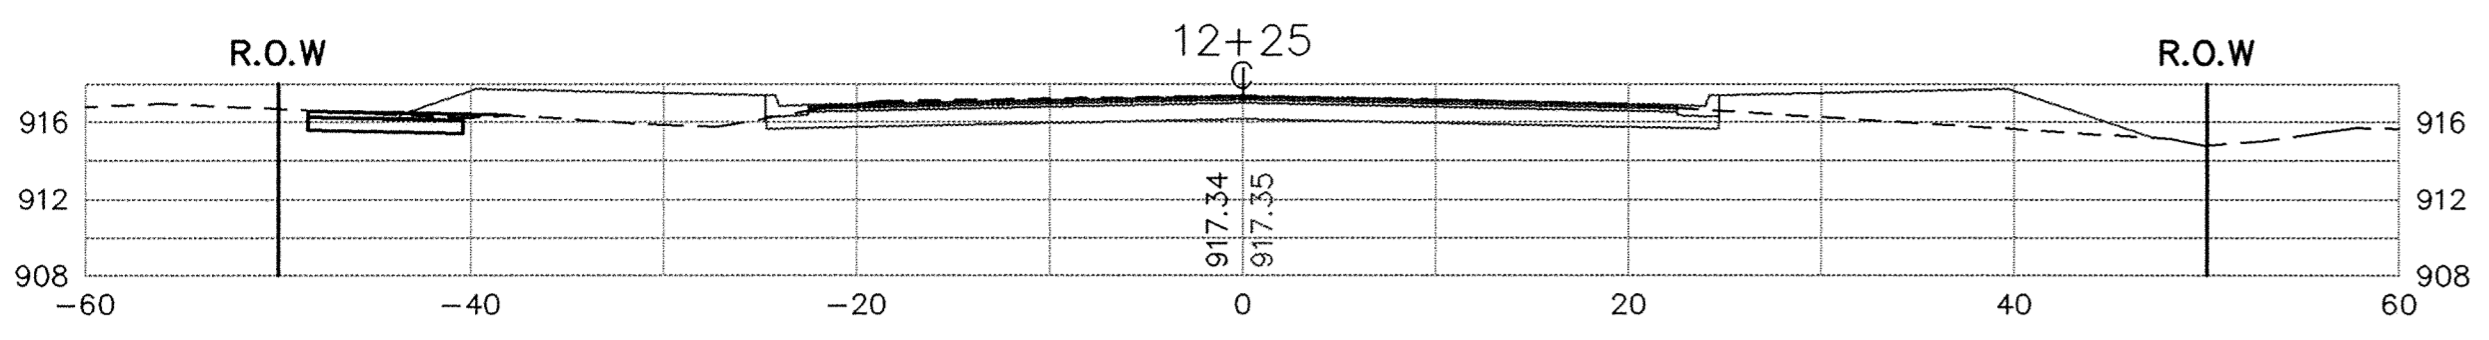

RECORD PLAN
SEPT. 1994

CITY OF ELK RIVER
S.A.P. 204-104-05
JACKSON AVENUE SIDEWALK
CROSS SECTIONS

DATE SEPT. 1993 SHEET 6 OF 6 SHEETS PROJECT NO. 230-175

DESIGNED	GG
CHECKED	MJG
DRAWN	GG
GRAPHIC SCALE	
0	HORIZ. 10
0	VERT. 5

REVISIONS	DATE	DESCRIPTION

Maier Stewart & Associates Inc. CONSULTING ENGINEERS
 1959 SLOAN PLACE (612) 774-6021 ST. PAUL, MINNESOTA 55117
 9800 SHELARD PARKWAY (612) 546-0432 MINNEAPOLIS, MINNESOTA 55441

I HEREBY CERTIFY THAT THIS PLAN, SPECIFICATION, OR REPORT WAS PREPARED BY ME OR UNDER MY DIRECT SUPERVISION AND THAT I AM A DULY REGISTERED PROFESSIONAL ENGINEER UNDER THE LAWS OF THE STATE OF MINNESOTA.
Mark J. Shabans
 DATE 9/17/93 REG. NO. 19130