


\* FOR WATER SERVICE REPAIRS  
SEE TABULATION IN FILE

NO.	DATE	BY	DESCRIPTION

I HEREBY CERTIFY THAT THIS PLAN, SPECIFICATION, OR REPORT WAS PREPARED BY ME OR UNDER MY DIRECT SUPERVISION AND THAT I AM A DULY LICENSED PROFESSIONAL ENGINEER UNDER THE LAWS OF THE STATE OF MINNESOTA.  
 Print Name: JOHN M. ANDERSON  
 Signature: *[Signature]*  
 Date: 06-10-09 License # 25889

EXISTING CONCRETE DRIVEWAY/SIDEWALK  
 EXISTING BITUMINOUS  
 REMOVE AND REPLACE CONCRETE SIDEWALK  
 NEW CONCRETE SIDEWALK  
 RECLAIM AND REPAVE BITUMINOUS STREET

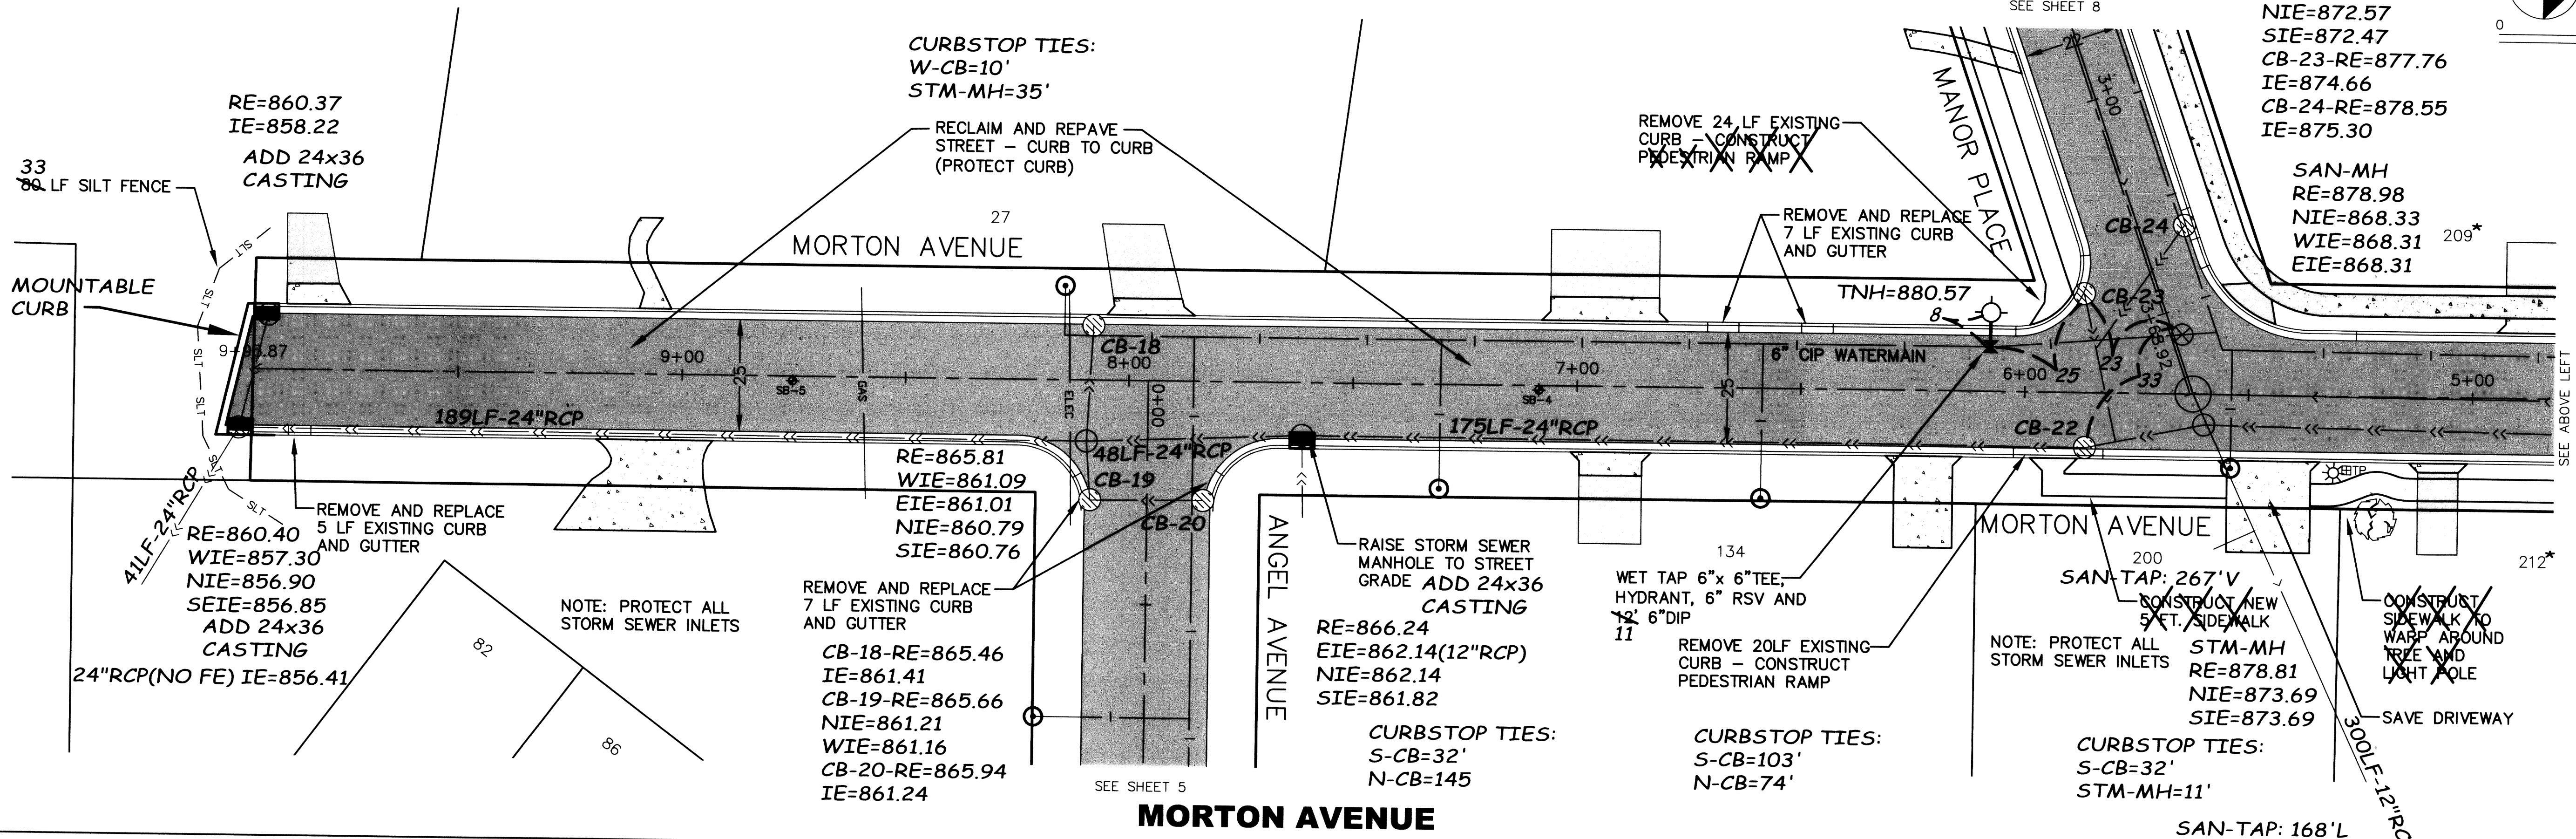

**CITY OF ELK RIVER  
 KING LOWELL MORTON NORFOLK AREA  
 STREET IMPROVEMENTS  
 MORTON AVENUE  
 RECORD PLAN**

**City of Elk River**  
 13065 Orono Parkway  
 Elk River, MN 55330  
 Phone: (763) 835-1052  
 Fax: (763) 835-1090

DRAWN BY: JBK  
 CHECKED BY: JMA  
 DESIGNED BY: JMA  
 JOB NO. 226214

SHEET **6** SHEETS **10**