


OLSON CIRCLE

RECORD PLAN

CONTRACTOR: RANDY KRAMER

DEVELOPER: DENNIS T. WURM

OBLIQUE TEXT DENOTES AS BUILT CHANGES

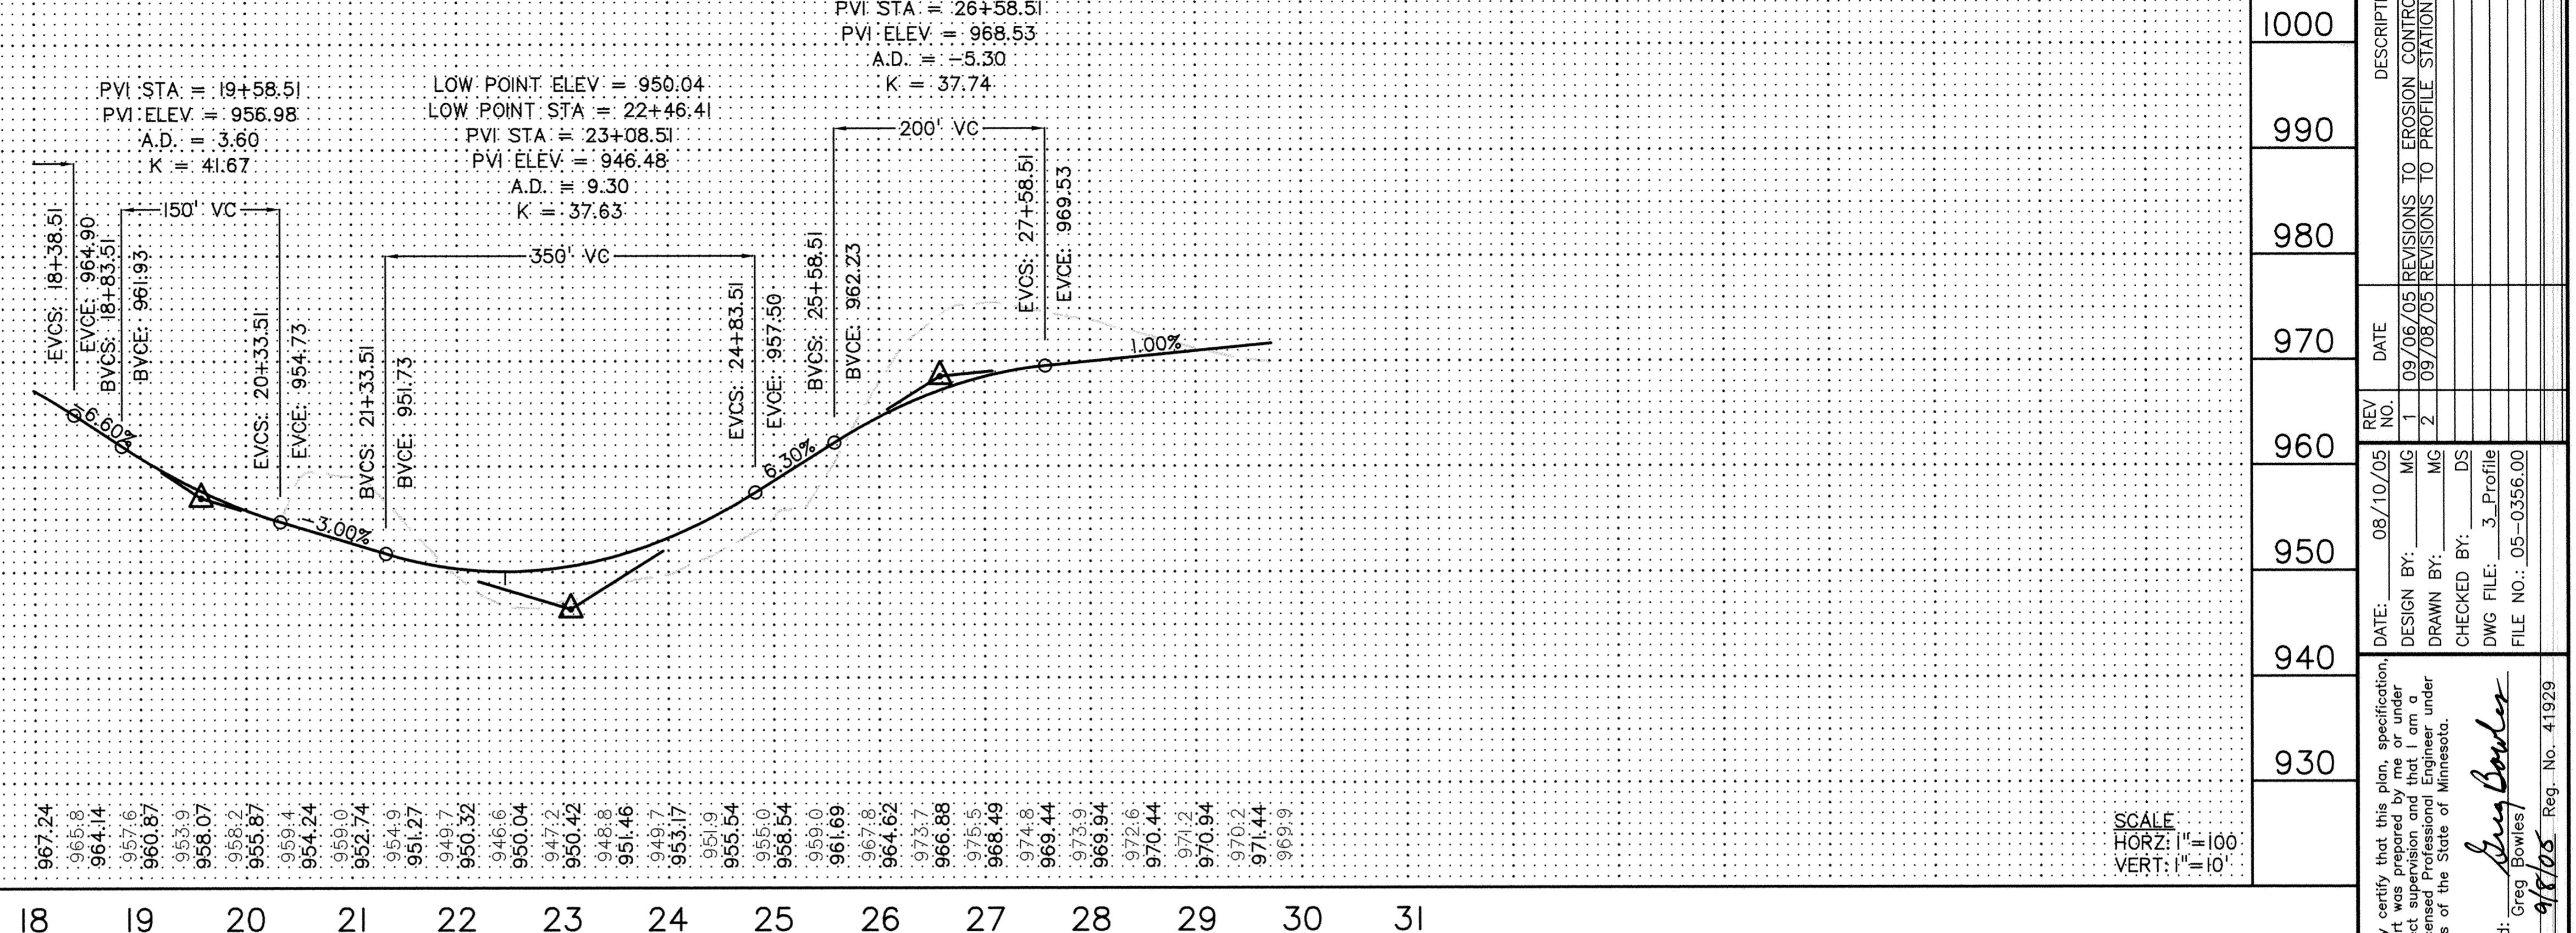

E
Z: I"=100
T: I"=10'

KINGDOM ESTATES 2ND ADD.	
City of Elk River, Mn.	
Dennis T. Wurm	
Street Profile	
SHEET NO.	3
6	

DRAWING NUMBER
KINGDE2.06
3

SAFCO PRODUCTS • NEW HOPE, MINNESOTA

SAFCO PRODUCTS • NEW HOPE, MINNESOTA

SAFCO PRODUCTS • NEW HOPE, MINNESOTA

AFCO PRODUCTS • NEW HOPE, MINN.