


# OLSON CIRCLE

**RECORD PLAN**  
**CONTRACTOR: RANDY KRAMER**  
**DEVELOPER: DENNIS T. WURM**  
**OBIQUE TEXT DENOTES AS BUILT CHANGES**

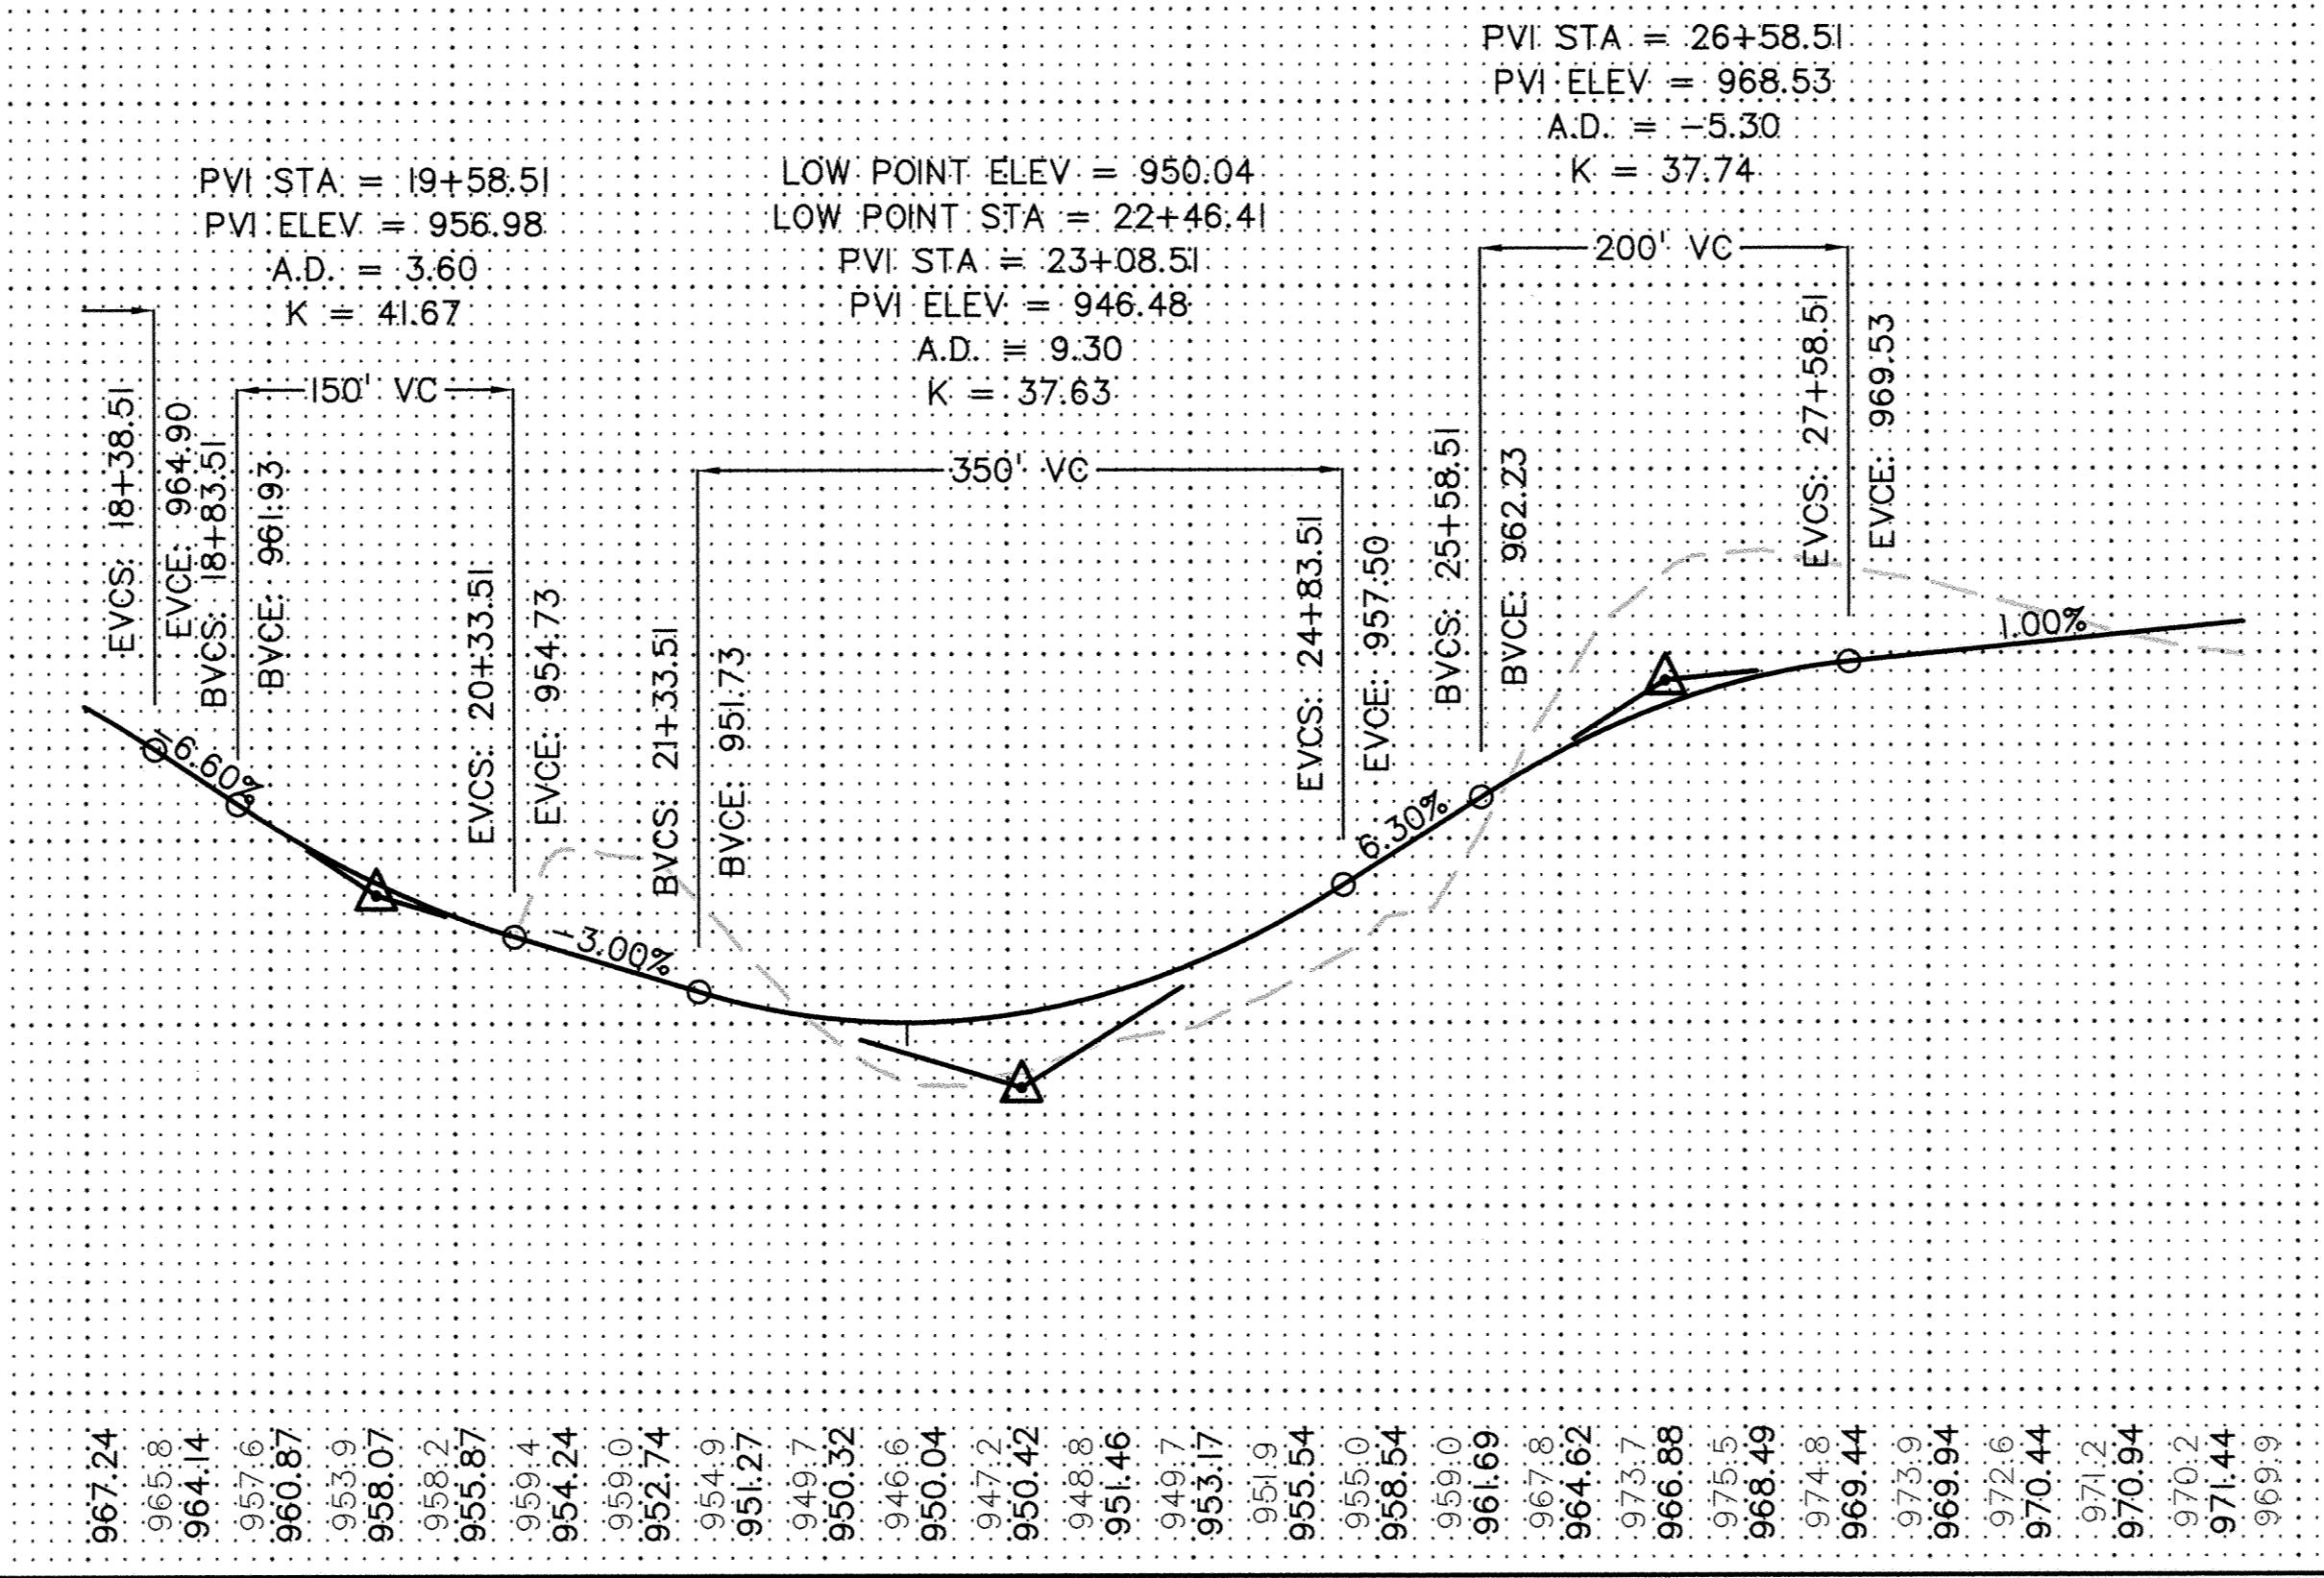

18 19 20 21 22 23 24 25 26 27 28 29 30 31

1020	1010	1000	0
------	------	------	-----	-----	----	----	----	----	----	----	----	----	----	---

SCALE:  
HORZ: 1"=100'  
VERT: 1"=10'

Dated: 11/11/99 Reg. No. 19900

Signed: Ton Bogart

Checked by: DS

Design By: MG

Date: 08/10/05

Rev. No. 1

Date: 09/06/05

Rev. No. 2

Date: 09/09/05

Rev. No. 3

Date: 12/22/05

Rev. No. 4

Date: 12/22/05

Rev. No. 5

Date: 12/22/05

Rev. No. 6

Date: 12/22/05

Rev. No. 7

Date: 12/22/05

Rev. No. 8

Date: 12/22/05

Rev. No. 9

Date: 12/22/05

Rev. No. 10

Date: 12/22/05

Rev. No. 11

Date: 12/22/05

Rev. No. 12

Date: 12/22/05

Rev. No. 13

Date: 12/22/05

Rev. No. 14

Date: 12/22/05

Rev. No. 15

Date: 12/22/05

Rev. No. 16

Date: 12/22/05

Rev. No. 17

Date: 12/22/05

Rev. No. 18

Date: 12/22/05

Rev. No. 19

Date: 12/22/05

Rev. No. 20

Date: 12/22/05

Rev. No. 21

Date: 12/22/05

Rev. No. 22

Date: 12/22/05

Rev. No. 23

Date: 12/22/05

Rev. No. 24

Date: 12/22/05

Rev. No. 25

Date: 12/22/05

Rev. No. 26

Date: 12/22/05

Rev. No. 27

Date: 12/22/05

Rev. No. 28

Date: 12/22/05

Rev. No. 29

Date: 12/22/05

Rev. No. 30

Date: 12/22/05

Rev. No. 31

Date: 12/22/05

Rev. No. 32

Date: 12/22/05

Rev. No. 33

Date: 12/22/05

Rev. No. 34

Date: 12/22/05

Rev. No. 35

Date: 12/22/05

Rev. No. 36

Date: 12/22/05

Rev. No. 37

Date: 12/22/05

Rev. No. 38

Date: 12/22/05

Rev. No. 39

Date: 12/22/05

Rev. No. 40

Date: 12/22/05

Rev. No. 41

Date: 12/22/05

Rev. No. 42

