


MULTIFAMILY SERVICE DATA				
BLOCK NUMBER	LOT NUMBER	STATION	RISER	C.S.
3	1	1+98	2.5	900.9
3	2	1+44	2.5	901.3
3	3	1+41	2.5	901.4
3	4	0+85	2.3 RT	901.7
3	5	0+61	2.6 RT	901.9
3	6	0+11	2.7 LT	901.5
3	7	0+07	3.0 RT	901.6
3	8	1+06	3.0 RT	901.9
2	21	0+96	3.1 RT	902.4
2	22	1+48	3.2 LT	902.0
2	23	1+51	3.2 LT	901.9
2	24	0+50	3.9 RT	901.7

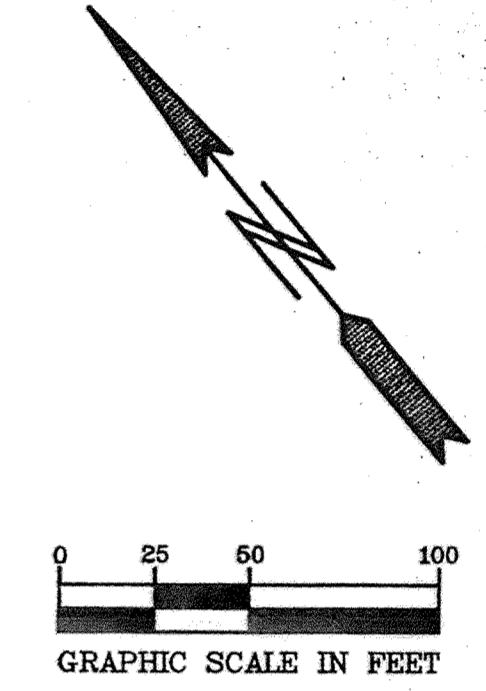


BENCHMARKS

DOUBLE SPIKE EAST FACE OF POWER POLE, WEST SIDE OF FILLMORE STREET N.W., 50± FT. SOUTH OF 178TH AVENUE N.W. ELEVATION = 897.82 FT.

TRIPLE SPIKE EAST FACE OF POWER POLE, NW QUADRANT OF FILLMORE STREET AND 175TH AVENUE N.W. ELEVATION = 909.73 FT.

180TH LANE NW / 180TH COURT NW

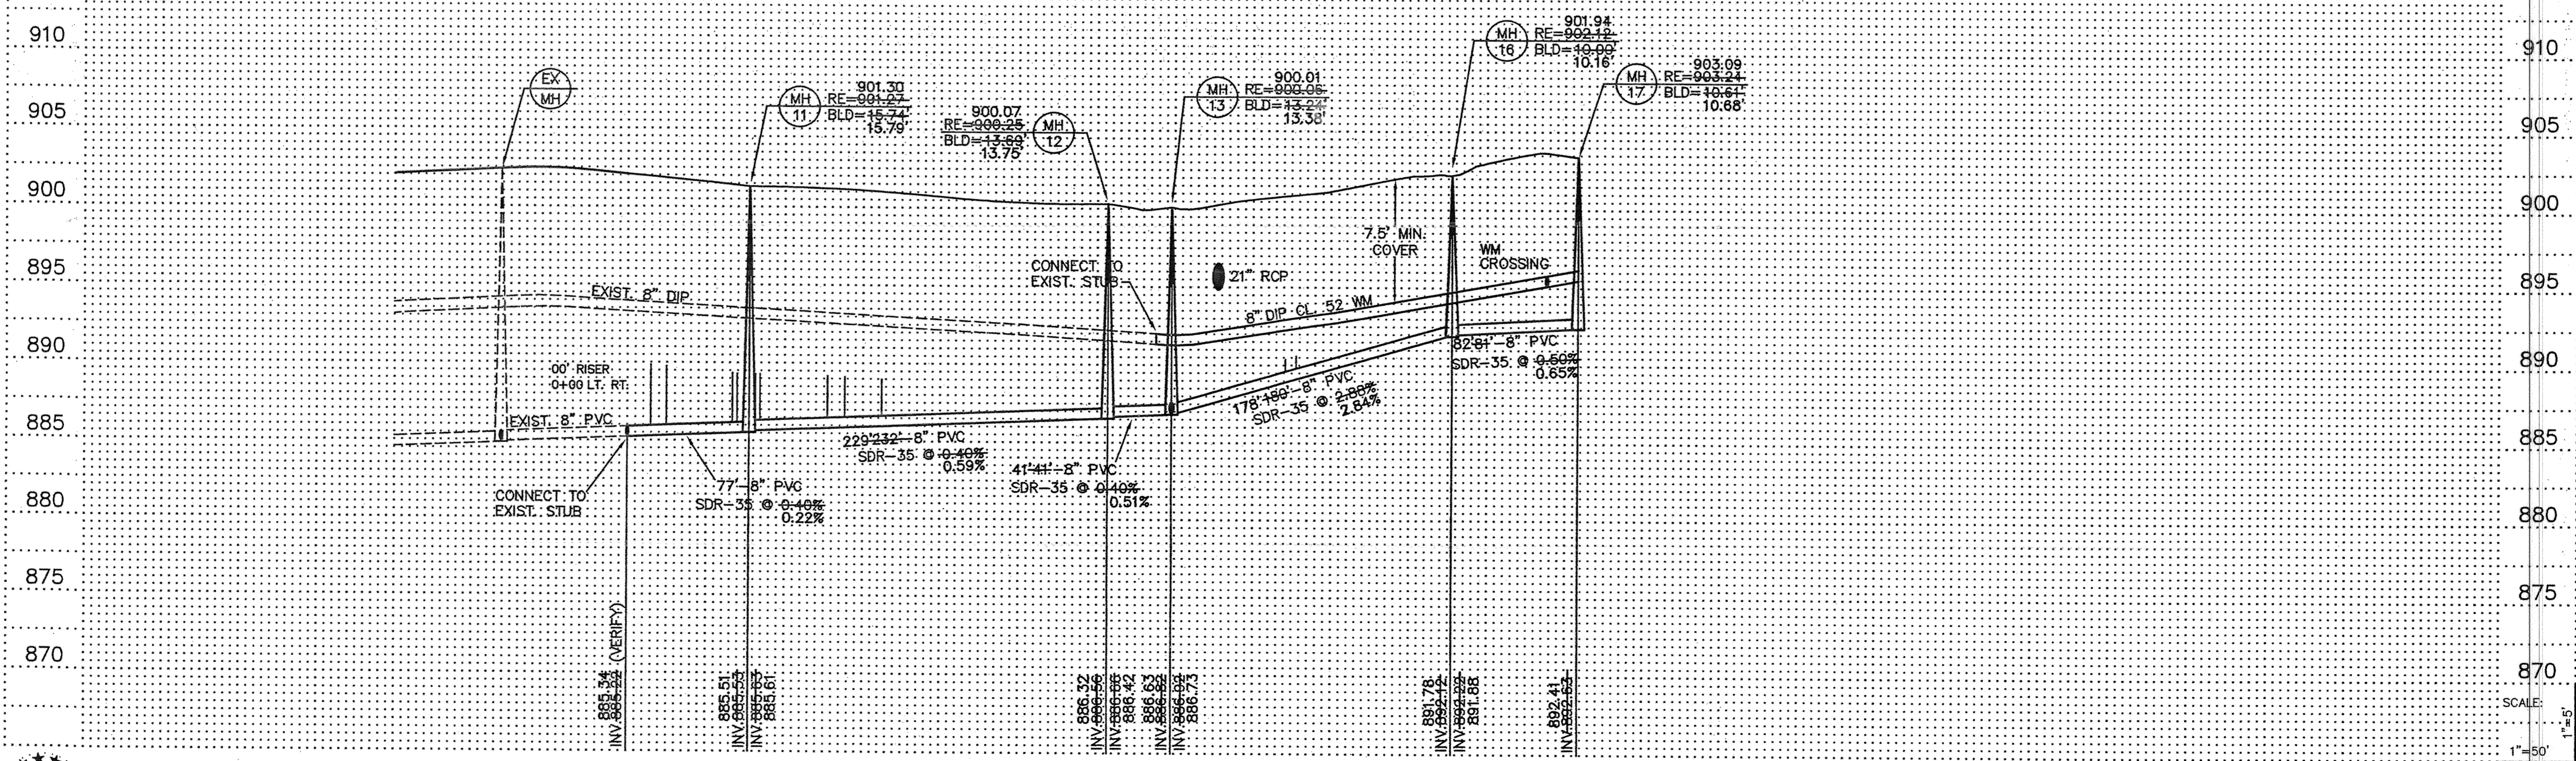

PIONEER engineering PA
 201 65th Avenue NW
 200 Riverway, MN 55443
 (763) 783-1880 FAX: 783-1883
 2125 Enterprise Drive
 Mendota Heights, MN 55120
 (651) 981-1884 FAX: 651-981-9486

I hereby certify that this plan was prepared by me or under my direct supervision and that I am a duly Licensed Professional Engineer under the laws of the State of Minnesota.

Name: *Brian F. Kallio*
 Reg. No.: 25317 Date: 7/8/04

3. AS-BUILT
 2. Change address
 1. Per city comments

Revisions
1. 7/8/04
2. 6/3/04
3. 1/14/05

Date: 6/3/04
 Designed: B.F.K.
 Drawn: LC

SHEET TITLE: **SANITARY SEWER & WATERMAIN**
 OWNER: **GSS PROPERTIES, LLC**
 8857 ZEALAND AVENUE NORTH
 BROOKLYN PARK, MINNESOTA 55445

PROJECT: **KLIEVER LAKE FIELDS 2ND ADDITION**
 ELK RIVER, MINNESOTA

RECORD PLAN 1/14/05

SHEET 4 OF 13 SHEETS