


BENCHMARKS

DOUBLE SPIKE EAST FACE OF POWER POLE,
WEST SIDE OF FILLMORE STREET N.W.,
50± FT. SOUTH OF 178TH AVENUE N.W.,
ELEVATION = 897.82 FT.

TRIPLE SPIKE EAST FACE OF POWER POLE,
NW QUADRANT OF FILLMORE STREET AND
175TH AVENUE N.W.,
ELEVATION = 909.73 FT.

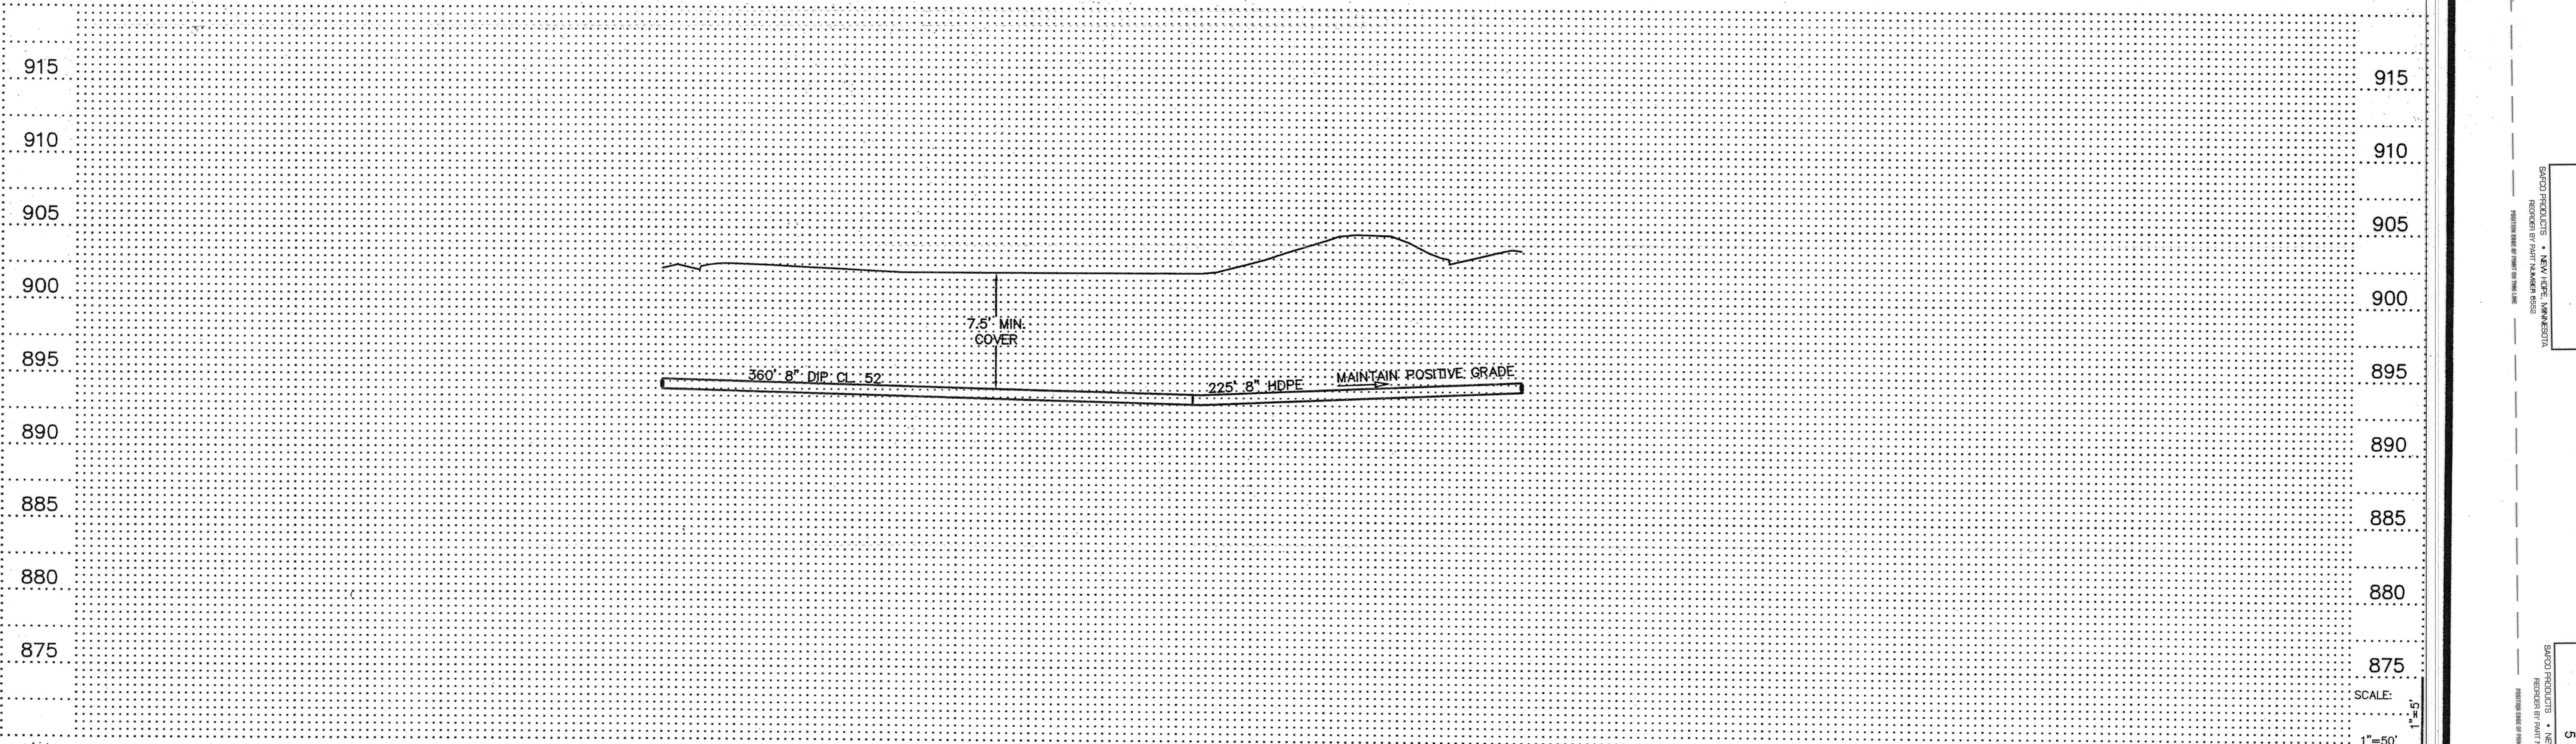

PIONEER engineering
PA
201 85th Avenue NW
Coon Rapids, MN 55433
(763) 785-1800 FAX: 783-1883
LAND PLANNERS • LANDSCAPE ARCHITECTS
2422 Enterprise Drive
Minnetonka, MN 55305
(952) 881-1914 FAX: 881-9488

I hereby certify that this plan was prepared by me or under my direct supervision and that I am a duly Licensed Professional Engineer under the laws of the State of Minnesota.

Name Brian F. Kallio
Reg. No. 25817 Date 7/8/04

3. AS-BUILT
2. Change address
1. Per city comments

Revisions
1. 1/9/04
2. 5/3/04
3. 1/14/05

Date 6/3/04
Designed B.F.K.
Drawn LC

SHEET TITLE
SANITARY SEWER & WATERMAIN

OWNER
GSS PROPERTIES, LLC
8857 ZEALAND AVENUE NORTH
BROOKLYN PARK, MINNESOTA 55445

PROJECT
KLIEVER LAKE FIELDS 2ND ADDITION
ELK RIVER, MINNESOTA

SHEET 5 OF 13 SHEETS

RECORD PLAN 1/14/05

DRAWING NUMBER
DRAWING NUMBER
DRAWING NUMBER
DRAWING NUMBER
KLEIV.04
5