


STRUCTURE No.	STRUCTURE SIZE	NEENAH CASTING
MH-101	48"	R-1733
CBMH-102	48"	R-3067-V
CB-103	24"x 36"	R-3067-V
CBMH-104	60"	R-3067-V
CBMH-105	48"	R-3067-V
CBMH-106	48"	R-3067-V
CBMH-107	48"	R-1733-1
CB-108	48"	R-4342
MH-109	60"	R-1733
CBMH-110	60"	R-3067-V
CBMH-111	84"	R-3067-V
CBMH-112	48"	R-3067-V
CBMH-113	48"	R-3067-V
CBMH-114	48"	R-3067-V
CB-115	48"	R-1733-1
CBMH-116	48"	R-3067-V
CBMH-117	48"	R-3067-V
CB-118	24"x 36"	R-3067-V
CB-119	24"x 36"	R-3067-V
CBMH-120	48"	R-1733-1
CB-121	48"	R-1733-1

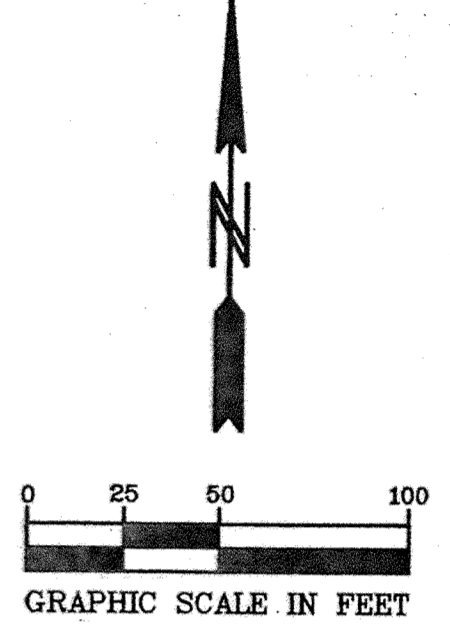


BENCHMARKS

DOUBLE SPIKE EAST FACE OF POWER POLE, WEST SIDE OF FILLMORE STREET N.W., 50± FT. SOUTH OF 178TH AVENUE N.W. ELEVATION = 897.82 FT.

TRIPLE SPIKE EAST FACE OF POWER POLE, NW QUADRANT OF FILLMORE STREET AND 175TH AVENUE N.W. ELEVATION = 909.73 FT.

- NOTE:**
INSTALL INLET PROTECTION AT CATCH BASINS WITHIN 48 HOURS OF INSTALLATION (SEE DETAILS).
1. CB-108, CB-115, CB-121, AND CBMH USE MONO-MONO SILT FENCE
 2. ALL OTHERS USE WMCO OR EQUAL

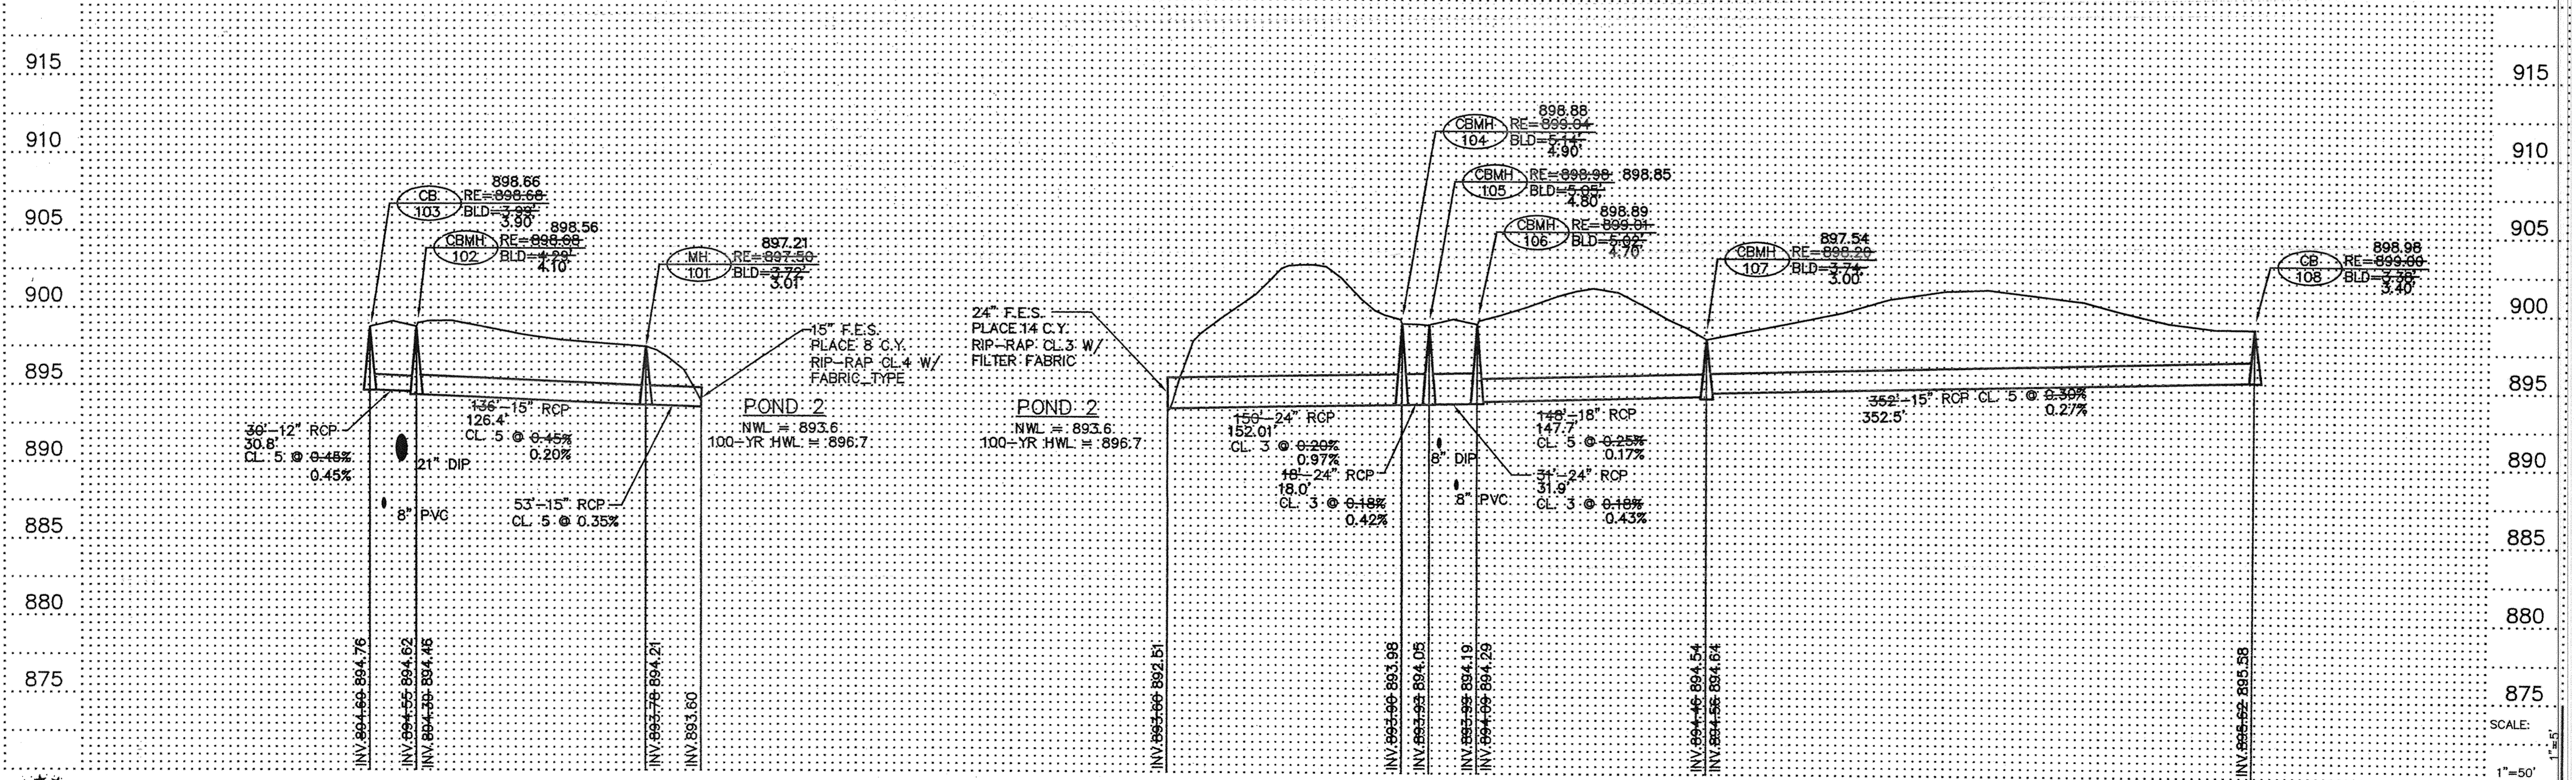

PIONEER engineering
 301 20th Avenue NW
 2009 Rapid City, MN 55433
 (651) 785-1800 FAX: 785-1803
 2422 Enterprise Drive
 Mendota Heights, MN 55120
 (651) 681-1914 FAX: 681-2488

I hereby certify that this plan was prepared by me or under my direct supervision and that I am a duly Licensed Professional Engineer under the laws of the State of Minnesota.

Name: *Brian F. Kallio*
 Brian F. Kallio
 Reg. No. 25817 Date 7/8/04

Revisions:
 1. 7/8/04
 2. 7/2/04
 3. 8/5/04
 4. 1/14/05

Date: 6/3/04
 Designed: B.F.K.
 Drawn: LC

SHEET TITLE: STORM SEWER

OWNER: GSS PROPERTIES, LLC
 8837 ZEALAND AVENUE NORTH
 BROOKLYN PARK, MINNESOTA 55445

PROJECT: KLIEVER LAKE FIELDS 2ND ADDITION
 ELK RIVER, MINNESOTA

SHEET 6 OF 13 SHEETS

RECORD PLAN 1/14/05

SCALE: 1"=50'