


179TH STREET NW

180TH LANE

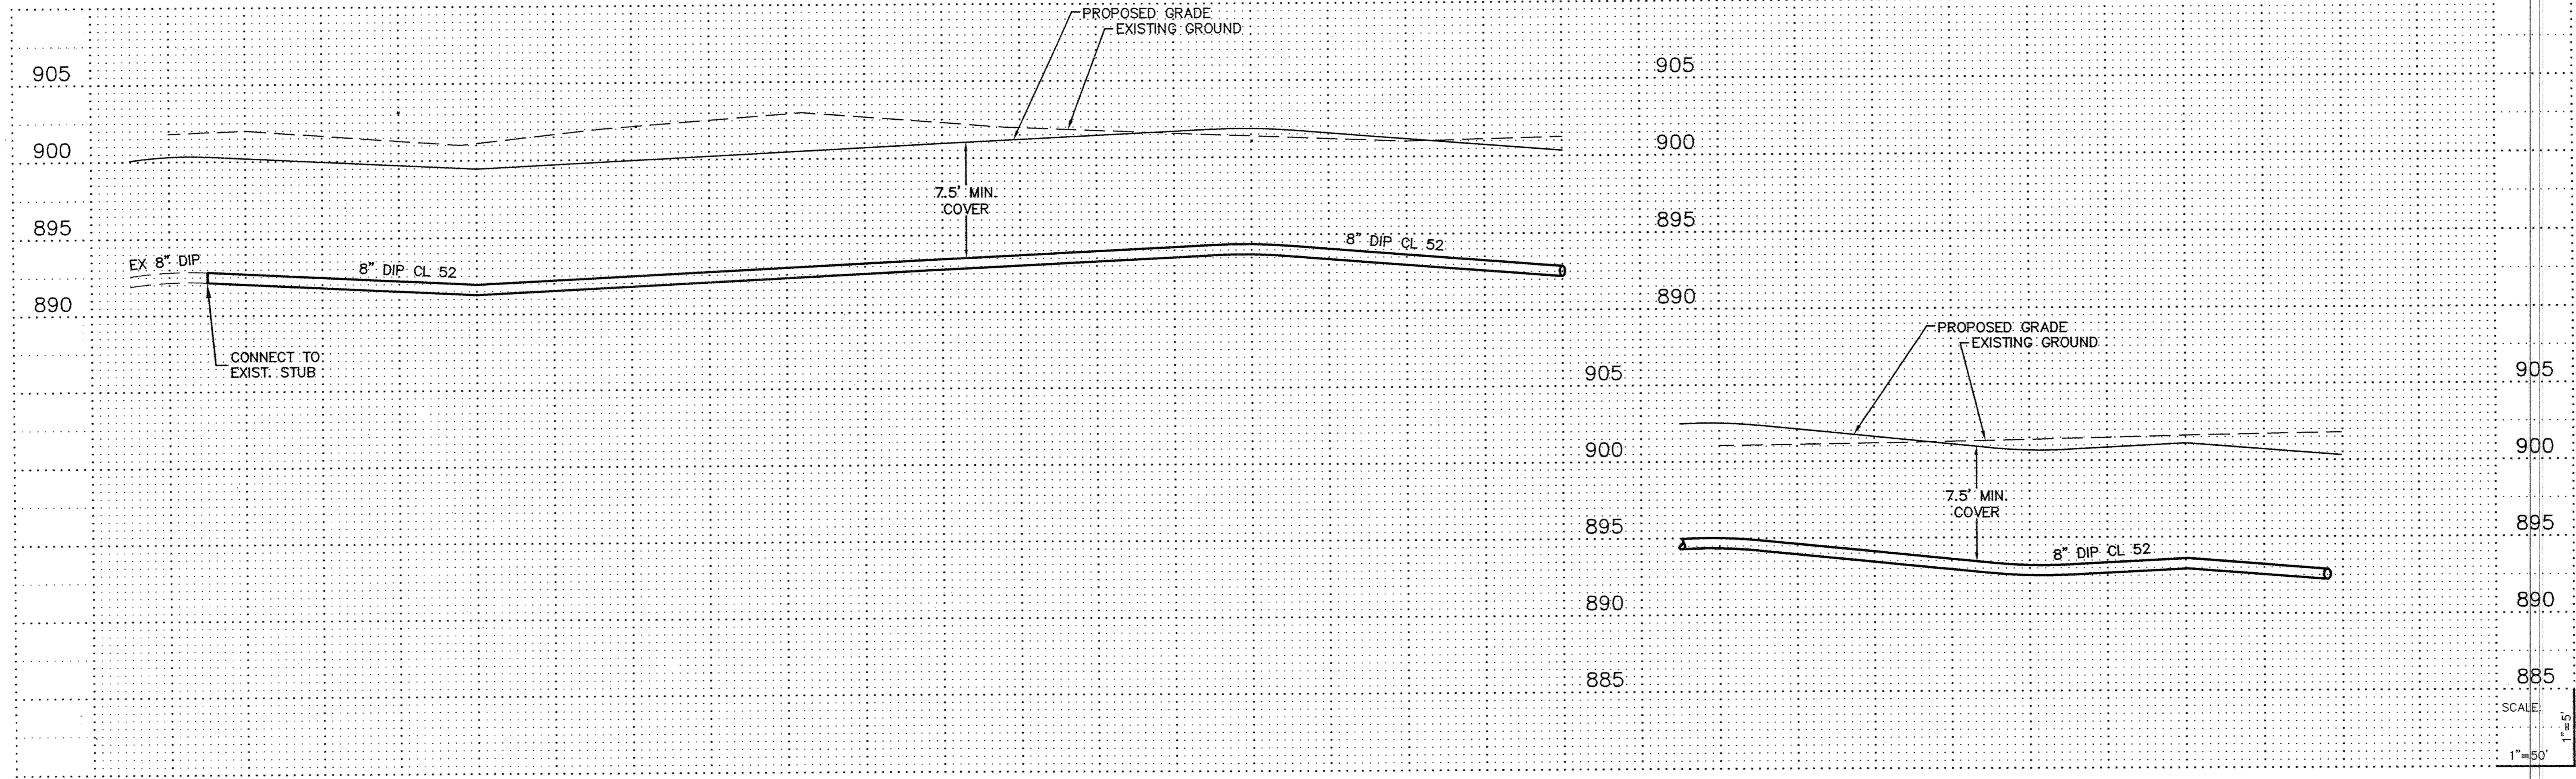

RECORD PLAN 6/14/05

	1 2422 Enterprise Drive Mendota Heights, MN 55120 (612) 881-1314 FAX: (612) 881-1452 625 Highway 10 N.E. Bloomington, MN 55424 (763) 783-1880 FAX: 783-1883	I hereby certify that this plan was prepared by me or under my direct supervision and that I am a duly Licensed Professional Engineer under the laws of the State of Minnesota. Name: Brian F. Krog Date: 8/15/02 Reg. No. 25817	Revisions	Date: 8/15/02 Designed: BFK Drawn: SAG	SHEET TITLE <b>WATERMAIN</b>	OWNER <b>GSS PROPERTIES LLC</b> 8857 ZEALAND AVENUE NORTH BROOKLYN PARK, MINNESOTA	PROJECT <b>KLIEVER LAKE FIELDS EAST</b> ELK RIVER, MINNESOTA	SHEET 3 OF 9 SHEETS
			SCALE: 1" = 50'					