


NOTES:
 1. MINIMUM \bar{C} ELEVATION SHALL BE 902.5

J:\DWG\200376-KLIEVER LAKE FIELDS MULTIPLE.DWG 08/14/2002 02:07:24 PM CDT

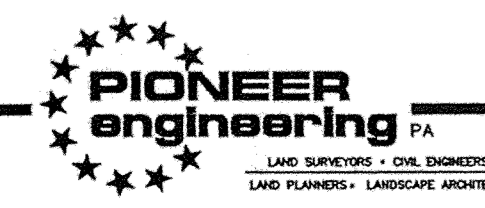

2422 Enterprise Drive
 Mendota Heights, MN 55120
 (651) 681-1914 FAX: 651-2488
 825 Highway 101 N.E.
 Suite 200
 Elk River, MN 55331
 (763) 782-1880 FAX: 763-1883

I hereby certify that this plan was prepared by me or under my direct supervision and that I am a duly Licensed Professional Engineer under the laws of the State of Minnesota.

Name Paul Chirne
 Reg. No. 19880 Date 8/15/02

1. AS-BUILTS
 Revisions
 1. 8/14/05

Date 8/15/02
 Designed BFK
 Drawn SAG

SHEET TITLE
STREET CONSTRUCTION

OWNER **GSS PROPERTIES LLC**
 8857 ZEALAND AVENUE NORTH
 BROOKLYN PARK, MINNESOTA 55445

PROJECT **KLIEVER LAKE FIELDS EAST**
 ELK RIVER, MINNESOTA

SHEET **6** OF **9** SHEETS

RECORD PLAN 6/14/05