


KLIEVER LAKE FIELDS 3RD

SANITARY SEWER, WATERMAIN, STORM SEWER AND STREET CONSTRUCTION PLANS ELK RIVER, MINNESOTA

SITE LOCATION MAP

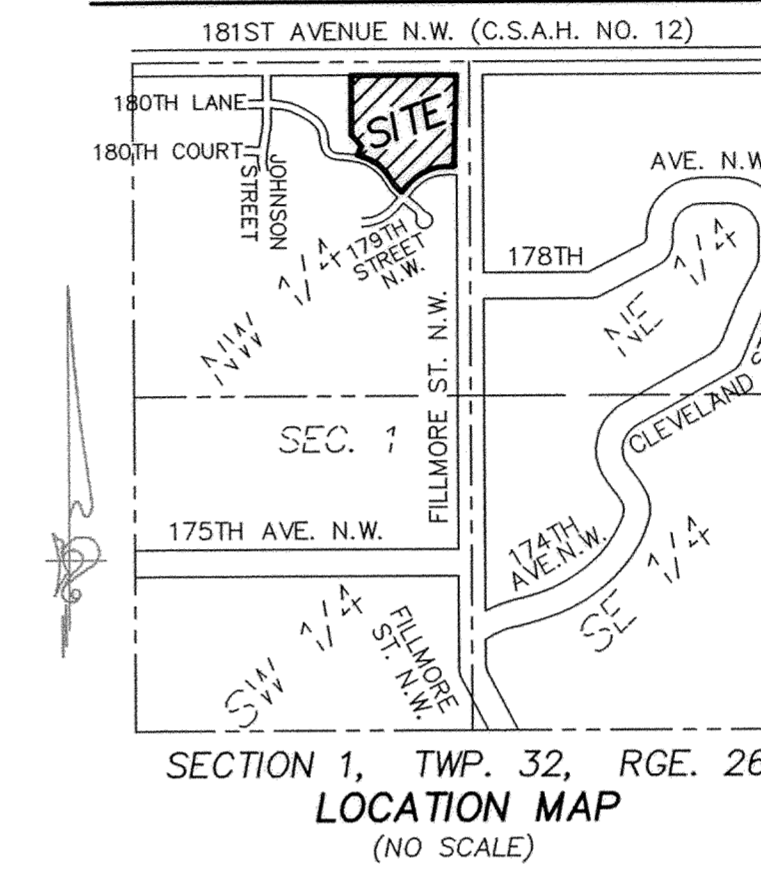



SHEET INDEX

1. COVER SHEET
2. SANITARY SEWER AND WATERMAIN
3. SANITARY SEWER AND WATERMAIN
4. SANITARY SEWER AND WATERMAIN
5. SANITARY SEWER AND WATERMAIN
6. STORM SEWER
7. STREET CONSTRUCTION
STREET A & DRWY-A & DRWY-B
8. STREET CONSTRUCTION
DRWY-C, D, E, F, G, H, I, J, & K
9. DETAILS
10. DETAILS
11. DETAILS

BENCHMARK

DOUBLE SPIKE EAST FACE OF POWER
POLE WEST OF FILLMORE STREET NW.
50 FT SOUTH OF 178TH AVE. NW.
ELEVATION = 897.82

TRIPLE SPIKE EAST FACE OF POWER
POLE NW QUADRANT OF FILLMORE
STREET AND 175TH AVENUE NW.
ELEVATION = 909.73

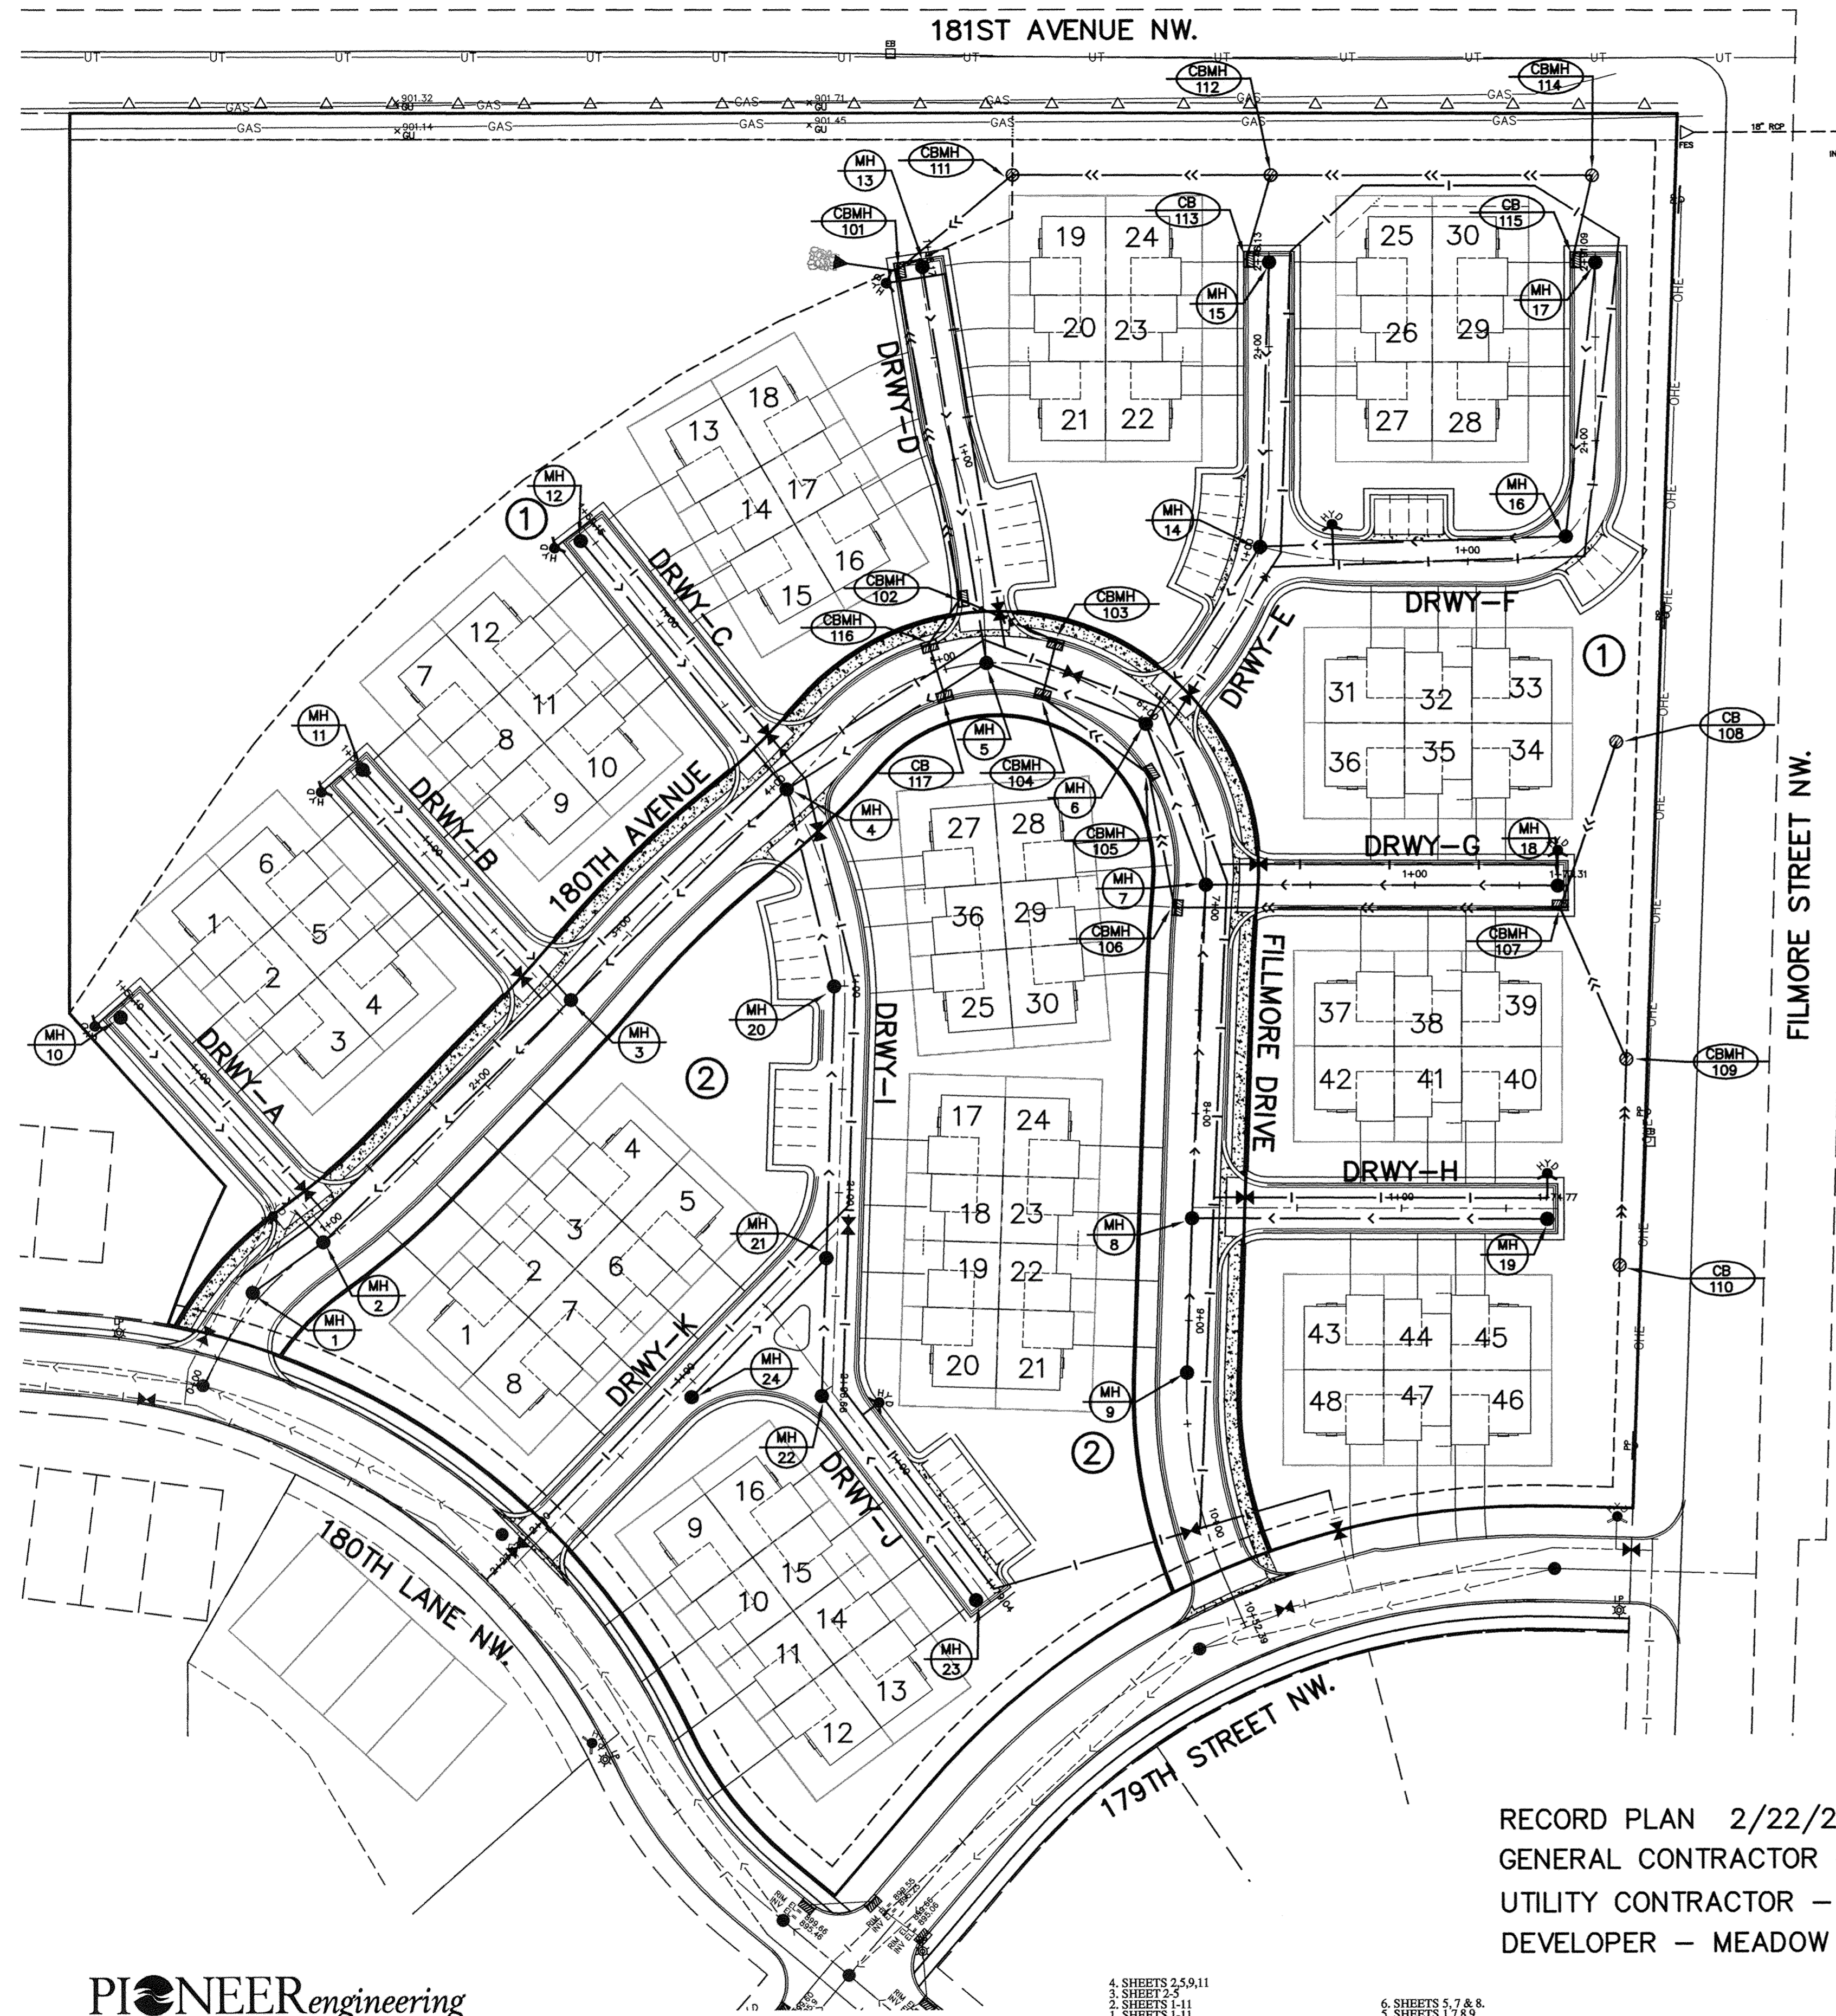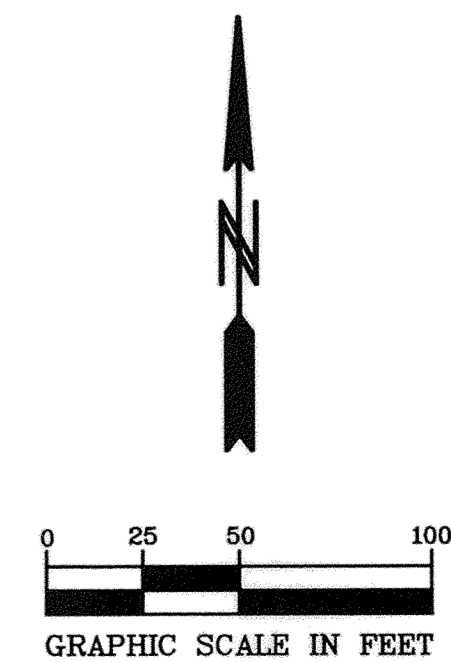

RECORD PLAN 2/22/2006
GENERAL CONTRACTOR - WEIDAMA CO. LLC
UTILITY CONTRACTOR - WEIDAMA CO. LLC
DEVELOPER - MEADOW CREEK BUILDERS

4. SHEETS 2,5,9,11
3. SHEET 2,5
2. SHEETS 1-11
1. SHEETS 1-11

6. SHEETS 5,7 & 8.
5. SHEETS 17,8,9

I hereby certify that this plan was prepared by me or under my direct supervision and that I am a duly Licensed Professional Engineer under the laws of the State of Minnesota.

Name: Christopher J. Huntley
Reg. No. 44246 Date 08/05/05

Revisions
1. 08/18/05
2. 09/01/05
3. 09/02/05
4. 09/20/05

5. 10/04/05
6. 10/19/05

Date 08/05/05
Designed C.J.H.
Drawn Kap

COVER SHEET

MEADOW CREEK BUILDERS
6382 BALSAM LANE
MAPLE GROVE, MN 55369

KLIEVER LAKE FIELDS 3RD
ELK RIVER, MINNESOTA

1 OF 11

PIONEERengineering
CIVIL ENGINEERS LAND PLANNERS LAND SURVEYORS LANDSCAPE ARCHITECTS

2422 Enterprise Drive
Mendota Heights, MN 55120
(651)681-1914 Fax:681-9488

Coon Rapids Office
201 85th Avenue N.W.
Coon Rapids, MN 55433
(763) 783-1880 Fax:783-1883

L:\Projects\2006\KLIEVER LAKE FIELDS 3RD\105-115-116-117-999-1000

DRAWING NUMBER
KLIEVER LAKE FIELDS 3RD
2006

DRAWING NUMBER
KLIEVER LAKE FIELDS 3RD
2006

DRAWING NUMBER
KLIEVER LAKE FIELDS 3RD
2006

DRAWING NUMBER
KLIEVER LAKE FIELDS 3RD
2006