


1. MISC. PER OWNER.
2. RAISE BLDG. PAD ELEV'S, LOT 10 & 11, BLK. 2.
3. RAISE STREET GRADE AT S1/4, Q.45, 180TH NW, RUP GARAGE AT LOT 12, BLK. 3.
4. CHANGE SHEET THH TO REFLECT DEVELOPMENT PLAN.
5. CHANGE BLDG. TYPE & ADD LOWEST FLOOR ELEV. FOR LOT 1-11, BLK. 2; ADD ECF AT REAR OF LOT 9, BLK. 2.



8/11/03  
Approved for  
Remission of  
Block 2  
Terry M...  
Markout

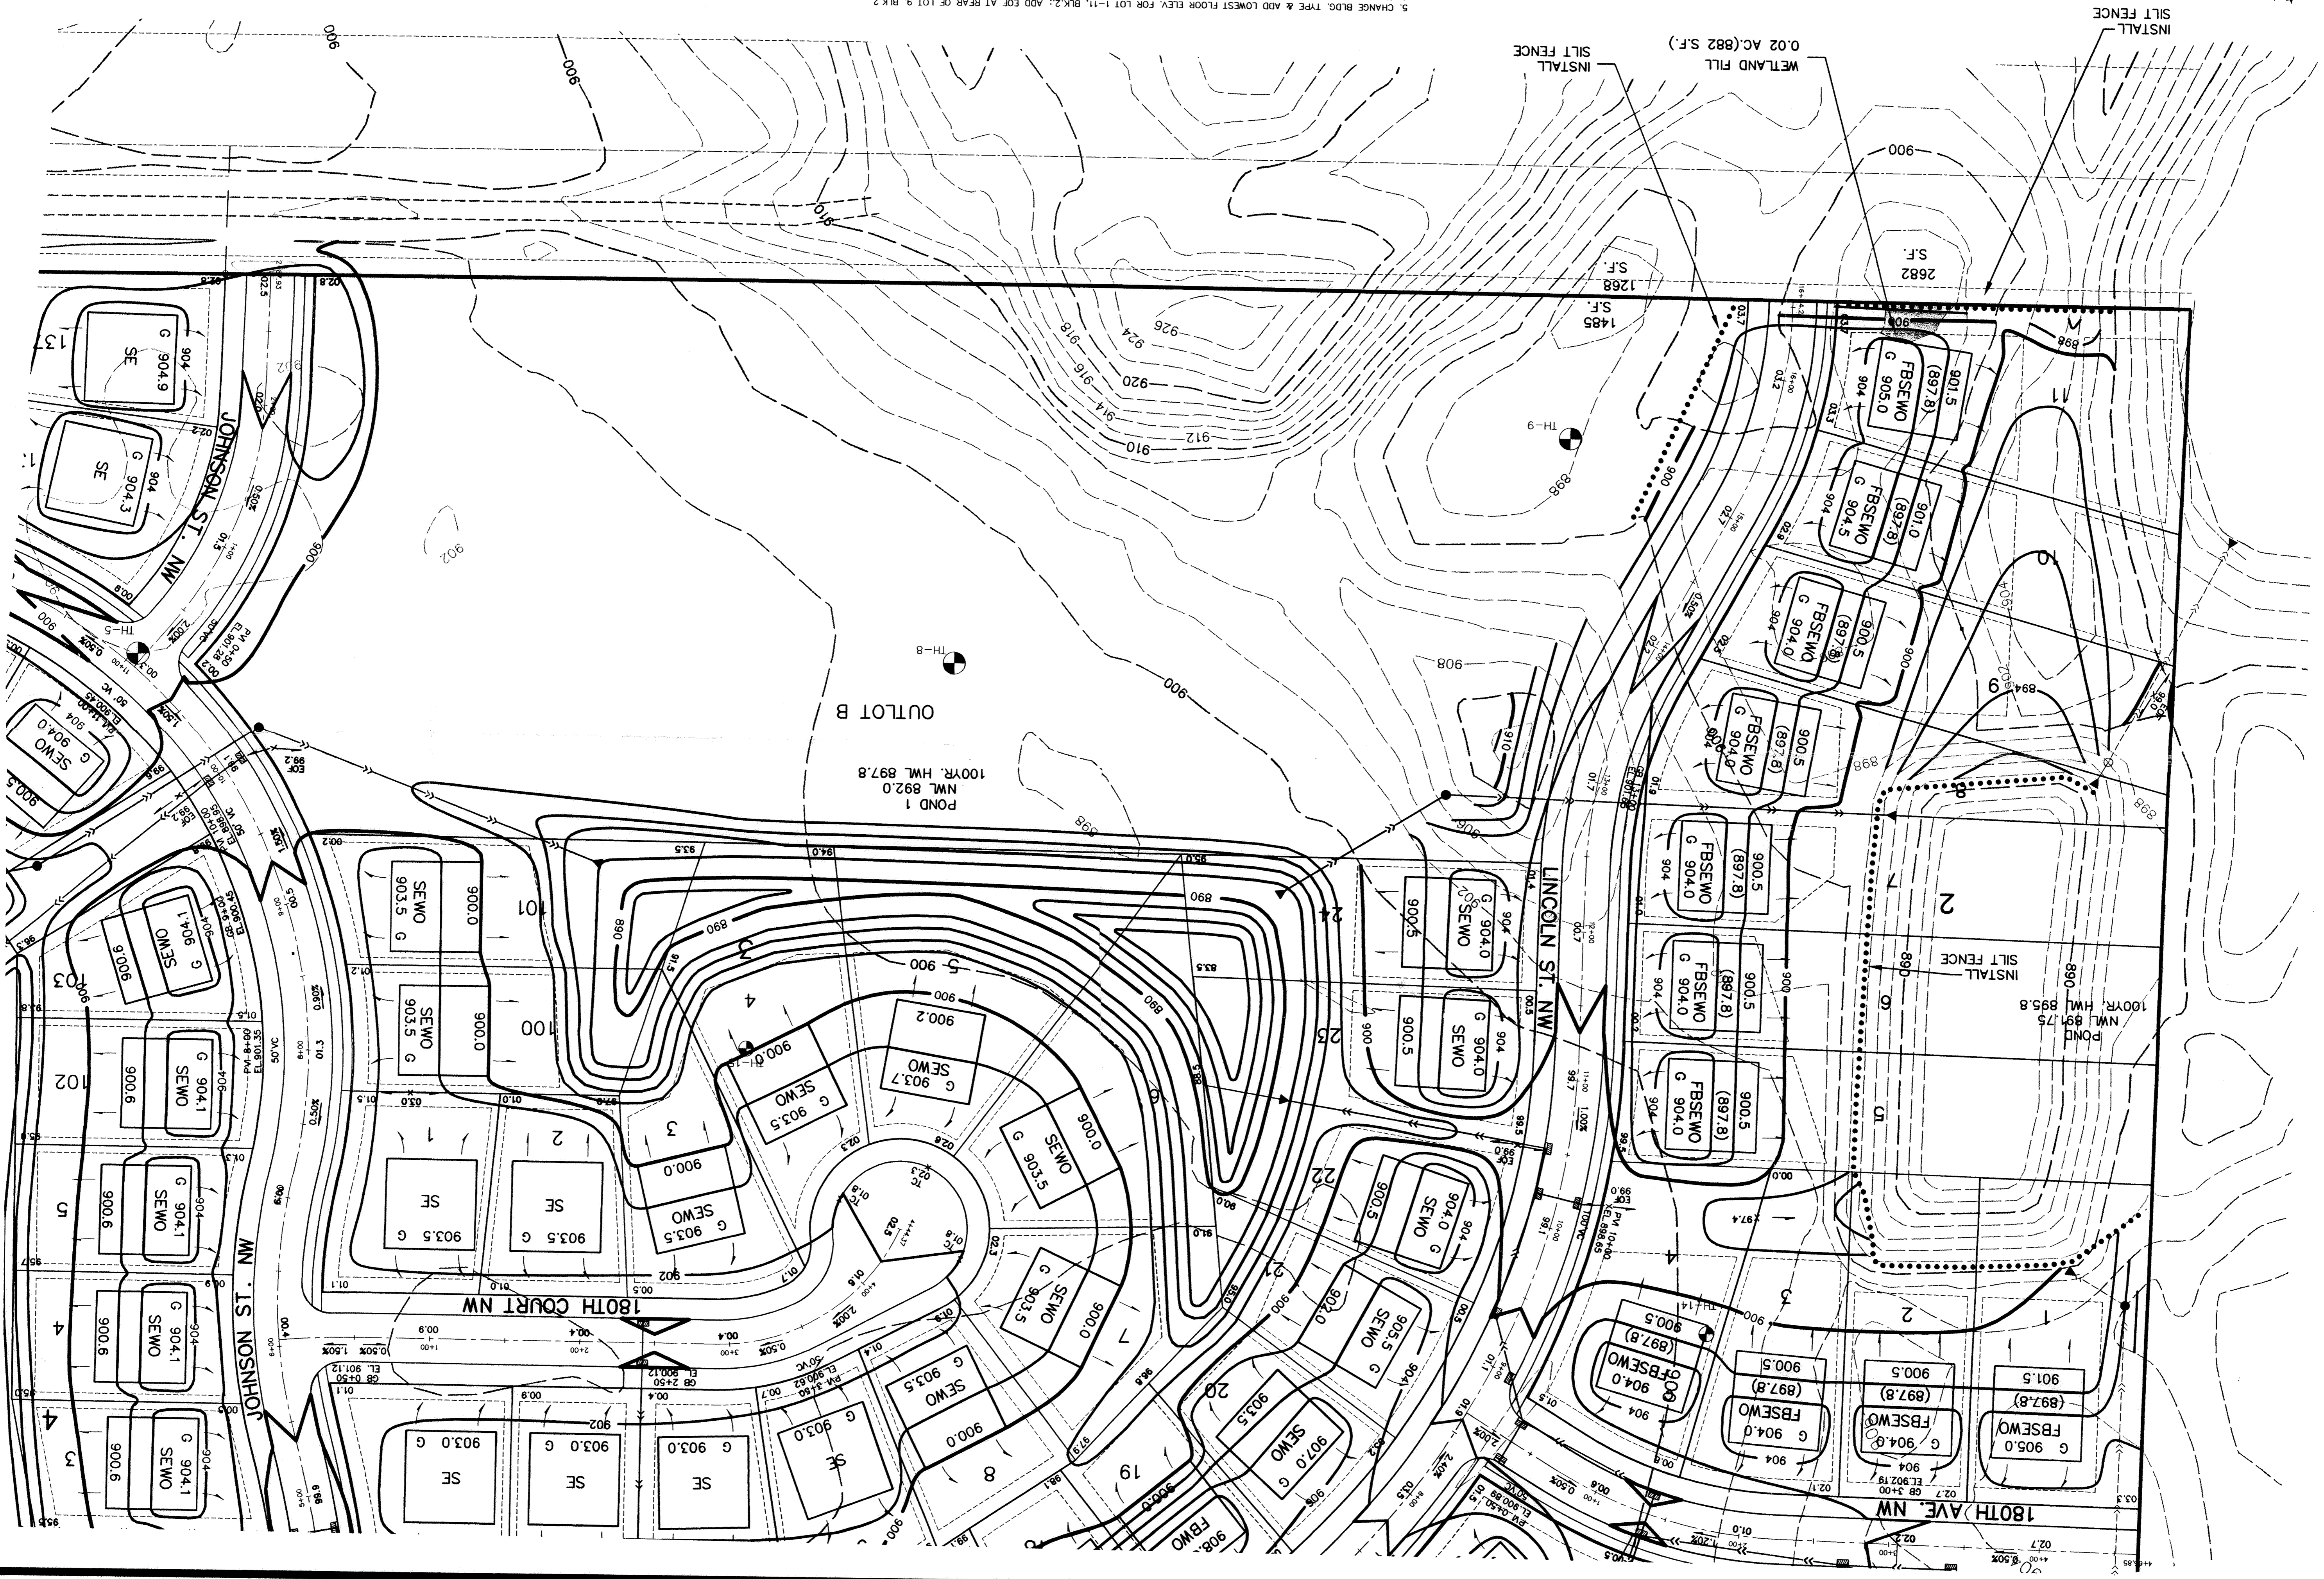