


NOTE :


- ALL LOTS TO BE ROUGH GRADED WITH A 2' AVERAGE PAD HOLD-DOWN.

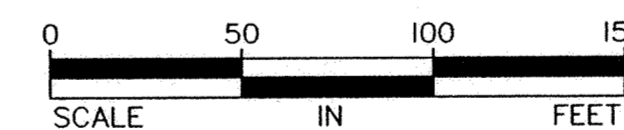

█ = CRITICAL ELEVATIONS

LEGEND

- 940 Existing Contours
- 952 Proposed contours
- Asterisk=Custom Lot By Builder
- House Pad: G=Garage floor Elev. TF=Top of Foundation Elev. B=Basement Elev. LO=Lookout Elev. WO=Walkout Elev. SLO=Side Lookout Elev. Corner Pad Elev.
- Proposed storm sewer

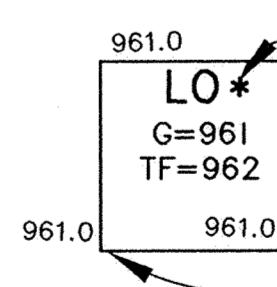

APPROVED
6-16-99 *Paul A. Kyis*
H.P. Green Co.

REV. NO.	DATE	DESCRIPTION
1	5/20/97	TREE CLEARING LIMITS PER CLIENT
2	6/12/97	MIS. GRADING & ADD. D&I PER CITY REVIEW
3	6/17/97	FINAL GRADING SUBMITTAL
4	7/25/97	REVISE WEST SIDE QUANTITY POND
5	5/25/98	AS-BUILT LOT GRADING
6	6/11/99	CITY COMMENTS

I hereby certify that this plan was prepared by me or under my direct supervision and that I am a duly Registered Professional Engineer under the laws of the State of Minnesota.
 Signed: *John C. Shatt*
 Date: 2/23/99 Reg. No. 14960

John Oliver & Associates, Inc.
 Civil Engineering, Land Surveying, Land Planning
 580 Dodge Avenue
 Elk River, Minnesota
 (612)441-2072 (FAX)441-6665
 207 W. Travelers Trail, Suite 200
 Elk River, MN 55007
 (612)894-3046 (FAX)894-3049

**LAFAYETTE WOODS
 THIRD ADDITION
 ELK RIVER, MN
 WINDSOR DEVELOPMENT L.L.P.
 DEVELOPMENT PLAN**