



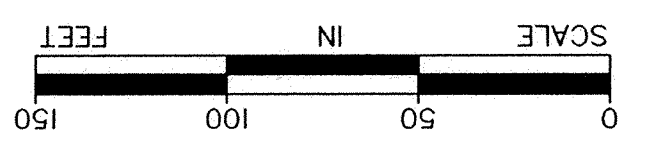

NOTE :
1. ALL LOTS TO BE ROUGH GRADED WITH A 2' AVERAGE PAD HOLD-DOWN.

APPROVED
6-16-99
H.R. Green Co.
H.R. Green

Central Elevations

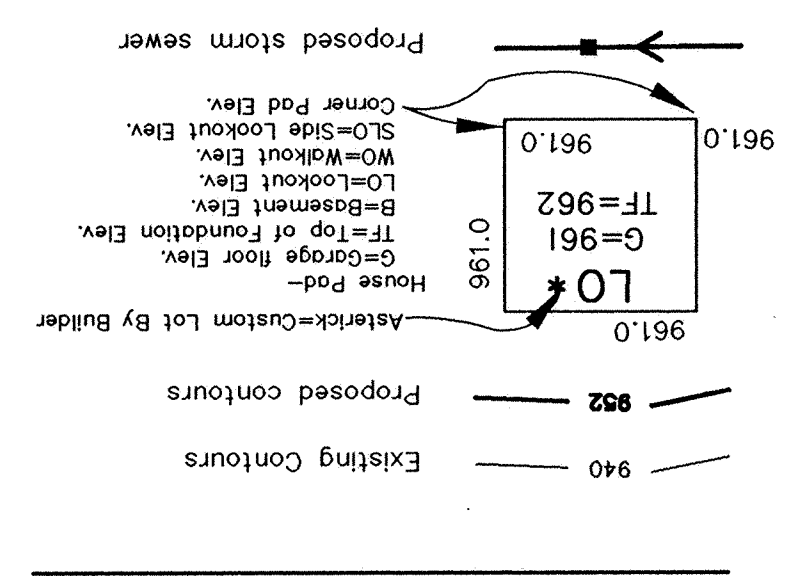

LAFAYETTE WOODS
THIRD ADDITION
ELK RIVER, MN
WINDSOR DEVELOPMENT L.L.P.
DEVELOPMENT PLAN

John Oliver & Associates, Inc.
Civil Engineering, Land Surveying, Land Planning
580 Dodge Avenue
Elk River, Minnesota
(612)441-2072 (FAX)441-5665
201 W. Travelers Trail, Suite 200
Davenport, MN 55335 (FAX)894-8049

I hereby certify that this plan was prepared by me or under my direct supervision and that I am a duly registered Professional Engineer under the laws of the State of Minnesota.
Signed: *John C. Shultz*
Date: 2/23/99 Reg. No. 14960

DATE: 5/9/96
DESIGN BY: JK,FB,GD
DRAWN BY: JK,BG
CHECKED BY: GD
DWG FILE: 4-DEV
TEXT FILE: N/A
FILE NO.: 7024.50-03

REV	NO.	DATE	DESCRIPTION
1	1	5/20/97	TREE CLEARING LIMITS PER CLIENT
2	2	6/12/97	FINAL GRADING & ADD DATA PER CITY REVIEW
3	3	6/17/97	FINAL GRADING SUBMITTAL
4	4	9/05/97	REVISION WEST SIDE QUALITY FOND
5	5	5/23/98	GENERAL LOT GRADING
6	6	6/11/98	AS-BUILT
7	7	6/11/98	CITY COMMENTS