


Structure Table

STR. #	TYPE	DIA.	RIM	BLD	IE	Casting
1502	CBMH	72"Ø	929.0	7.1	921.8	R-3067
1504	CBMH	48"Ø	926.3	3.6	922.7	R-2560-C
1505	CBMH	48"Ø	927.1	3.6	923.5	R-2561
1506	CBMH	48"Ø	927.6	3.6	924.0	R-2561
1507	OCS	48"Ø	933.4	8.0	925.4	SEE DETAIL
PRO-1501	CBMH	60"Ø	934.9	17.6	920.8	R-3067-V




FES Table

STR. LBL	TYPE	DIA.	IE	FLEX-A-MAT
1507A	FES			INLET
PRO-1500	FES	30"	920.0	USE EXISTING

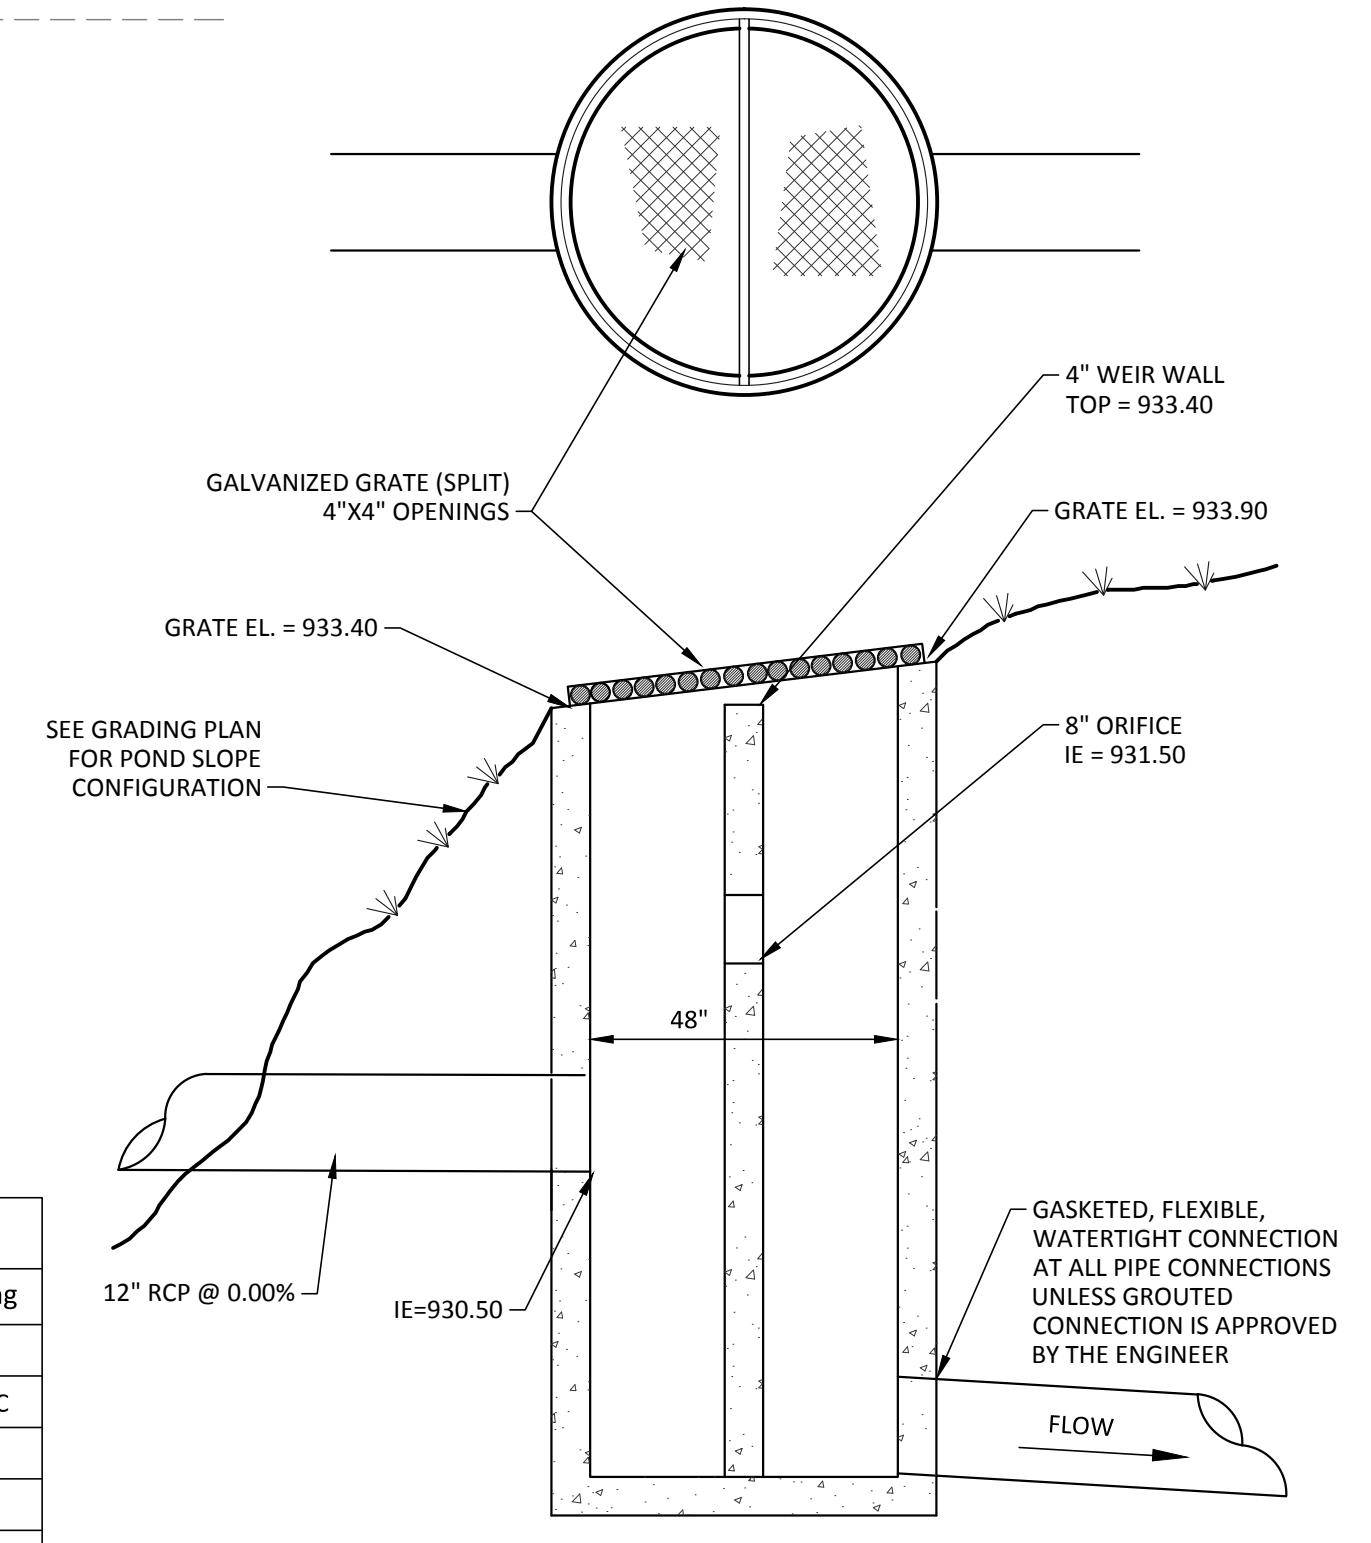

OCS 1507
N.T.S.

STORM 1500

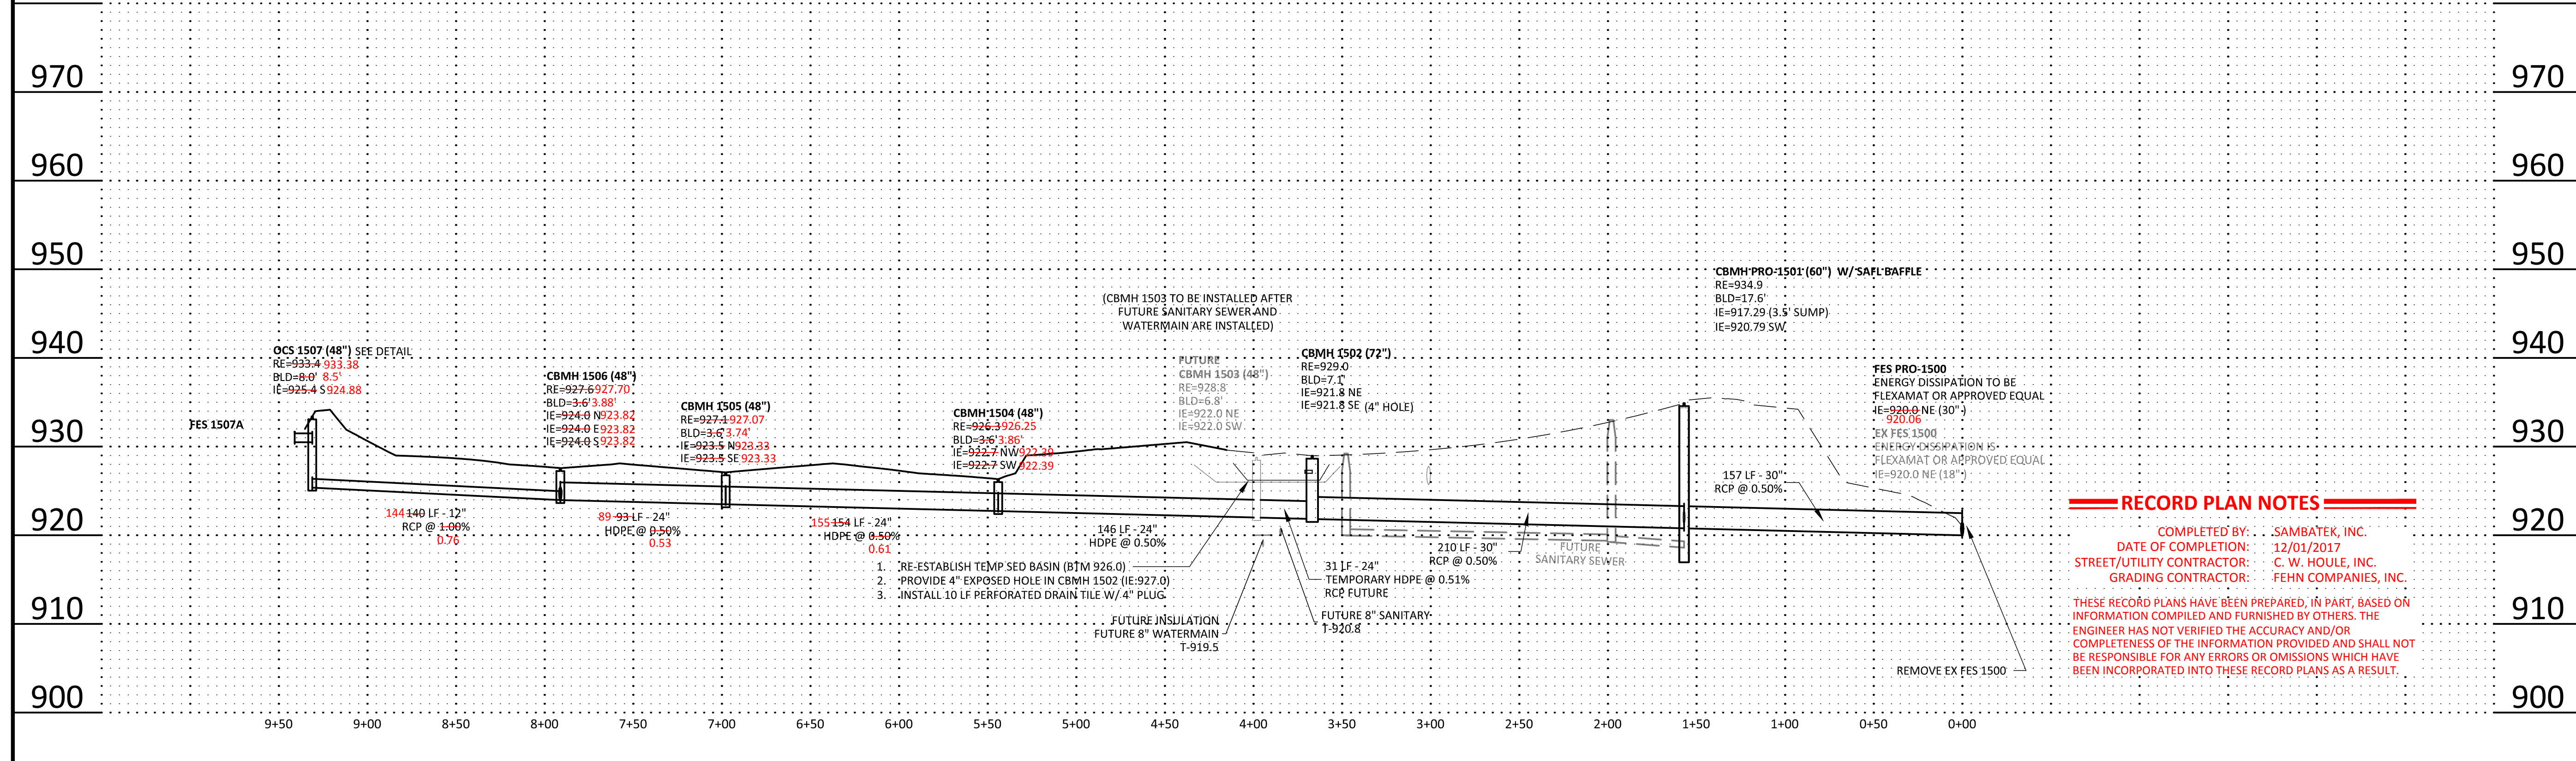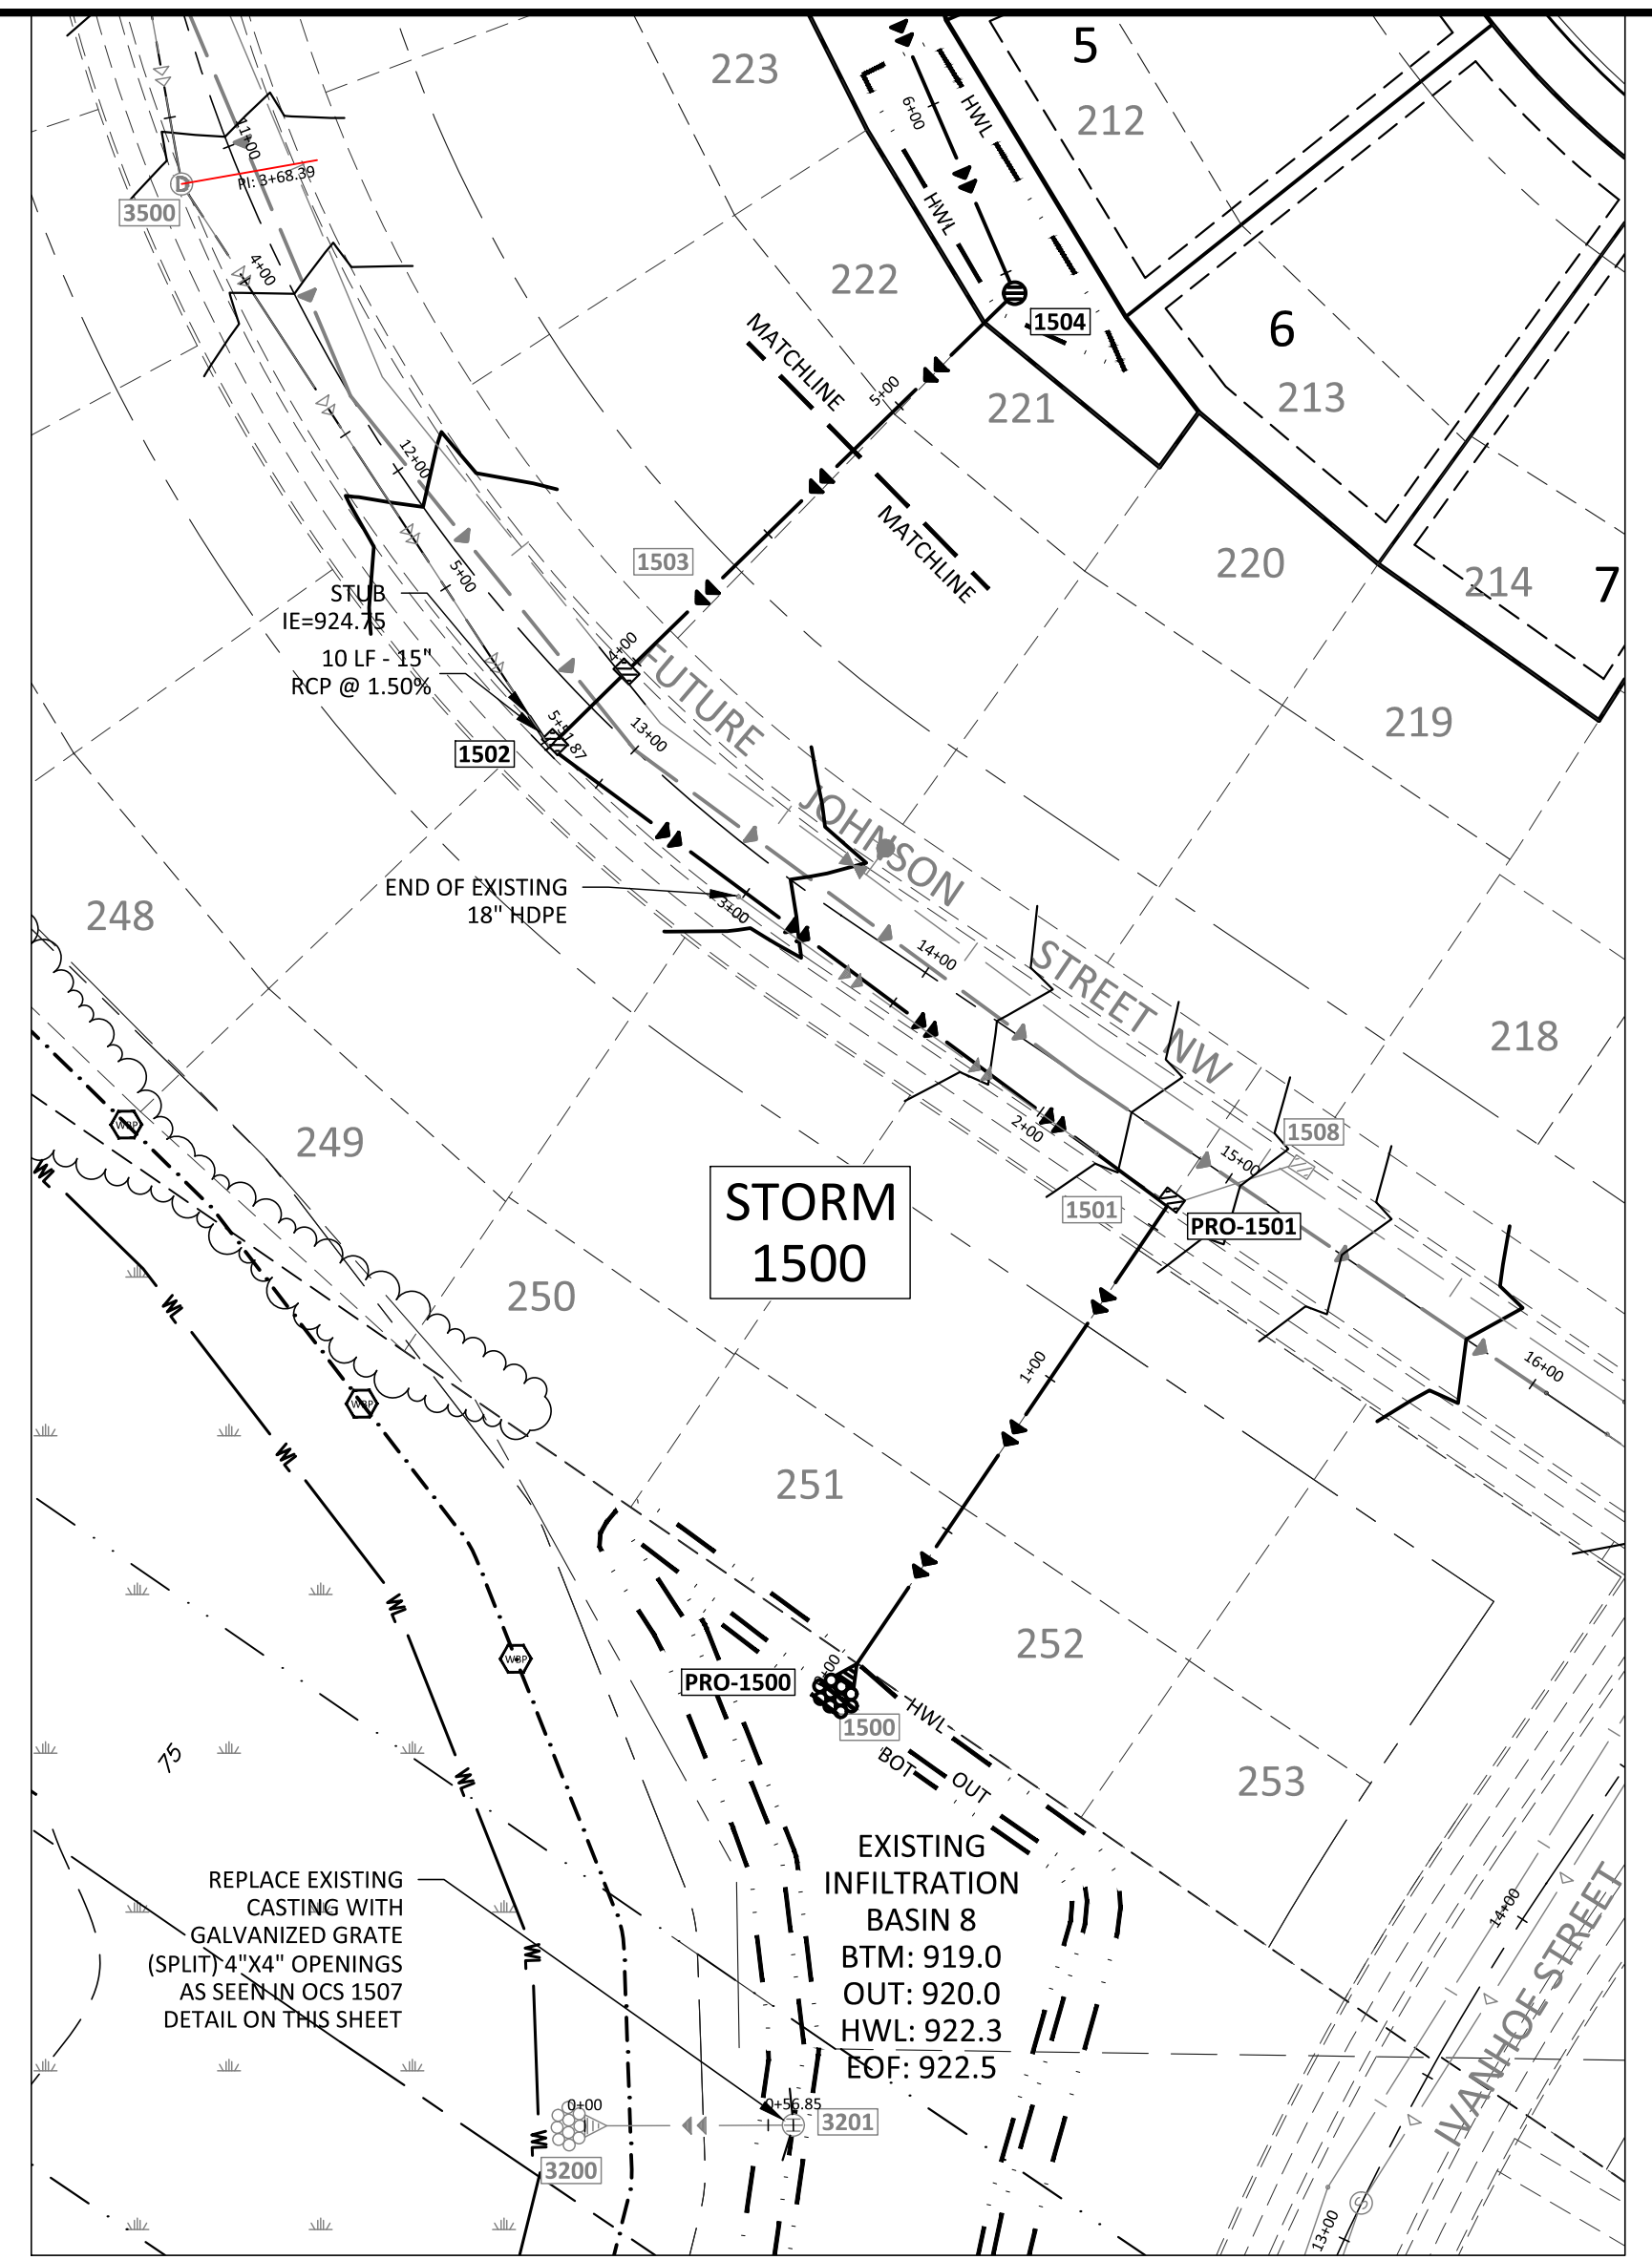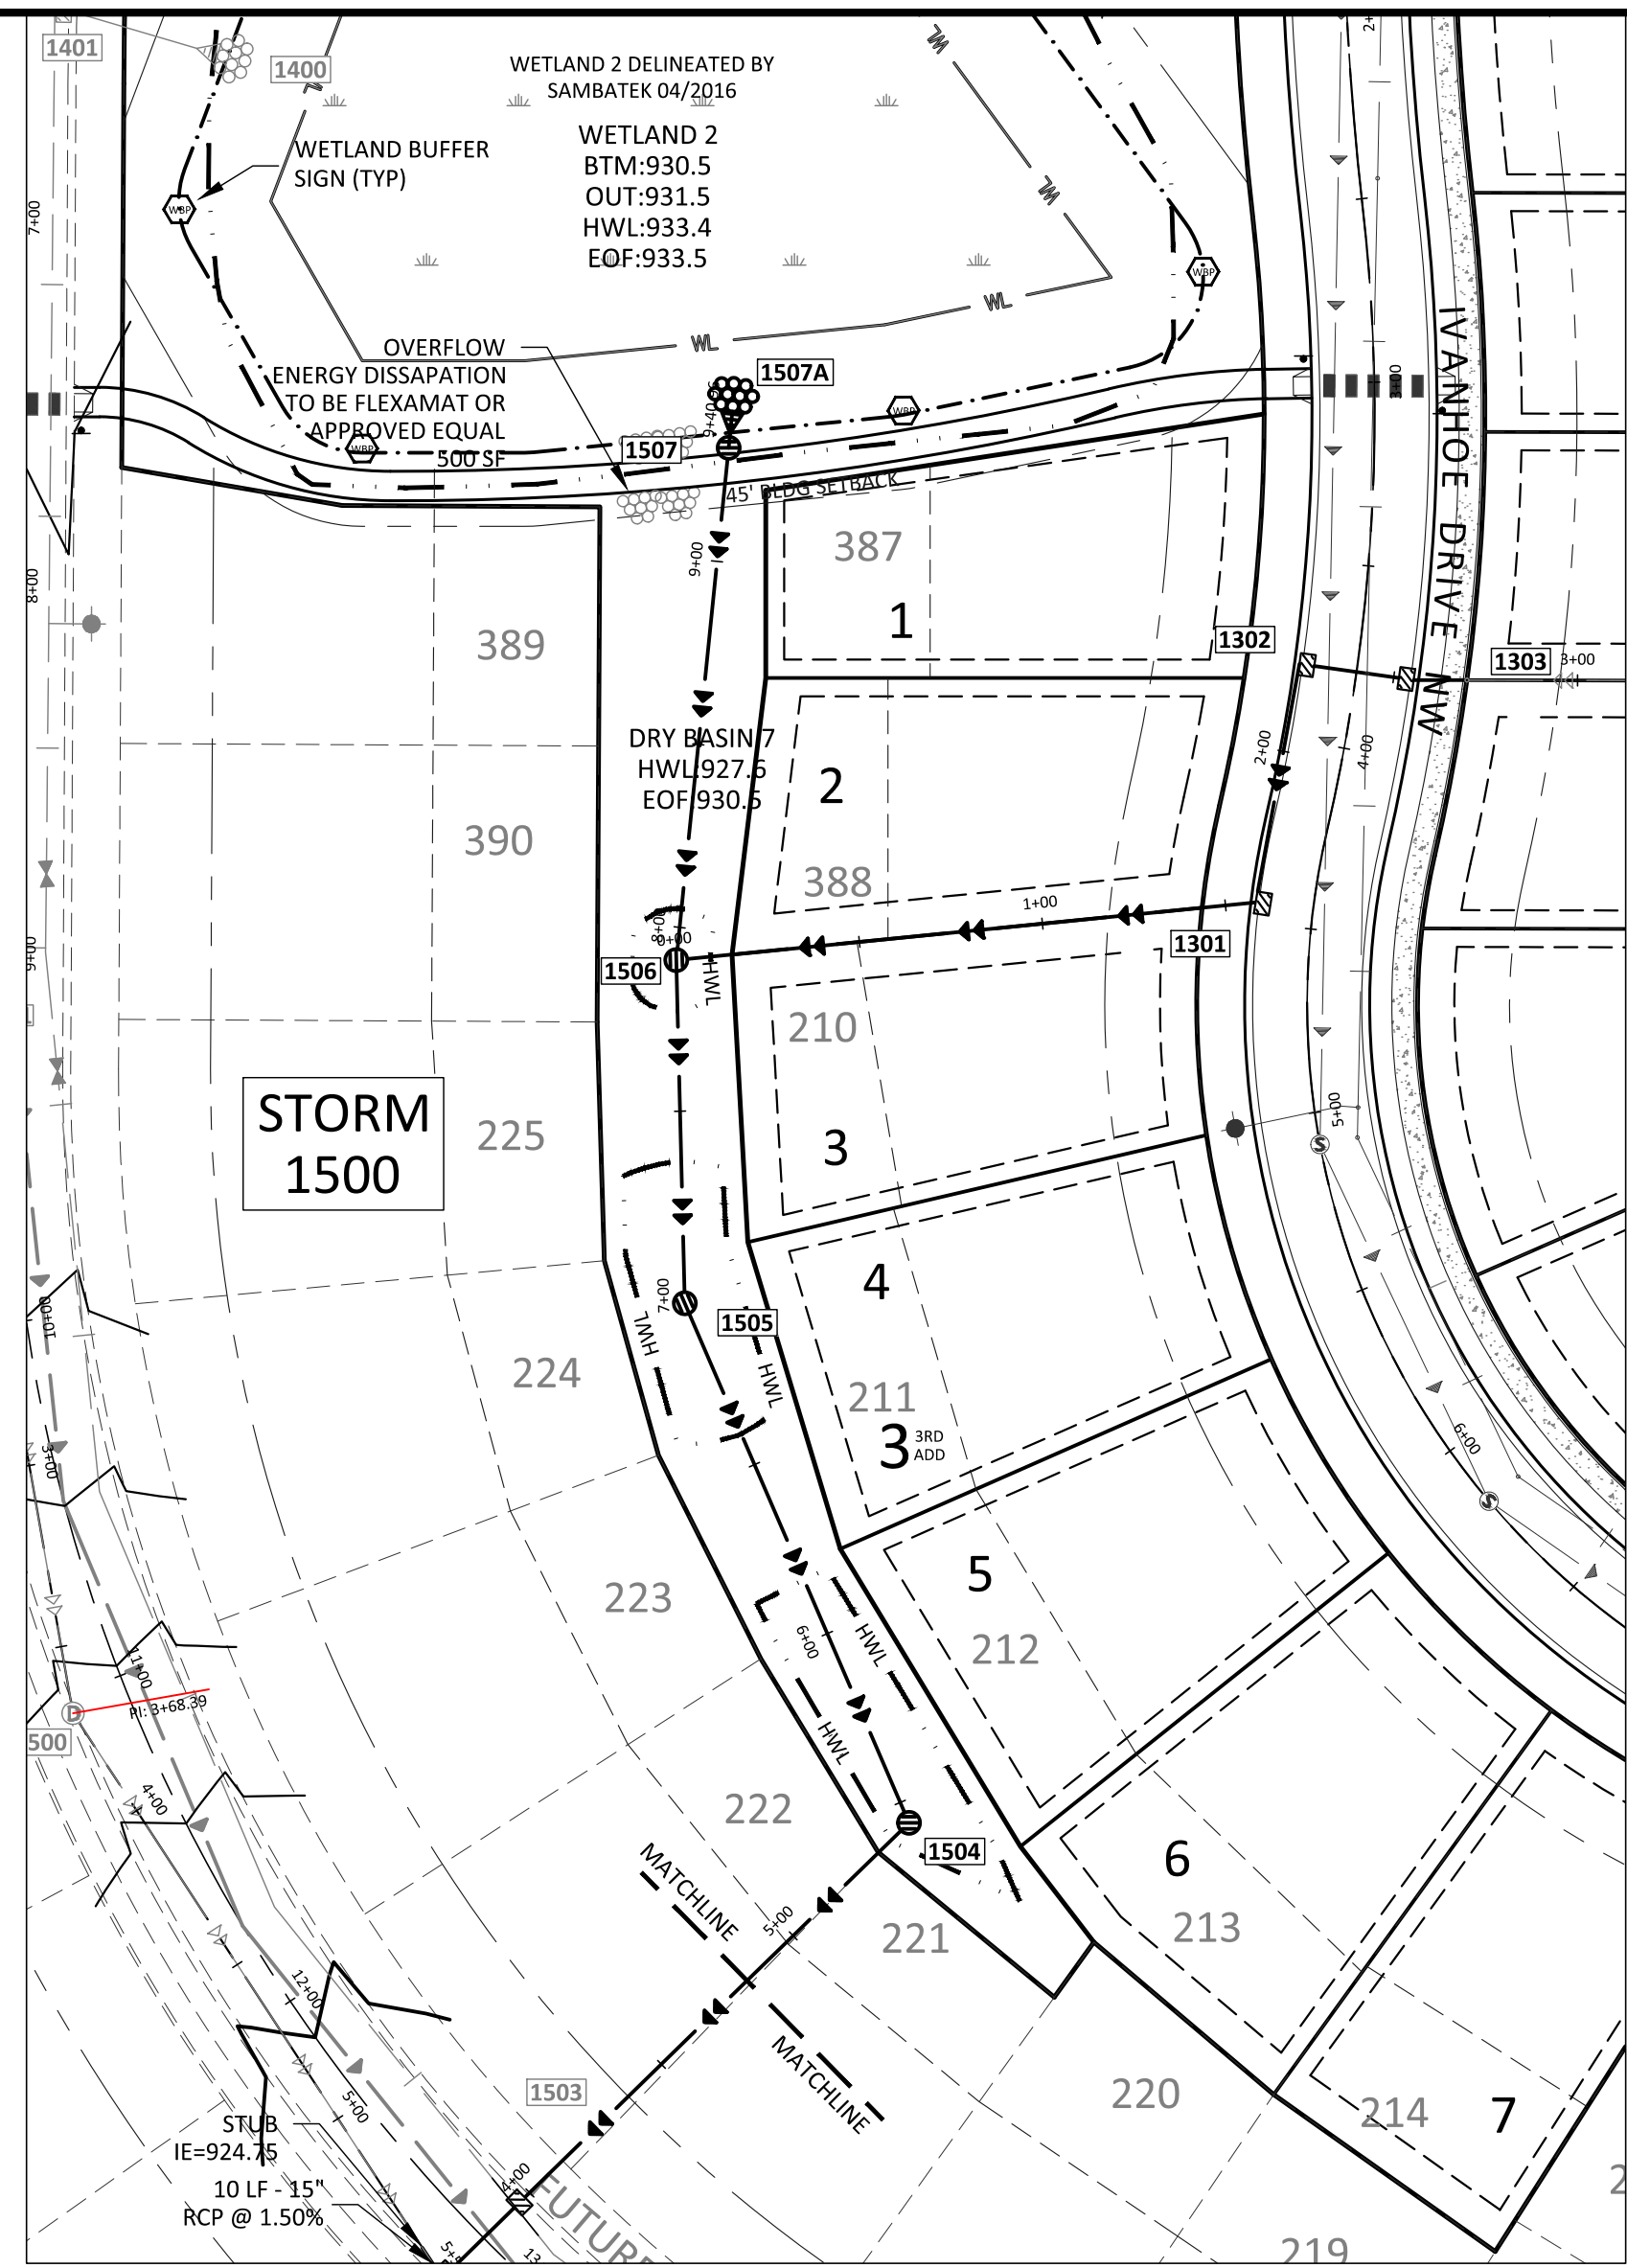

RECORD PLAN NOTES

COMPLETED BY: SAMBATEK, INC.
DATE OF COMPLETION: 12/01/2017
STREET/UTILITY CONTRACTOR: C. W. HOLE, INC.
GRADING CONTRACTOR: FEHN COMPANIES, INC.

THESE RECORD PLANS HAVE BEEN PREPARED, IN PART, BASED ON INFORMATION COMPILED AND FURNISHED BY OTHERS. THE ENGINEER HAS NOT VERIFIED THE ACCURACY AND/OR COMPLETENESS OF THE INFORMATION PROVIDED AND SHALL NOT BE RESPONSIBLE FOR ANY ERRORS OR OMISSIONS WHICH HAVE BEEN INCORPORATED INTO THESE RECORD PLANS AS A RESULT.