

Construction Plans

for

Sanitary Sewer, Water Main, Storm Sewer and Streets

for

Marshes of Trott Brook Farms Elk River, Minnesota

Prepared for:

D. R. Horton, Inc.
 20860 Kenbridge Court
 Lakeville, Minnesota 55044
Contact: Tom Bakritges
Phone: 952-985-7826
Fax: 952-985-7800


Prepared by:

Westwood Professional Services, Inc.
 7599 Anagram Drive
 Eden Prairie, MN 55344
 Phone: 952/937-5150 Fax: 952/937-5822

Project number: 20011092
 Contact: Jason McCarty

INDEX	
SHEET NO.	DESCRIPTION
1	COVER
2	OVERALL PLAN
3	SANITARY SEWER & WATER MAIN - 185TH AVENUE (STA. 3+15.44 TO STA. 12+70) AND 185TH CIRCLE
4	SANITARY SEWER & WATER MAIN - ULYSSES STREET (STA. 12+70 TO STA. 20+00)
5	SANITARY SEWER & WATER MAIN - TYLER DRIVE / TYLER STREET
6	STORM SEWER & STREET CONST. - 185TH AVENUE (STA. 3+15.44 TO STA. 13+10) AND 185TH CIRCLE
7	STORM SEWER & STREET CONST. - ULYSSES STREET (STA. 13+10 TO STA. 20+00)
8	STORM SEWER & STREET CONST. - TYLER DRIVE / TYLER STREET
9	STORM SEWER & STREET CONST. - YARD AREA
10 - 14	DETAILS

VICINITY MAP:

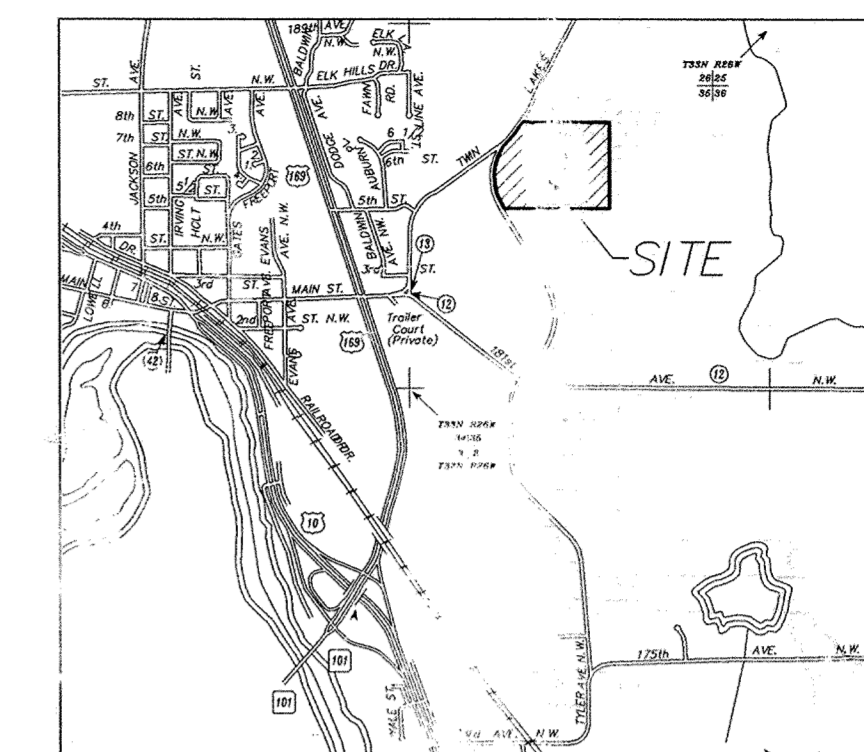

ELK RIVER
No Scale

NO.	DATE	REVISION	SHEETS
1	08/05/02	CITY REVIEW	ALL
2	08/19/02	CITY REVIEW	ALL
3	10/25/02	STORM SEWER	2 & 8
4	01/30/03	GAS LINE NOTES	1 & 3
5	04/22/03	185TH AVENUE OVER GAS LINES	ALL
6	01/21/05	RECORD DRAWINGS	ALL

CONTRACTOR: RYAN CONTRACTING
RECORD DRAWING
 CONFORMING TO CONSTRUCTION RECORDS.
 BY ALLAN SPILLES DATE 01/21/05
 WESTWOOD PROFESSIONAL SERVICES

Construction Plans

for

Sanitary Sewer, Water Main, Storm Sewer and Streets

for

Marshes of Trott Brook Farms Elk River, Minnesota

Date: 07/12/02 Sheet: 1 of 14

DRAWING NUMBER

DRAWING NUMBER

DRAWING NUMBER

DRAWING NUMBER

BROOK FARMS
2002

PROJECT NUMBER 20011092
 SHEET NUMBER 01 OF 14

PROJECT NUMBER 20011092
 SHEET NUMBER 01 OF 14

PROJECT NUMBER 20011092
 SHEET NUMBER 01 OF 14

PROJECT NUMBER 20011092
 SHEET NUMBER 01 OF 14