




SLAB TOP MANHOLE

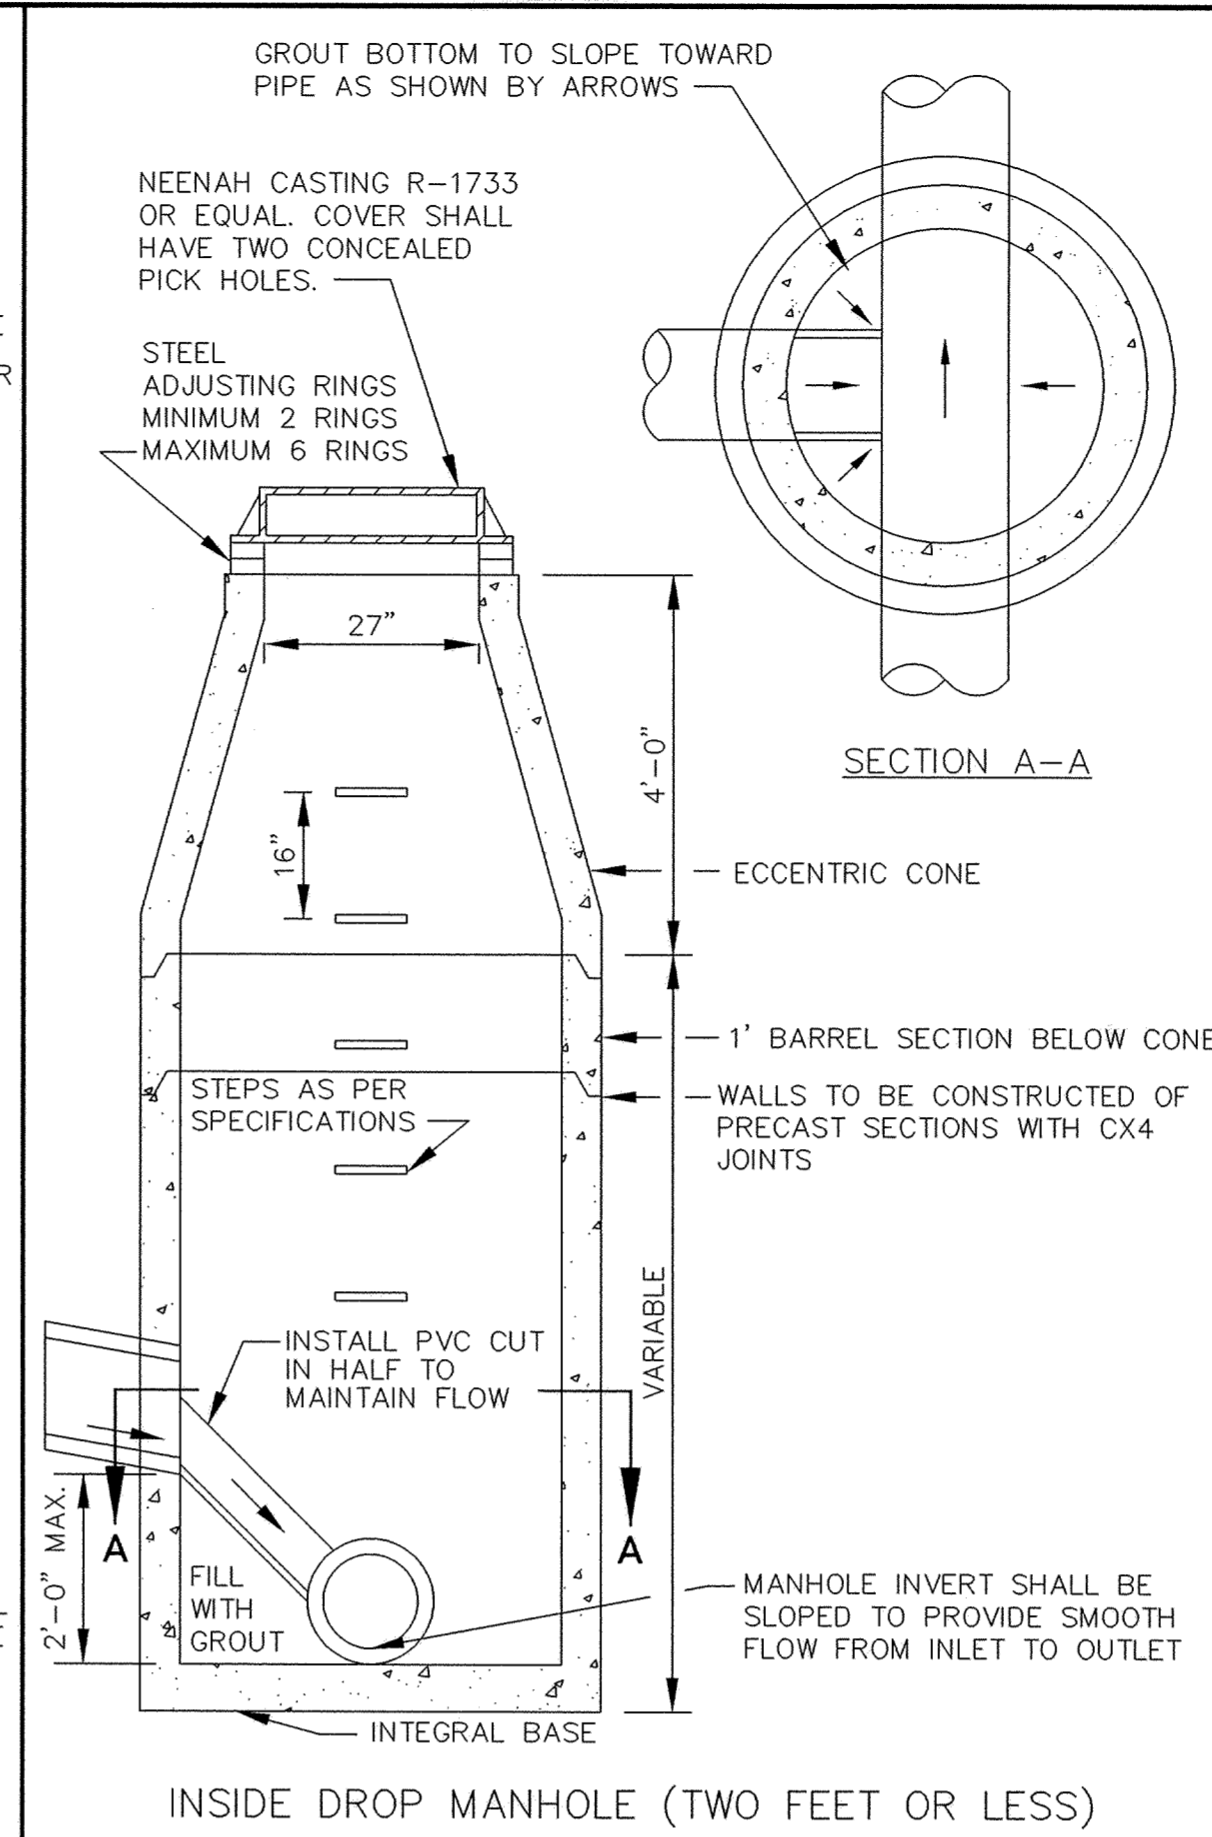


INSIDE DROP MANHOLE (TWO FEET OR LESS)

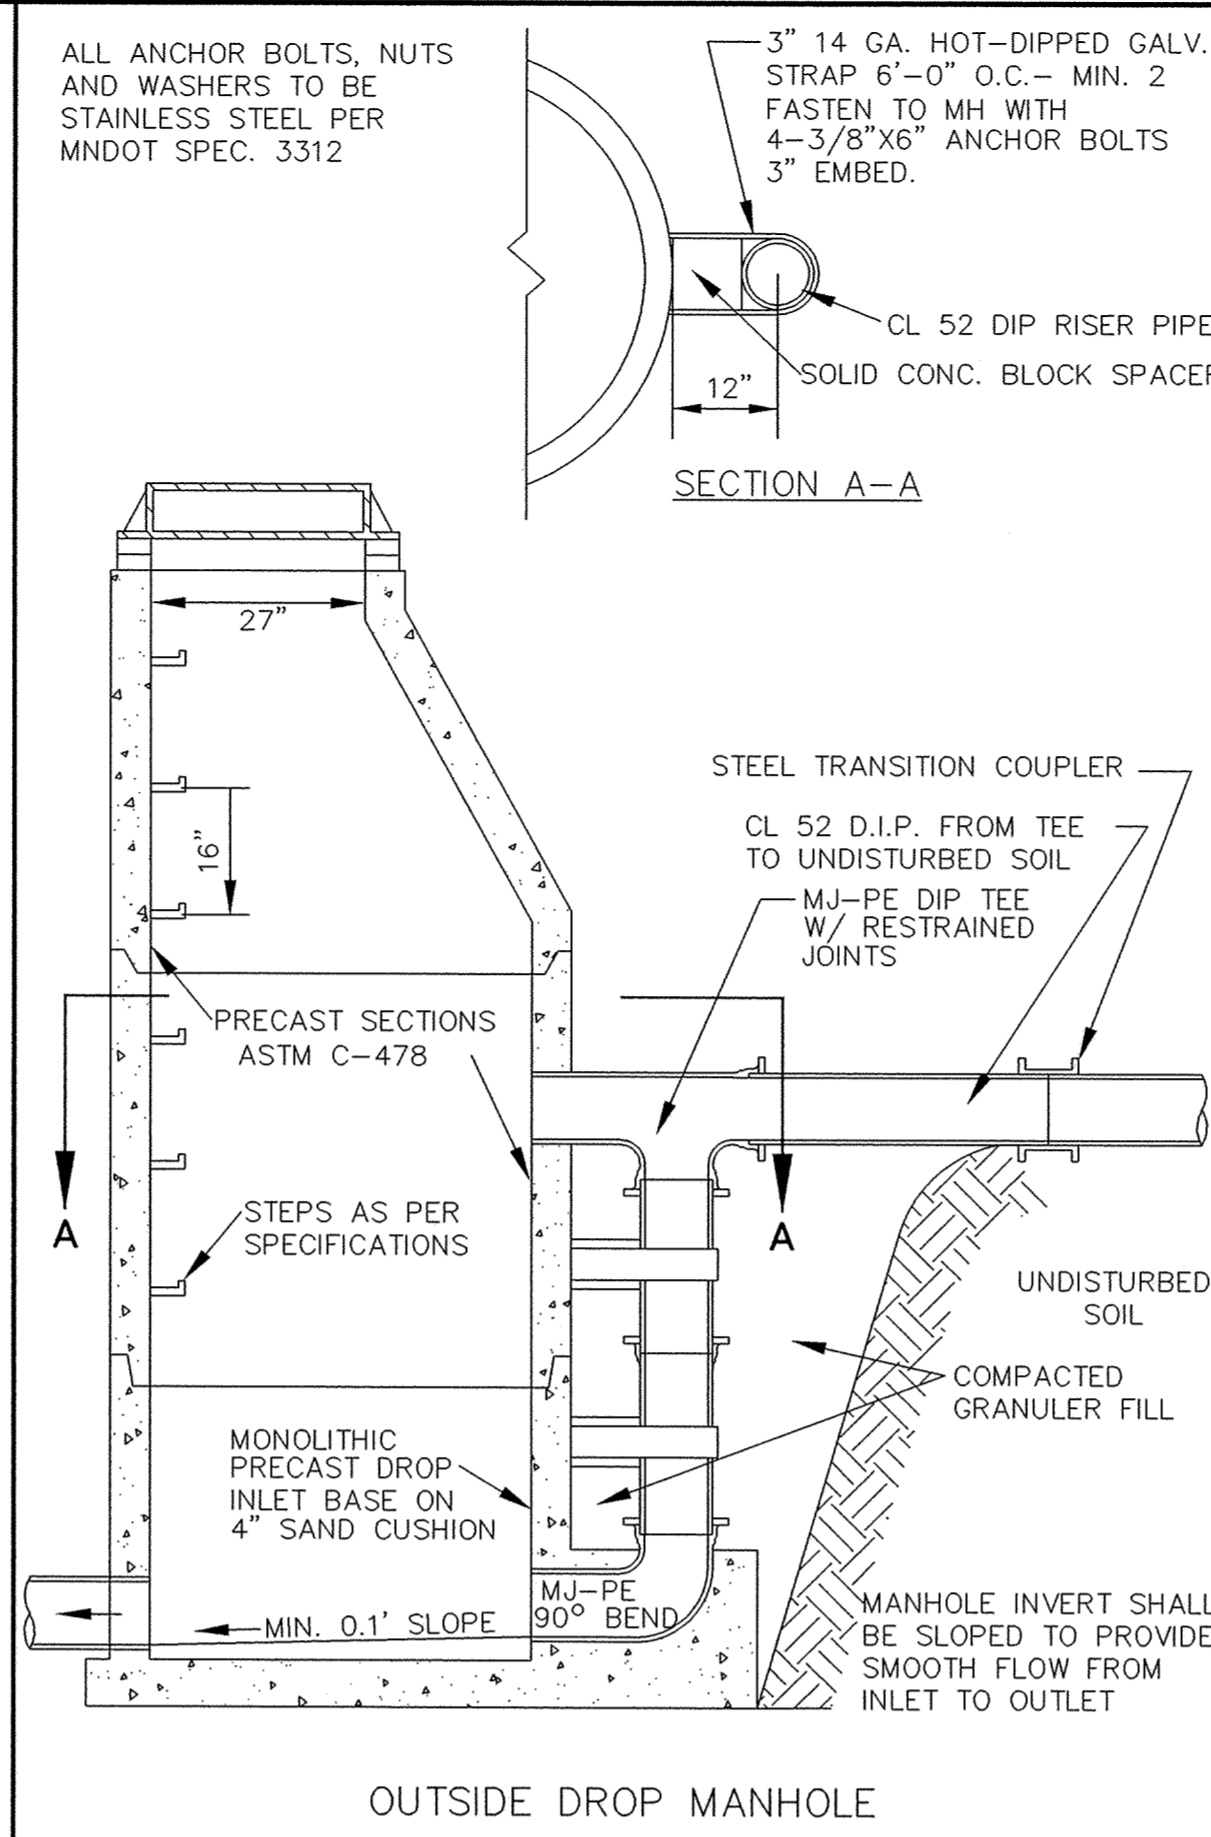


OUTSIDE DROP MANHOLE

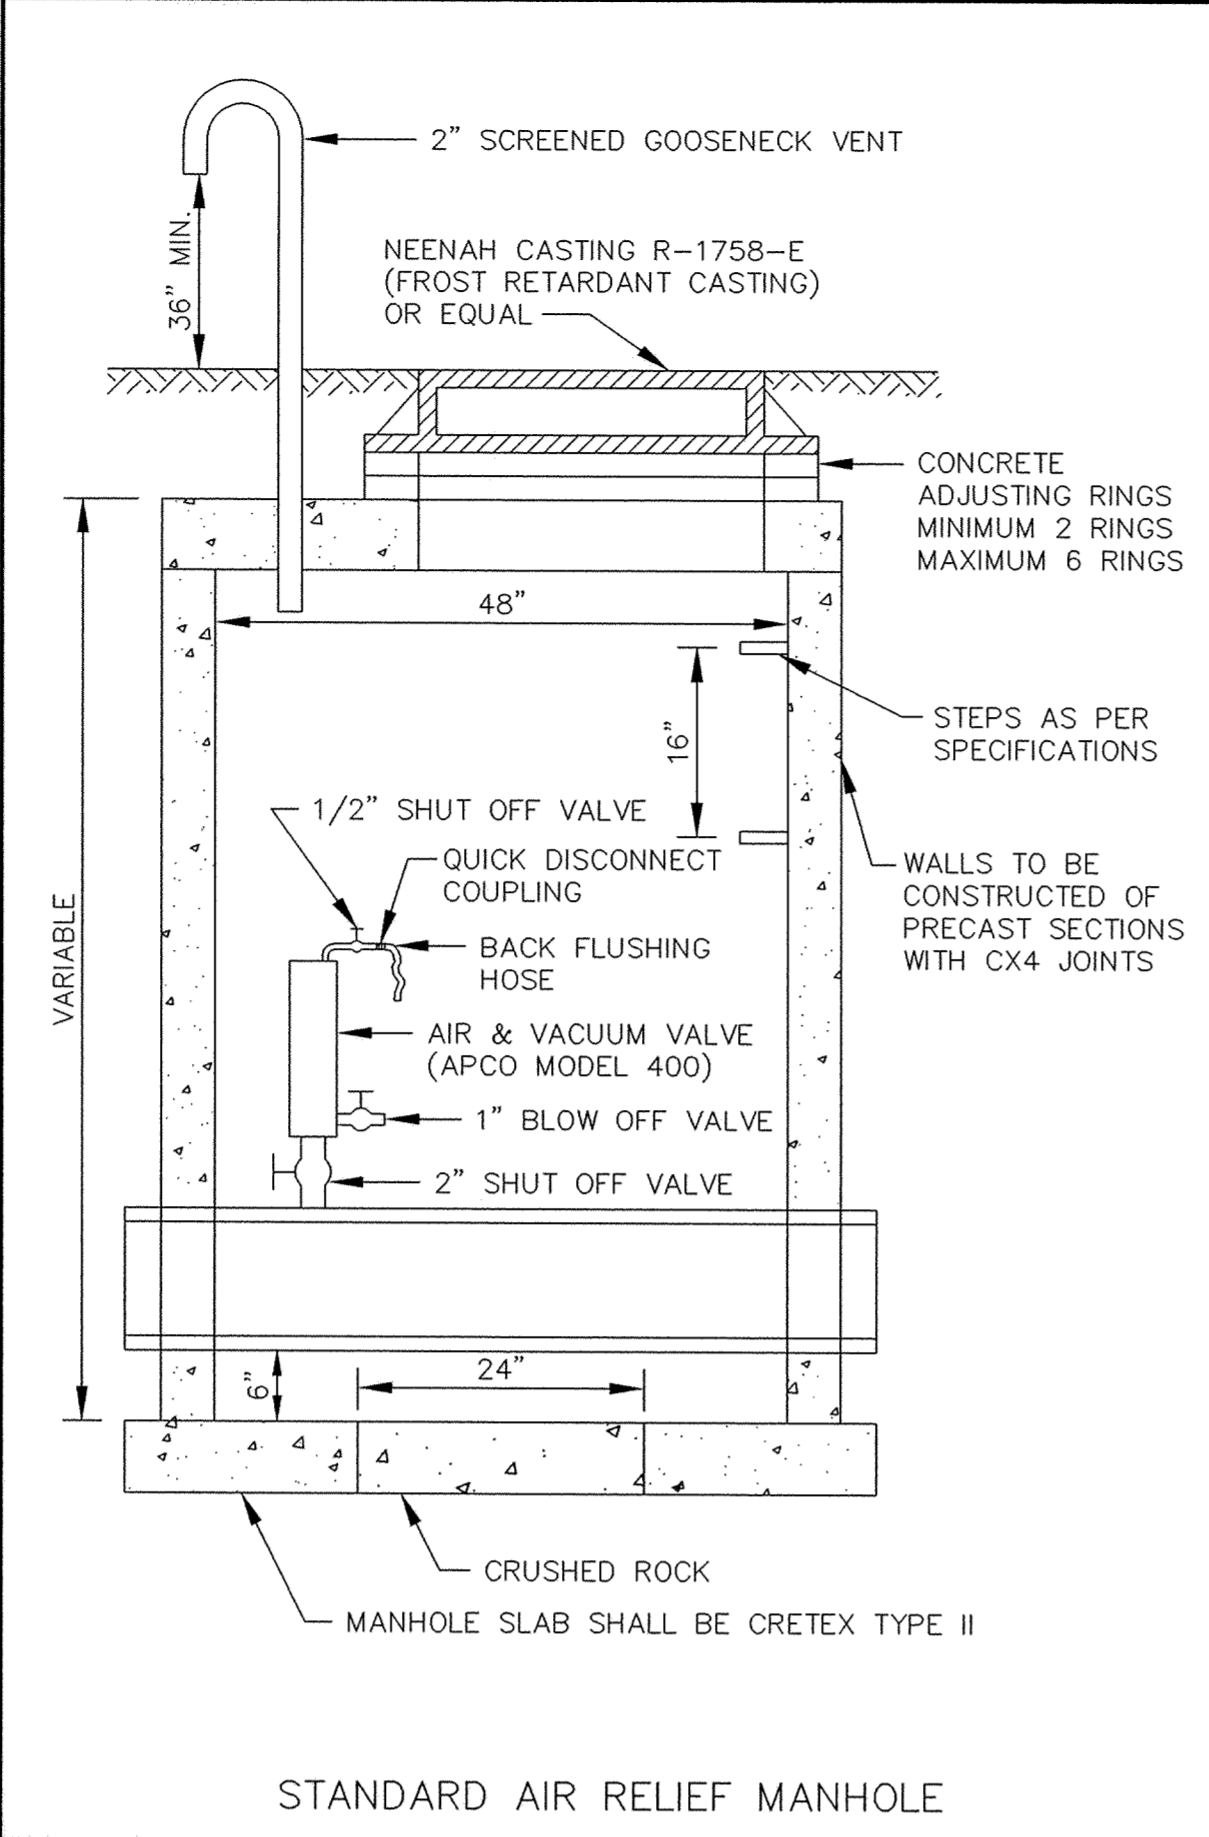


STANDARD AIR RELIEF MANHOLE

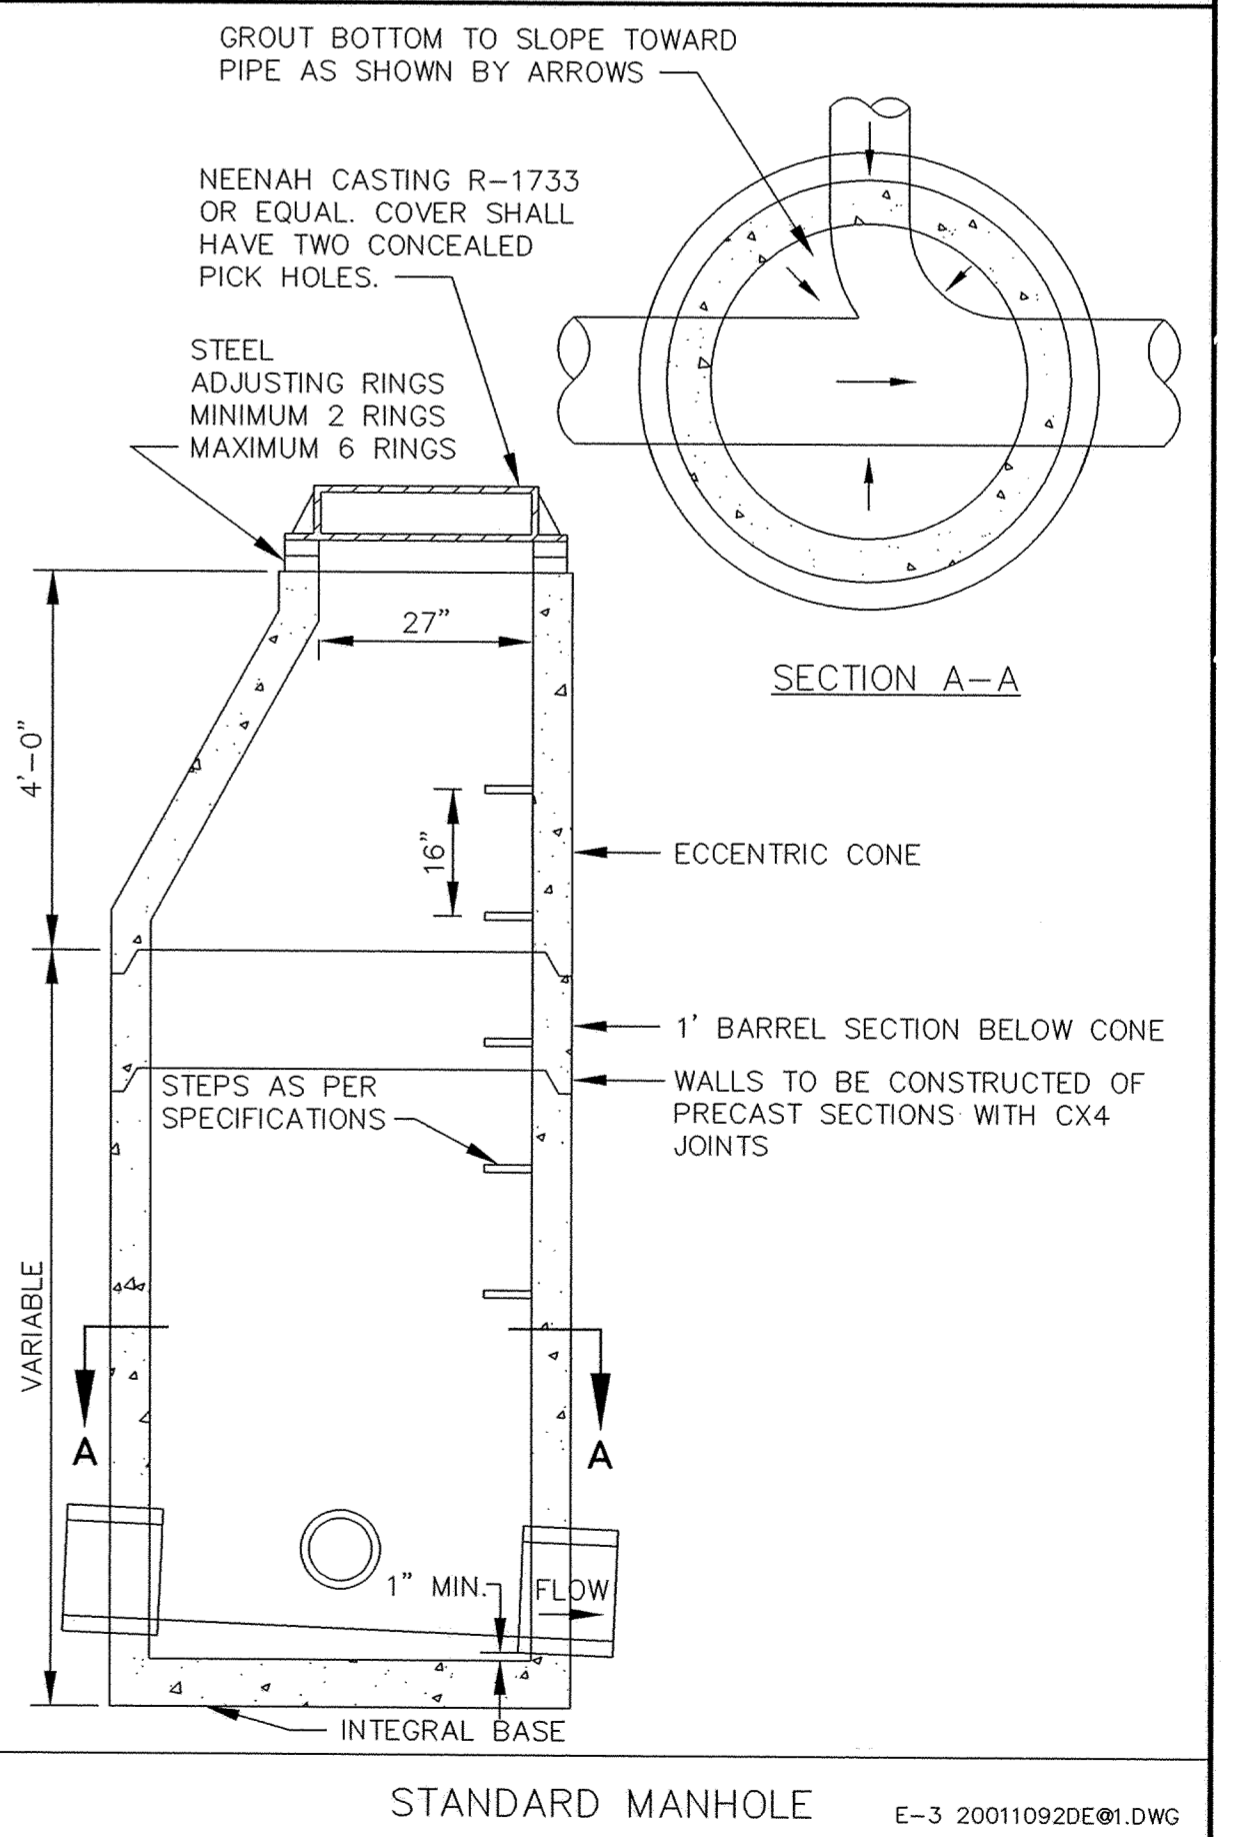


STANDARD MANHOLE

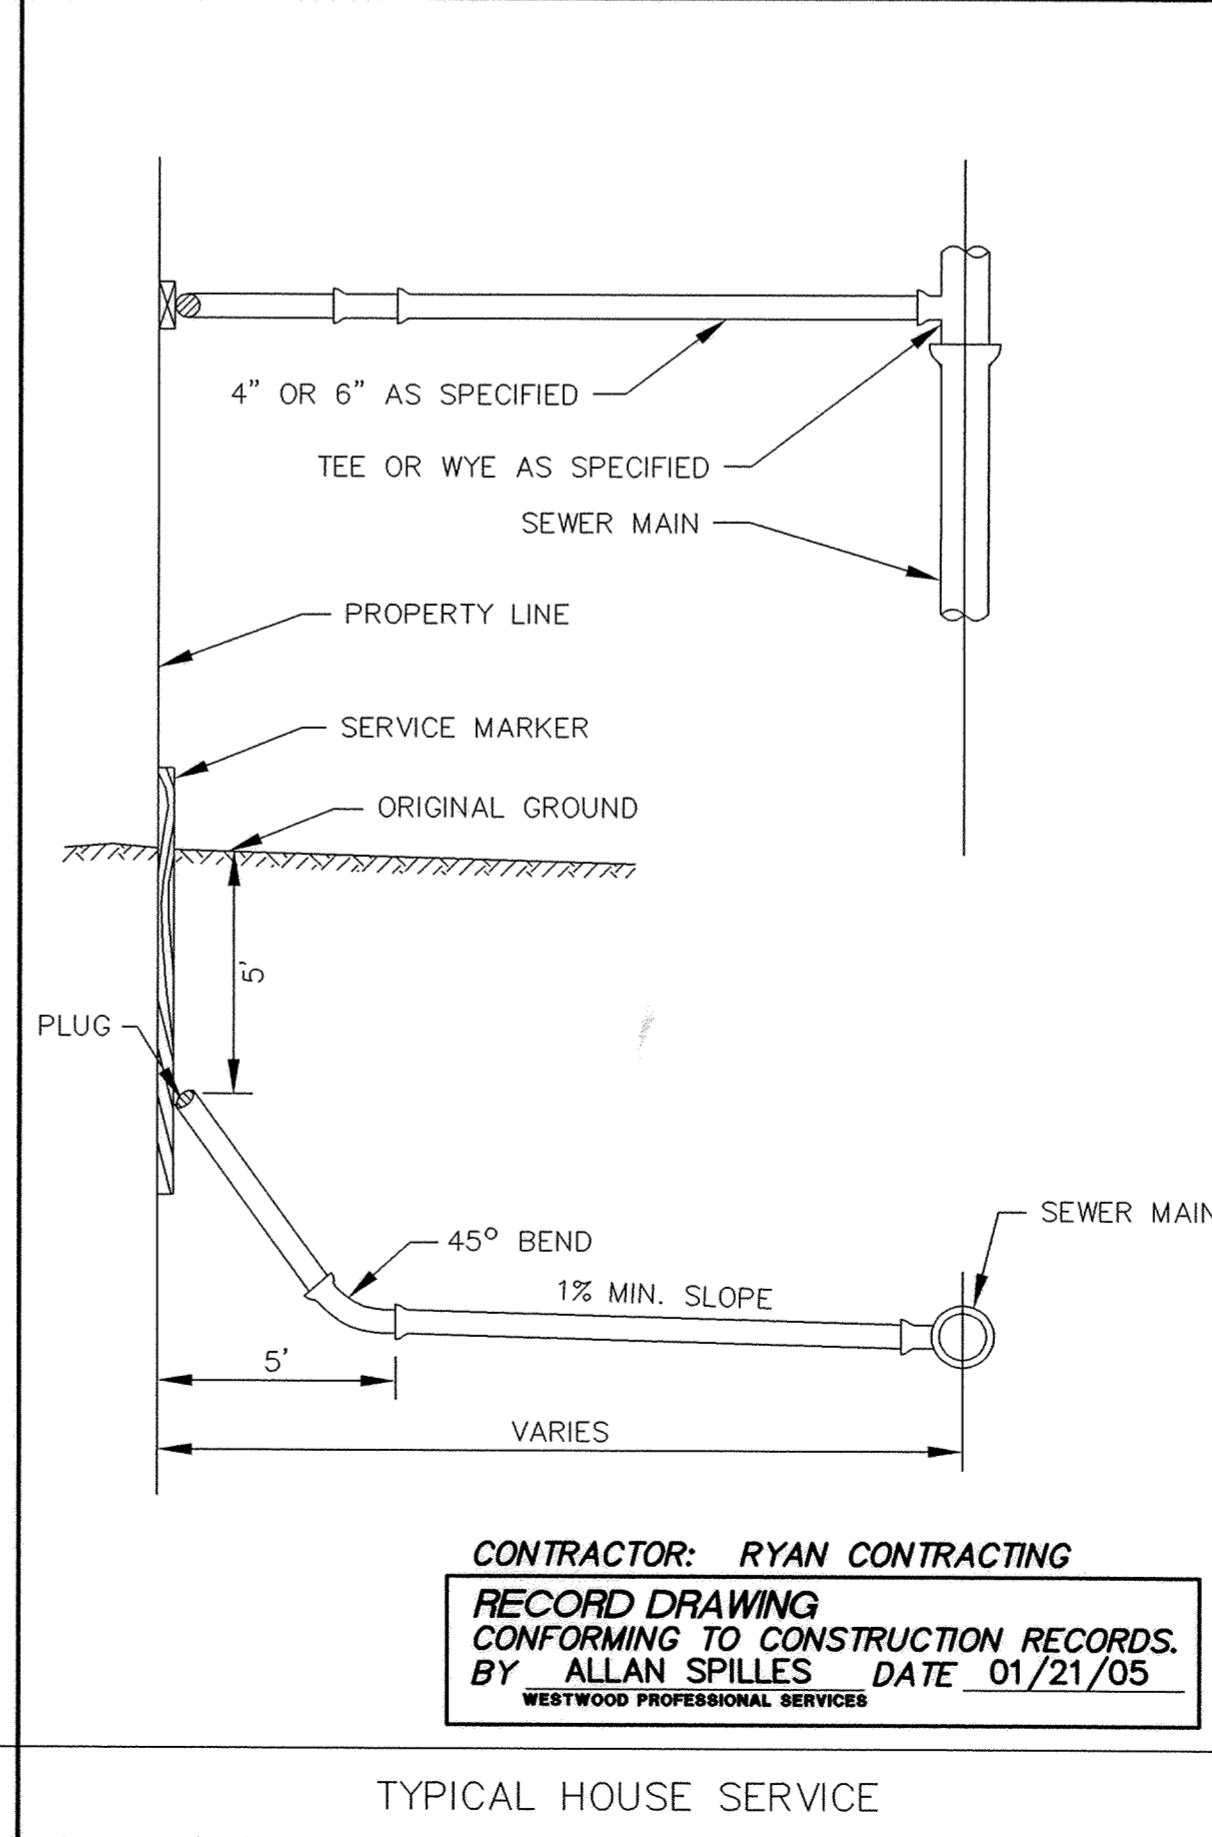

TYPICAL HOUSE SERVICE

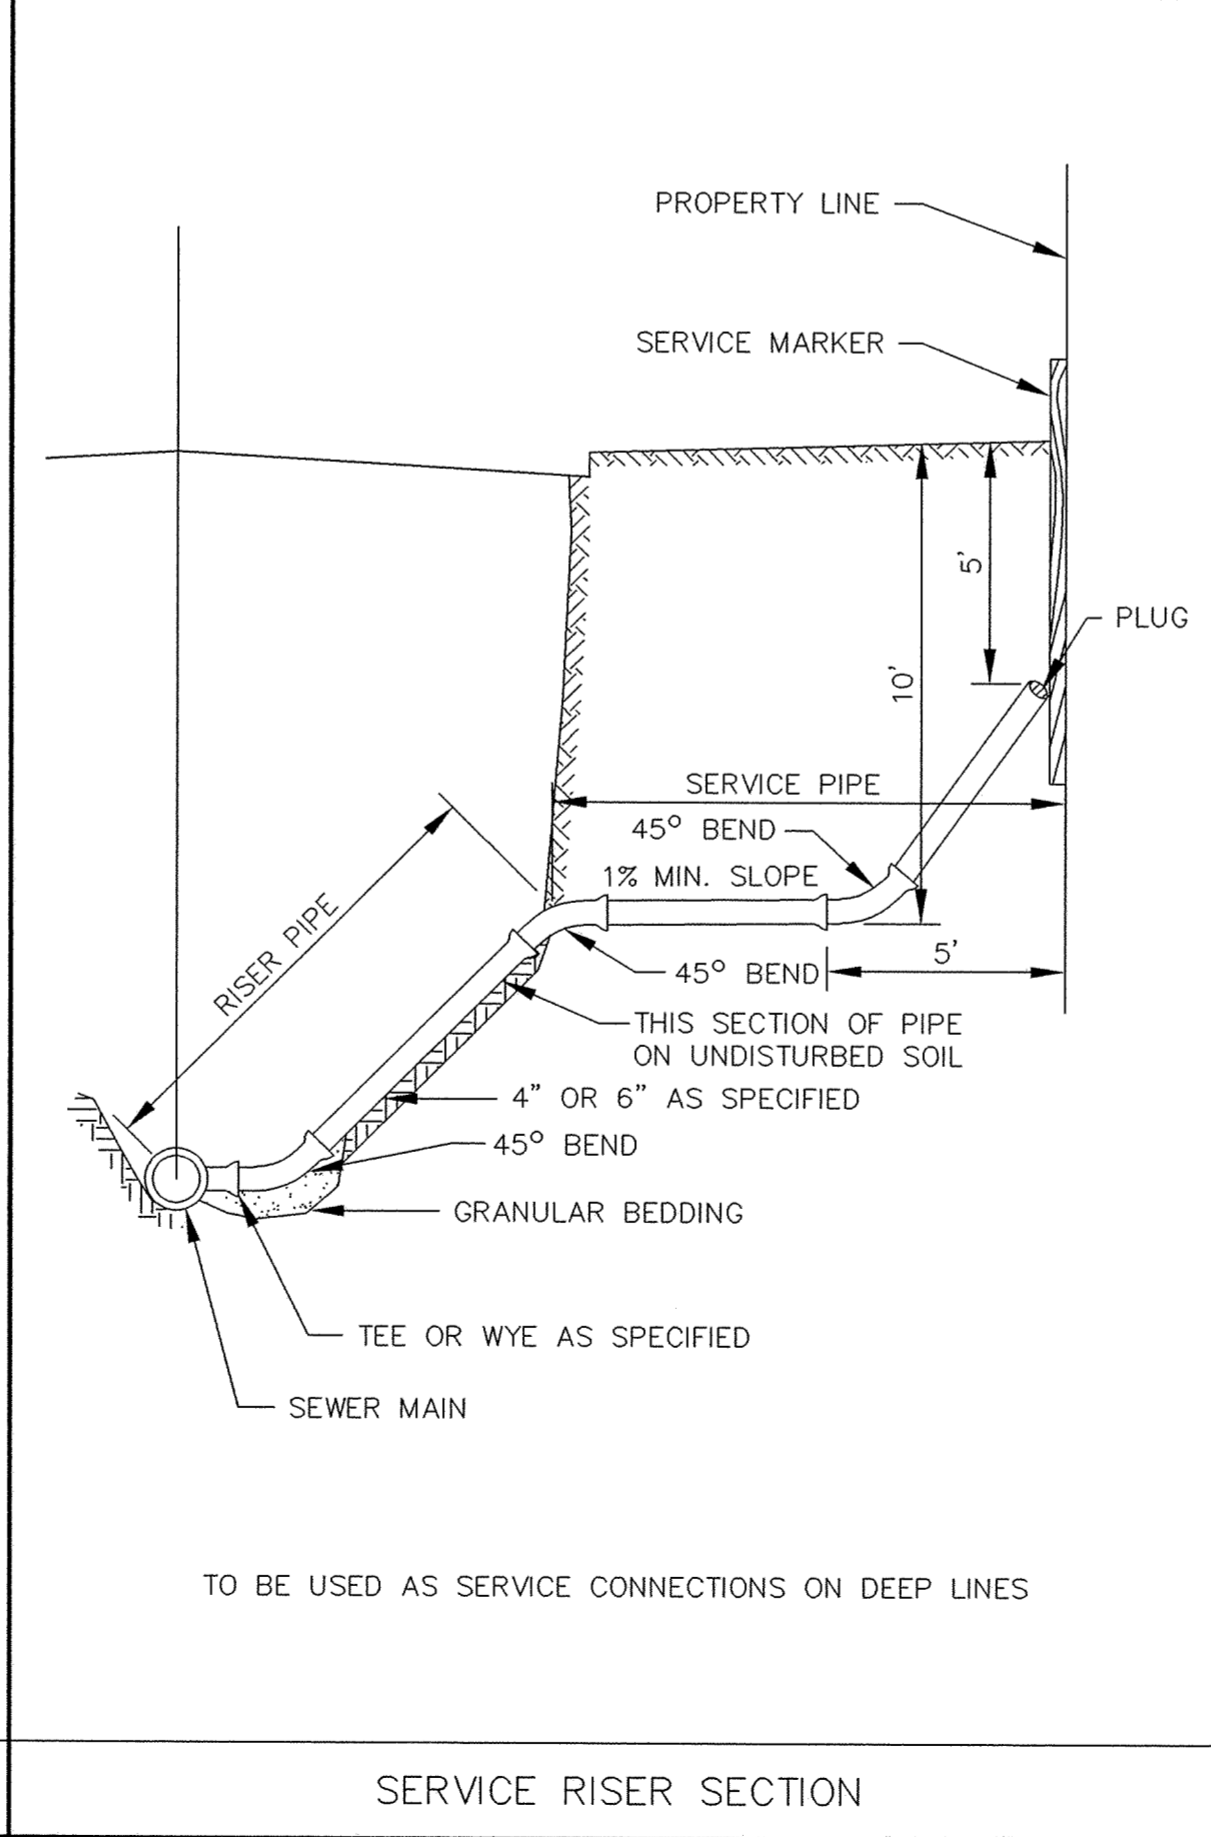

SERVICE RISER SECTION

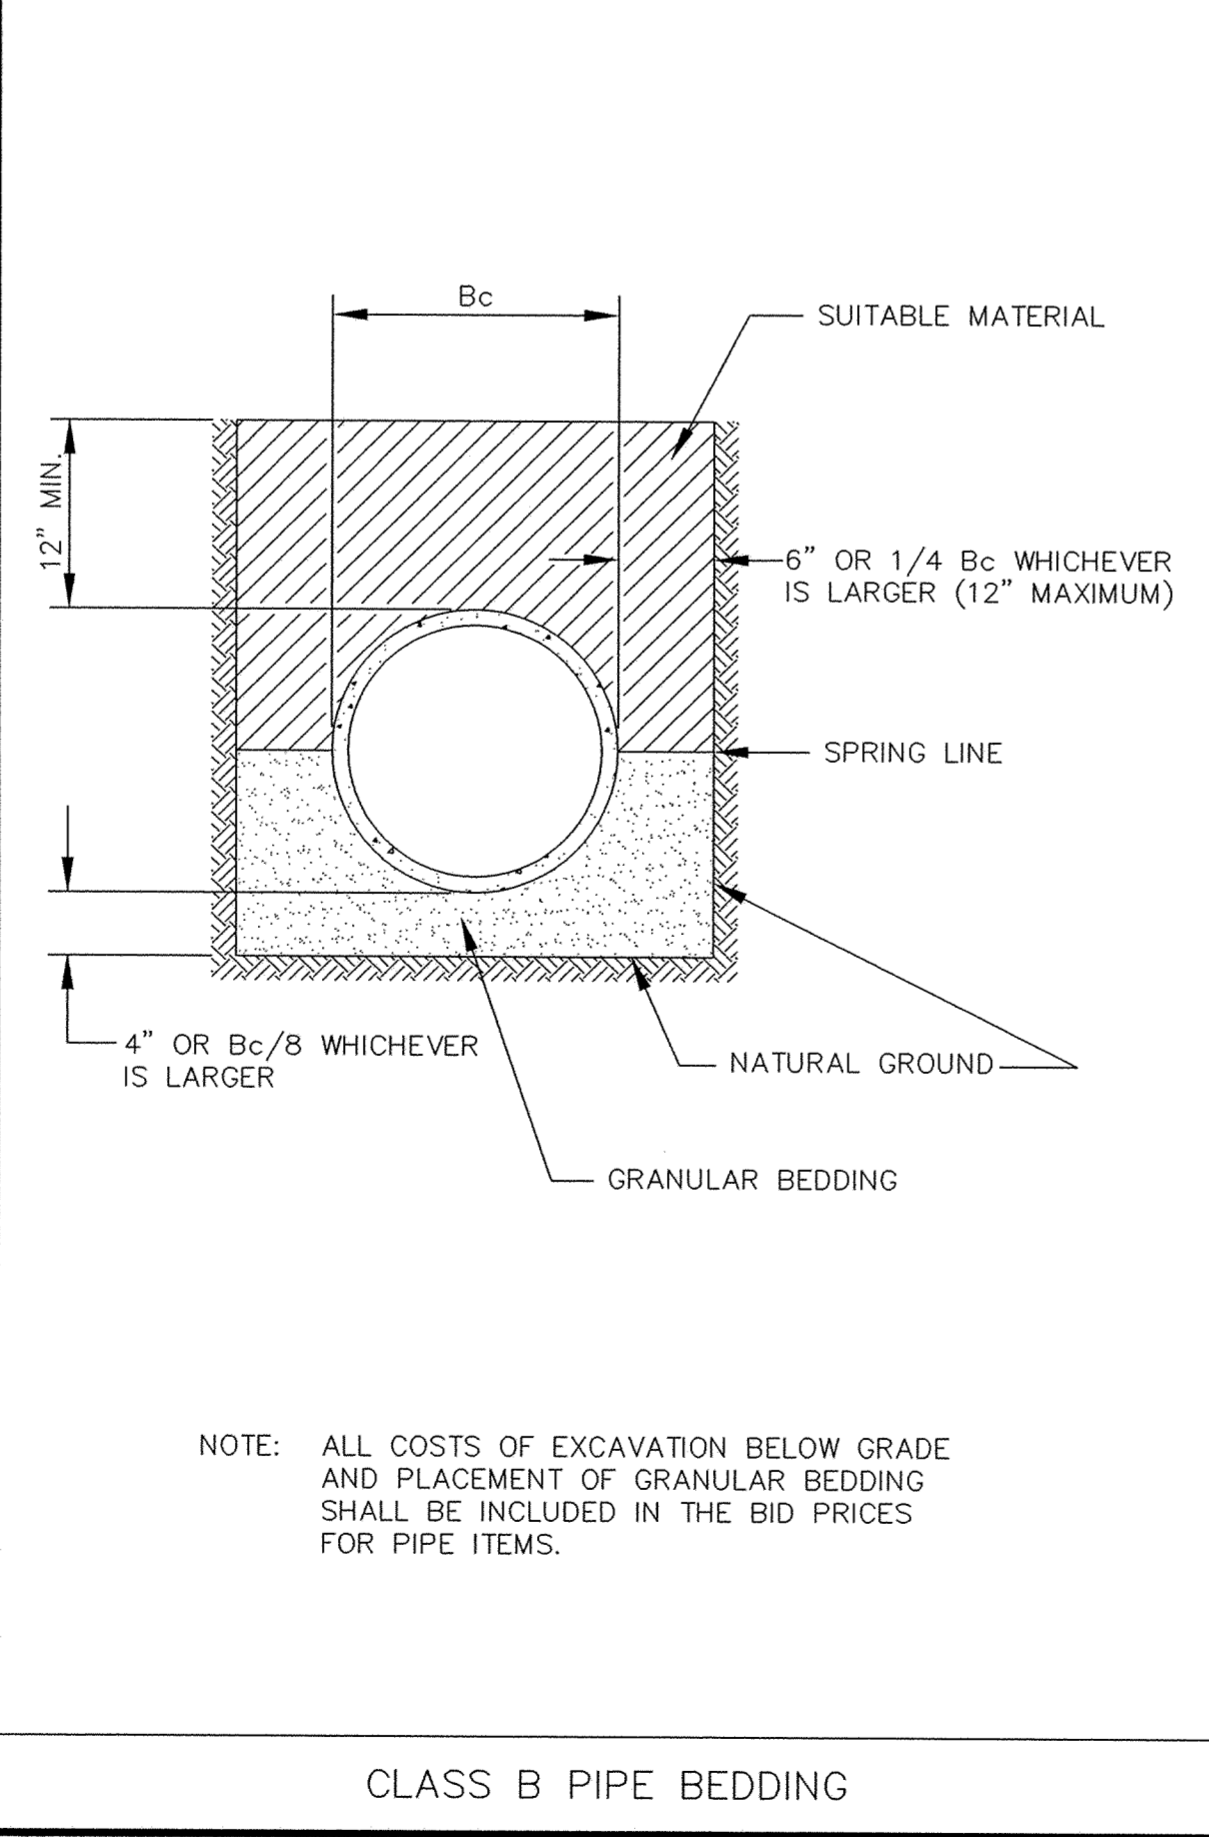

CLASS B PIPE BEDDING

Westwood Professional Services, Inc.
 7599 Anagram Drive
 Eden Prairie, MN 55344
 Phone: 952/937-5150 Fax: 952/937-5822

CENTEX HOMES

DESIGNED BY: --- DRAWN BY: ---
 APPROVED: --- JOB NUMBER ---
 CAD DATE: April 14, 1999 11:14:59 a.m.
 CAD FILE: 230000m\ER-SM.DWG

I HEREBY CERTIFY THAT THIS PLAN, SPECIFICATION, OR REPORT WAS PREPARED BY ME OR UNDER MY DIRECT SUPERVISION AND THAT I AM A DULY REGISTERED PROFESSIONAL ENGINEER UNDER THE LAWS OF THE STATE OF MINNESOTA.
 DATE: _____ REG. NO. _____

NO.	DATE	BY	REVISION DESCRIPTION
1	01/21/05	AS	RECORD DRAWING

Howard R. Green Company
 CONSULTING ENGINEERS
 1326 ENERGY PARK DRIVE
 ST. PAUL, MINNESOTA 55108
 (612) 644-4389

CITY OF ELK RIVER
MARSHES OF TROTT BROOK FARMS
SANITARY SEWER DETAILS

SHEET NO.
10
 OF
14

P:\20011092.dwg\RECORD\20011092DE@1.dwg 01/18/2005 03:25:26 PM CST

3D PRODUCTS • NEW HOPE, MINNESOTA
 SDCO PRODUCTS • NEW HOPE, MINNESOTA
 REVISION BY: DATE: 01/21/05
 10
 MTR01T.02
 SDCO PRODUCTS • NEW HOPE, MINNESOTA
 REVISION BY: DATE: 01/21/05