

Westwood Professional Services, Inc.
 7599 Anagram Drive
 Eden Prairie, MN 55344
 Phone: 952/937-5150 Fax: 952/937-5822

PREPARED FOR:
D. R. Horton, Inc.
 20860 Kenbridge Court
 Lakeville, Minnesota 55044

HOWARD R. GREEN COMPANY
 CONSULTING ENGINEERS

1326 ENERGY PARK DRIVE
 ST. PAUL, MINNESOTA 55108
 (612) 644-4389

CITY OF ELK RIVER
 MARSHES OF TROTT BROOK FARMS
 STREET CONSTRUCTION DETAILS

CONTRACTOR: RYAN CONTRACTING
RECORD DRAWING
 CONFORMING TO CONSTRUCTION RECORDS.
 BY ALLAN SPILLES DATE 01/21/05
 WESTWOOD PROFESSIONAL SERVICES


E-3 20011092DEF4.DWG

DESIGNED BY: _____ DRAWN BY: _____
 APPROVED: _____ JOB NUMBER: _____
 CAD DATE: April 14, 1999 11:17:32 a.m.
 CAD FILE: 230000m\er-ST.DWG

I HEREBY CERTIFY THAT THIS PLAN, SPECIFICATION, OR REPORT WAS PREPARED BY ME OR UNDER MY DIRECT SUPERVISION AND THAT I AM A DULY REGISTERED PROFESSIONAL ENGINEER UNDER THE LAWS OF THE STATE OF MINNESOTA.

DATE: _____ REG. NO.: _____

NO.	DATE	BY	REVISION DESCRIPTION
1	01/21/05	AS	RECORD DRAWING

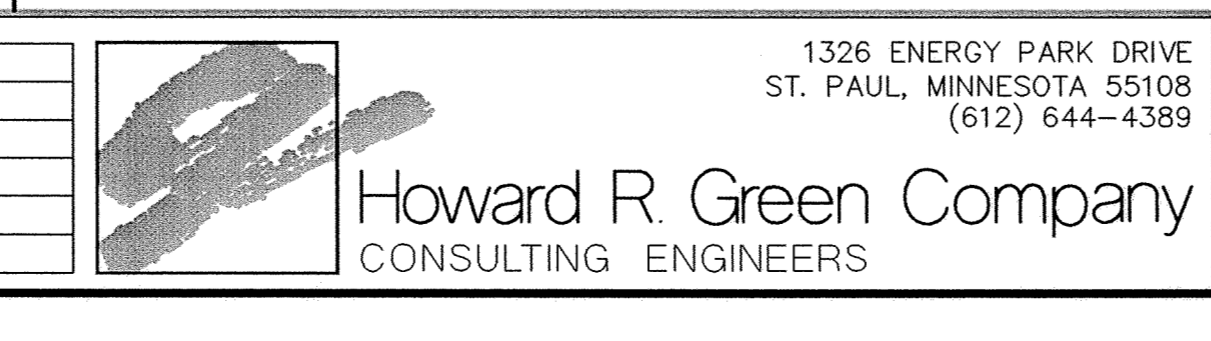

SHEET NO. **13** OF **14**

SHEET NO. **13** OF **14**

P:\20011092\dwg\RECORD\20011092DEF4.dwg 01/18/2005 03:32:22 PM CST

SAECO PRODUCTS • NEW HOPE, MINNESOTA
 REFERENCED BY PART NUMBER 6052
 SAECO PRODUCTS • NEW HOPE, MINNESOTA
 REFERENCED BY PART NUMBER 6052
 SAECO PRODUCTS • NEW HOPE, MINNESOTA
 REFERENCED BY PART NUMBER 6052
 SAECO PRODUCTS • NEW HOPE, MINNESOTA
 REFERENCED BY PART NUMBER 6052