



WEST MAIN STREET

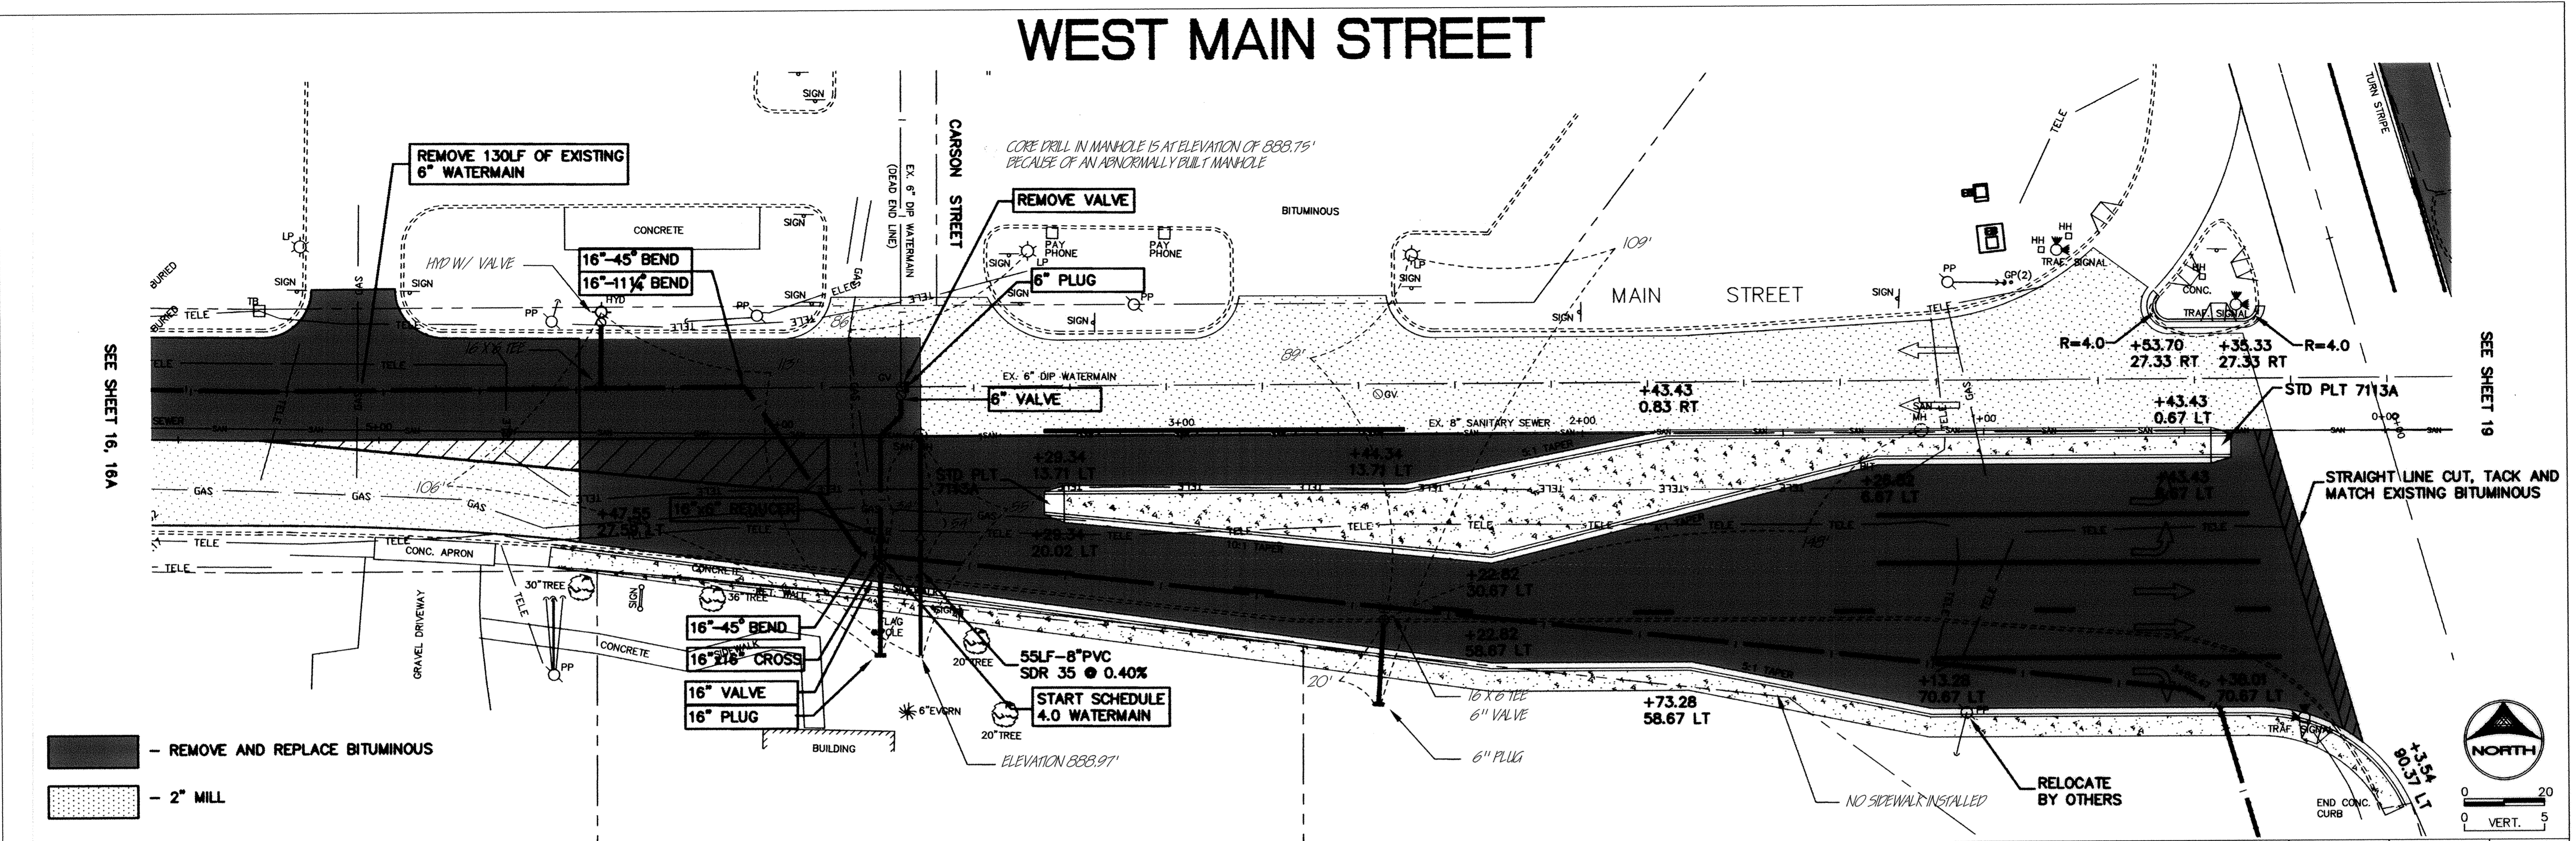

- REMOVE AND REPLACE BITUMINOUS
 - 2" MILL

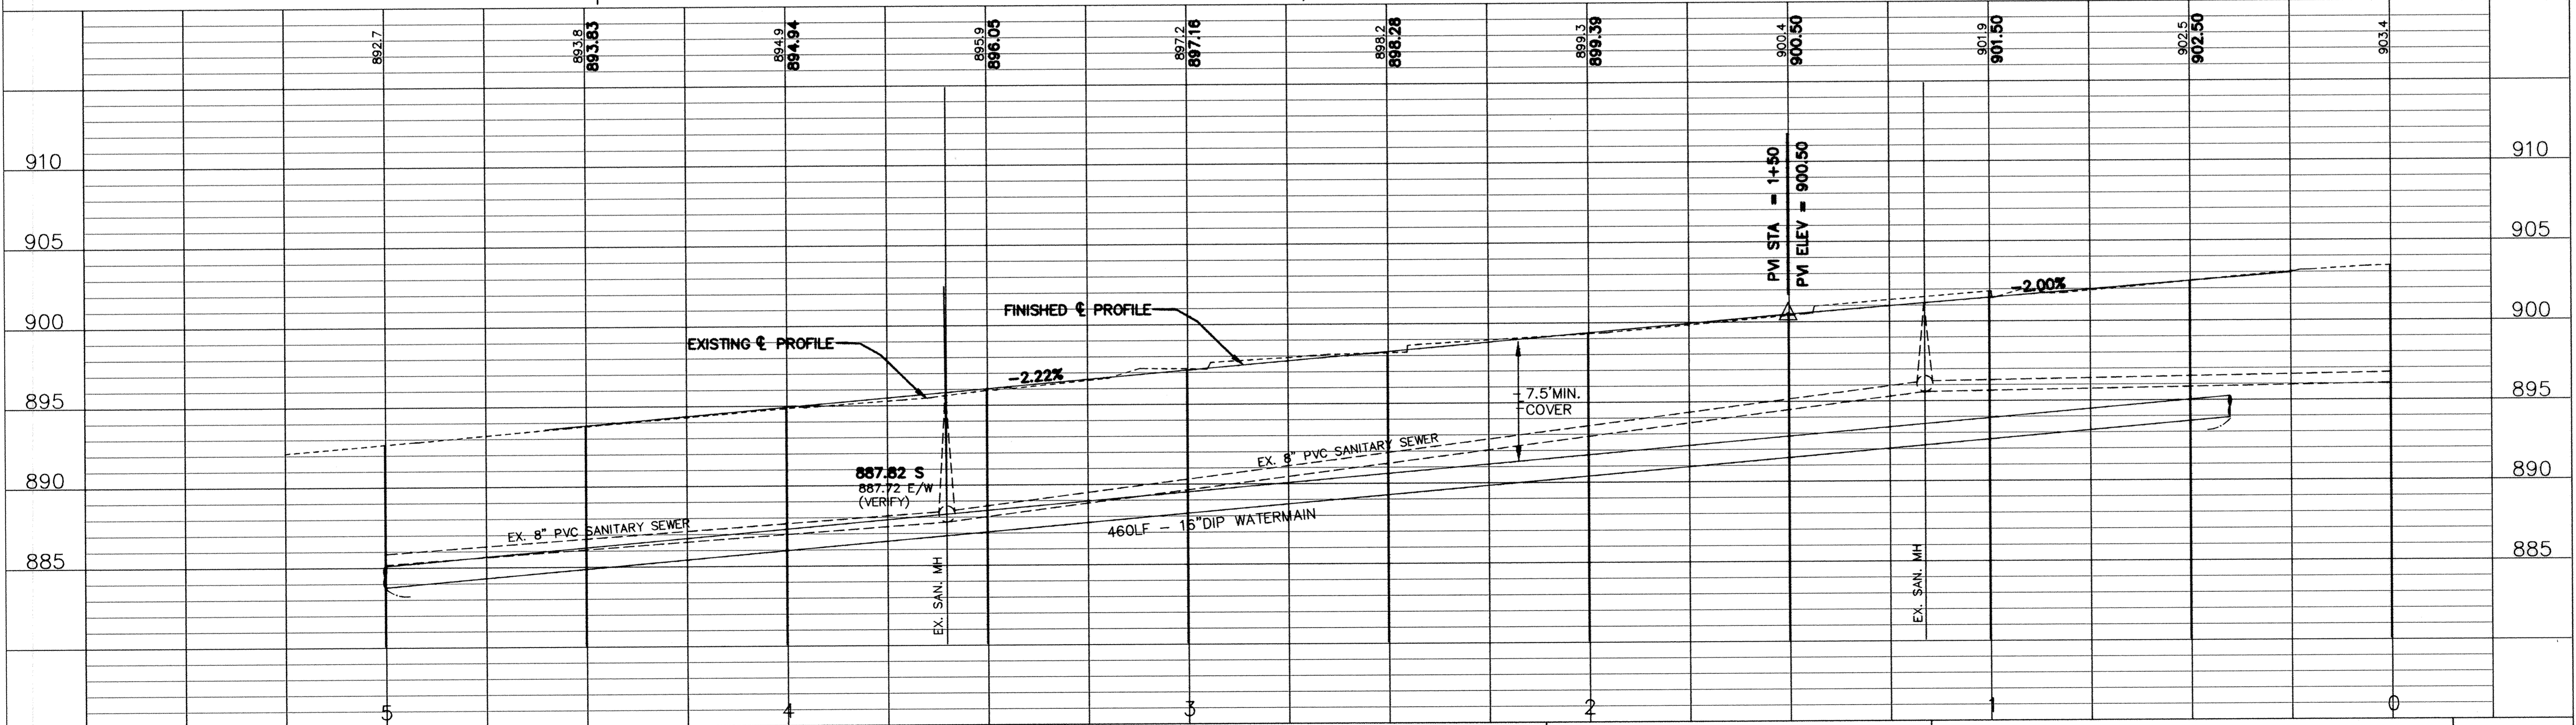

DESIGNED BY: DESIGNED_BY DRAWN BY: EY
 APPROVED BY: APPROVED_BY JOB NUMBER 808200
 CAD DATE: March 24, 2004 10:44:03 a.m.
 CAD FILE: 808200\ASBUILT\808200P-4 ASB.DWG (RMONJEA)

I HEREBY CERTIFY THAT THIS PLAN, SPECIFICATION, OR REPORT WAS PREPARED BY ME OR UNDER MY DIRECT SUPERVISION AND THAT I AM A DULY REGISTERED PROFESSIONAL ENGINEER UNDER THE LAWS OF THE STATE OF MINNESOTA.
 DATE _____ REG. NO. _____

NO.	DATE	BY	REVISION DESCRIPTION


Howard R. Green Company
 CONSULTING ENGINEERS
 1326 ENERGY PARK DRIVE
 ST. PAUL, MINNESOTA 55108
 (651) 644-4389

CITY OF ELK RIVER
 EASTERN AREA PHASE III
 STREET AND UTILITY IMPROVEMENTS

PLAN AND PROFILE
 WEST MAIN STREET
 S.A.P. 204-113-09 4+00 TO 0+00

SHEET NO.
 17
 OF
 46

SARGO PRODUCTS • NEW HARBOR, MINNESOTA
 REPRODUCED BY PART NUMBER 808200
 EXISTING CONDITIONS OF STREET AND UTILITIES
 SARGO PRODUCTS • NEW HARBOR, MINNESOTA
 REPRODUCED BY PART NUMBER 808200
 EXISTING CONDITIONS OF STREET AND UTILITIES
 SARGO PRODUCTS • NEW HARBOR, MINNESOTA
 REPRODUCED BY PART NUMBER 808200
 EXISTING CONDITIONS OF STREET AND UTILITIES