MINNESOTA DEPARTMENT OF TRANSPORTATION


CONSTRUCTION PLAN FOR SANITARY SEWER, STORM SEWER, WATERMAIN & STREET CONSTRUCTION

MILES

... MILES

... MILES


RAILROAD DRIVE LOCATED ON MAIN ST. STATE PROJ. NO. STATE PROJ. NO. 204-113-01 MINN. PROJ. NO. MINN. PROJ. NO. GROSS LENGTH... FEET 0.513 MILES GROSS LENGTH 2712 BRIDGES-LENGTH... FEET O MILES BRIDGES-LENGTH... EXCEPTIONS-LENGTH ... FEET 0.021 MILES EXCEPTIONS-LENGTH 113 NET LENGTH .. FEET 0.492 MILES NET LENGTHTO MILE POINT.... MILE POINT. TO MILE POINT... MILE POINT...

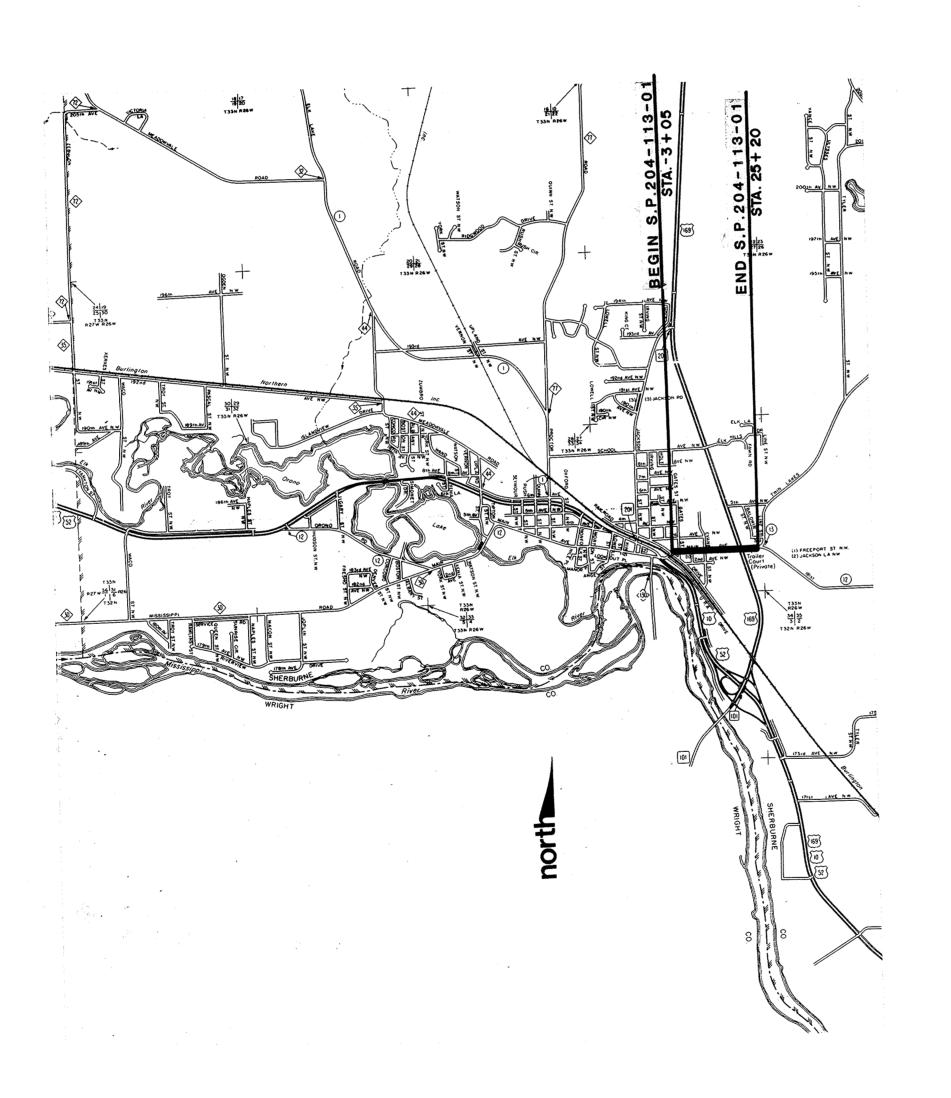

SCALES					
P LA N	0	50			
PROFILE		5			
INDEX MAP					
GENERAL LAYOUT					

	PLAN REVISIO	NS
DATE	SHEET NO.	APPROVED BY

	D	ESIGN DESIG	NATION		
ADT (Current Year)198: ADT (Future Year) 2003			Design Speed Based on	MPH Sight Dis	tance
SOIL FACTOR 9 TON DESIGN	<i>=</i>	50%	Height of eye	Height of not achieved at:	object
T (Heavy Commercial)				TO STA	
N18		1,047,300 70	STA	TO STA.	MPH

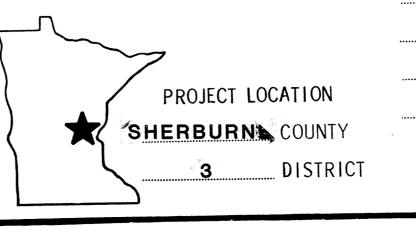

FED. PROJ. NO.

GOVERNING SPECIFICATIONS

THE 1983 EDITION OF THE MINNESOTA DEPARTMENT OF TRANSPORTATION "STANDARD SPECIFICATIONS FOR CONSTRUCTION" SHALL GOVERN.

INDEX

13-15. STANDARD PLATES

1.COVER SHEET 2.ESTIMATED QUANTITIES 3. SANITARY SEWER PLAN & PROFILE 4.& 5.STORM SEWER PLAN & PROFILE 6.,7.& 8.STREET CONSTRUCTION PLAN & PROFILE 9.& 10. SIGNING & STRIPING 11.& 12.CROSS SECTIONS

I HEREBY CERTIFY THAT THIS PLAN WAS PREPARED BY ME OR

١	DATE 10/14/83 REG.	NO. 15316 ENGR. Terry	Maurer
	DESIGN SQUAD	• •	
			,
	Right of Way Approval	DIRECTOR, RIGHT OF WAY OPERATI	19
	Recommended for Annroval	DISTRICT DIRECTOR TO	10- 19 83
		DISTRICT BITTESTON	
	Decommended for Annroval	Delvert D. Oftedahl	11-15- 1983
	Recommended for Approvat	PLANSENGINEER	
	Decommended for Approval		19
	Recommended for Approval	DESIGN SERVICES DIRECTO	7
	Decemmended for Approval		19
1	Recommended for Approval		- /

DEPARTMENT OF TRANSPORTATION FEDERAL HIGHWAY ADMINISTRATION

DIVISION ADMINISTRATOR

APPROVED

I HEREBY CERTIFY THAT THE FINAL FIELD REVISIONS, IF ANY, OF THIS PLAN WERE MADE BY ME OR UNDER MY DIRECT SUPERVISION AND THAT I AM A DULY REGISTERED PROFESSIONAL ENGINEER UNDER THE LAWS OF THE STATE

204-113-01 STATE AID PROJ.

FOR PLANS AND UTILITIES SYMBOLS SEE TECHNICAL MANUAL

STATE PROJ. NO.

AS-BUILT

DRAWN BY: MRK Date 2.4.85

SHEET NO.

OF 14 SHEETS

DATE