
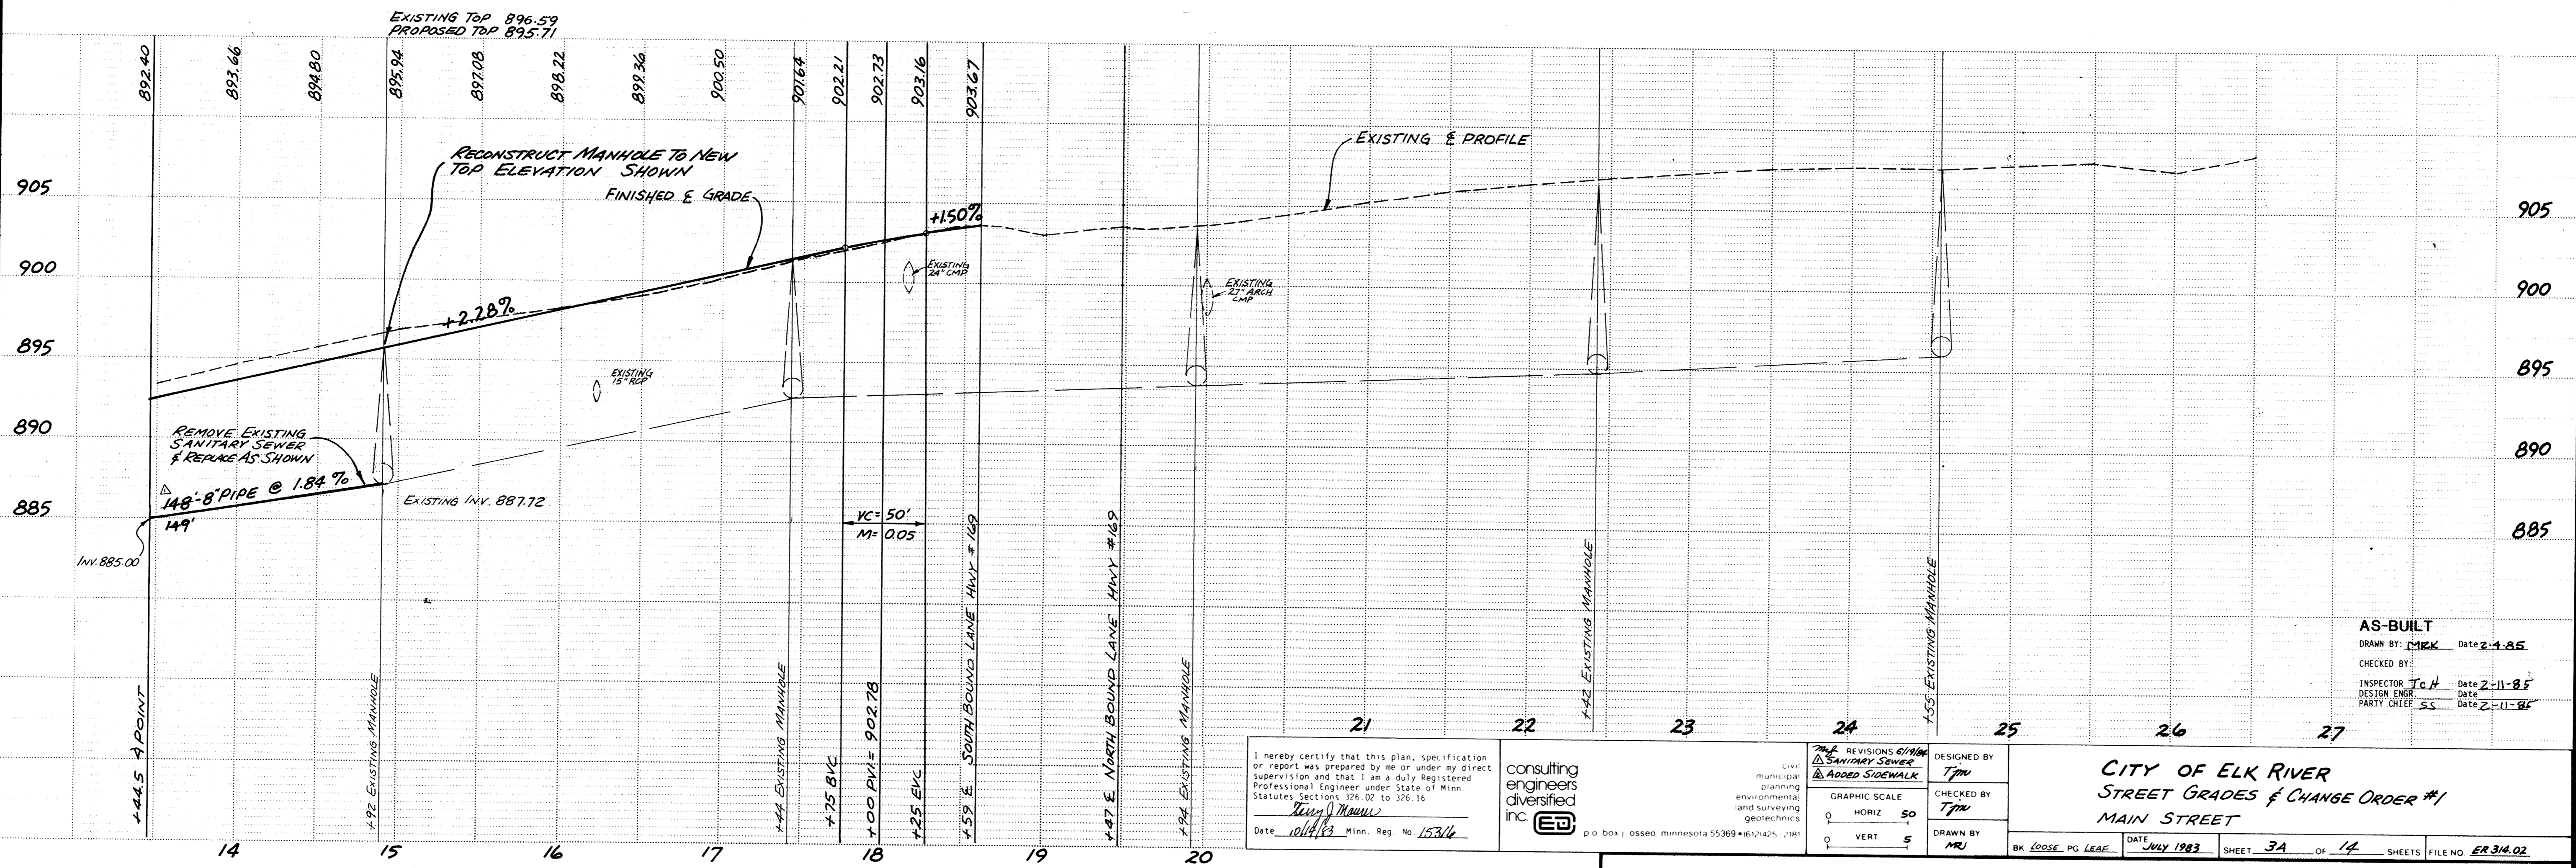


MAIN STREET

NOTE: LOCATION OF SIDEWALK TO BE DETERMINED BY THE ENGINEER IN THE FIELD.

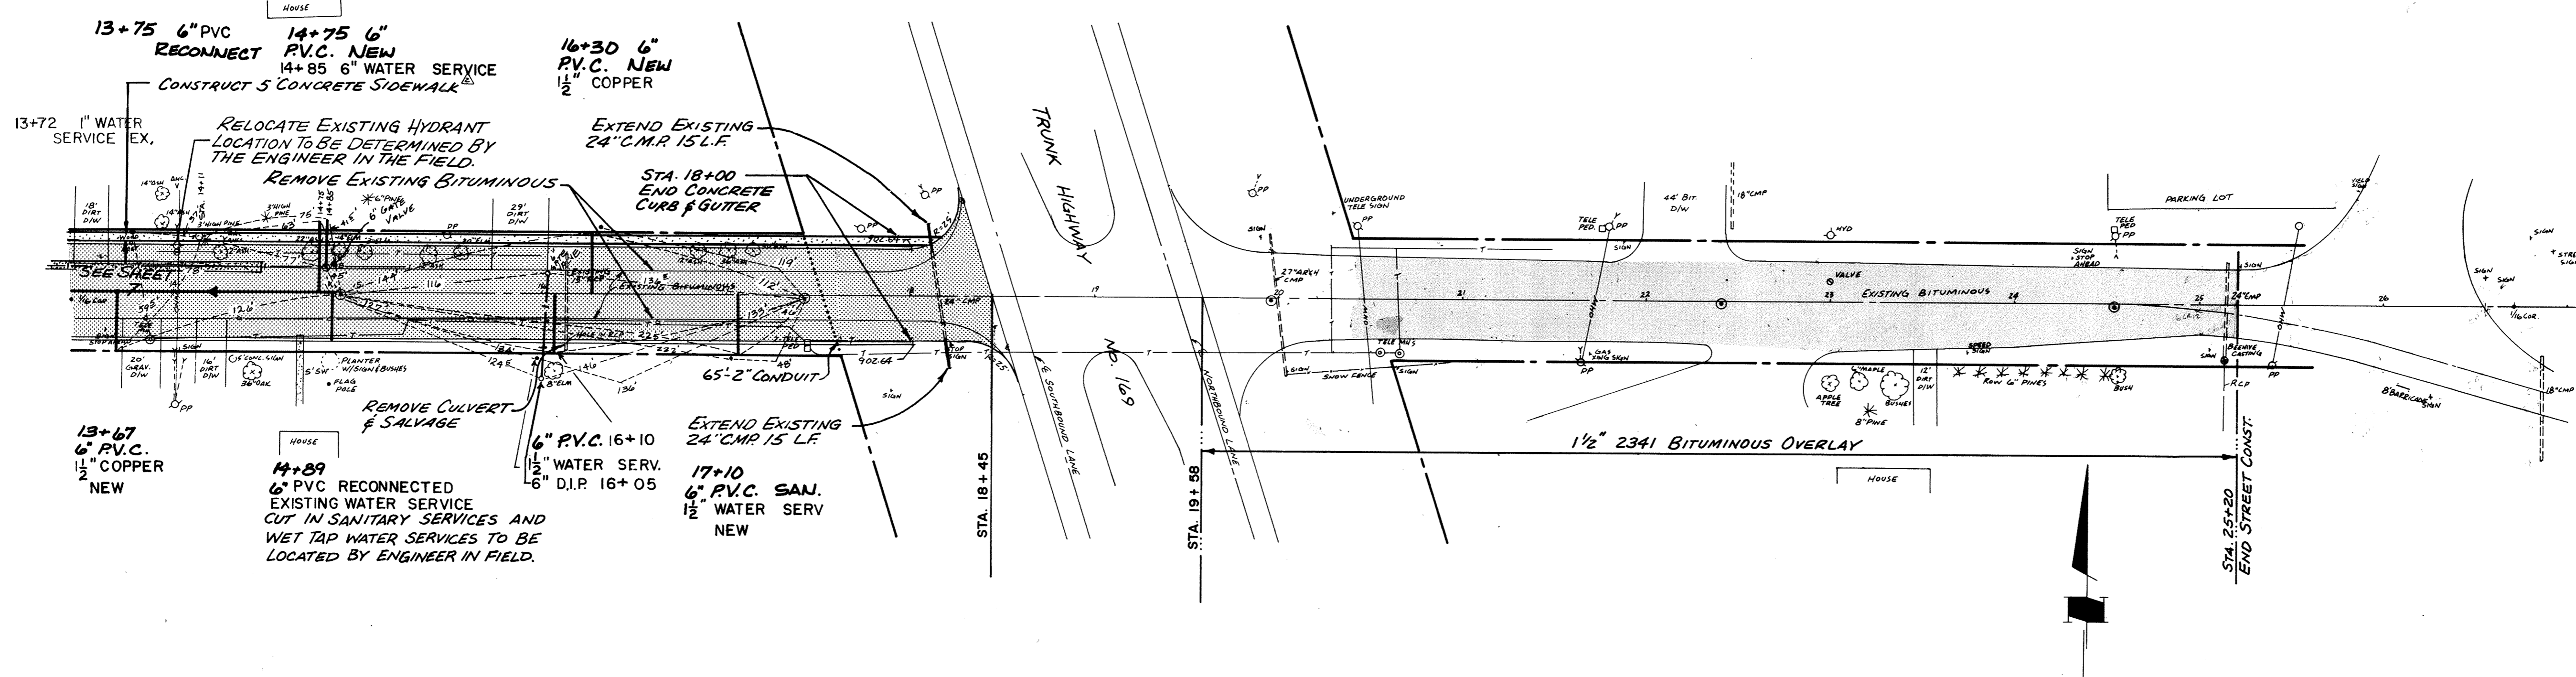

AS-BUILT
 DRAWN BY: MEK Date 2-4-85
 CHECKED BY:
 INSPECTOR JCH Date 2-11-85
 DESIGN ENGR. Date
 PARTY CHIEF SS Date 2-11-85

I hereby certify that this plan, specification or report was prepared by me or under my direct supervision and that I am a duly Registered Professional Engineer under State of Minnesota Statutes, Sections 326.02 to 326.16.
 Terry J. Munn
 Date 10/14/83 Minn. Reg. No. 15316

consulting engineers diversified inc.
 601 E. Broadway
 St. Paul, MN 55102
 (612) 225-2181

DESIGNED BY: Tjm
 CHECKED BY: Tjm
 DRAWN BY: MRJ

CITY OF ELK RIVER
STREET GRADES & CHANGE ORDER #1
MAIN STREET
 DATE: JULY 1983 SHEET 3A OF 14 SHEETS FILE NO. ER 314.02

DRAWING NUMBER MAINS 83 3A