



# MAIN STREET

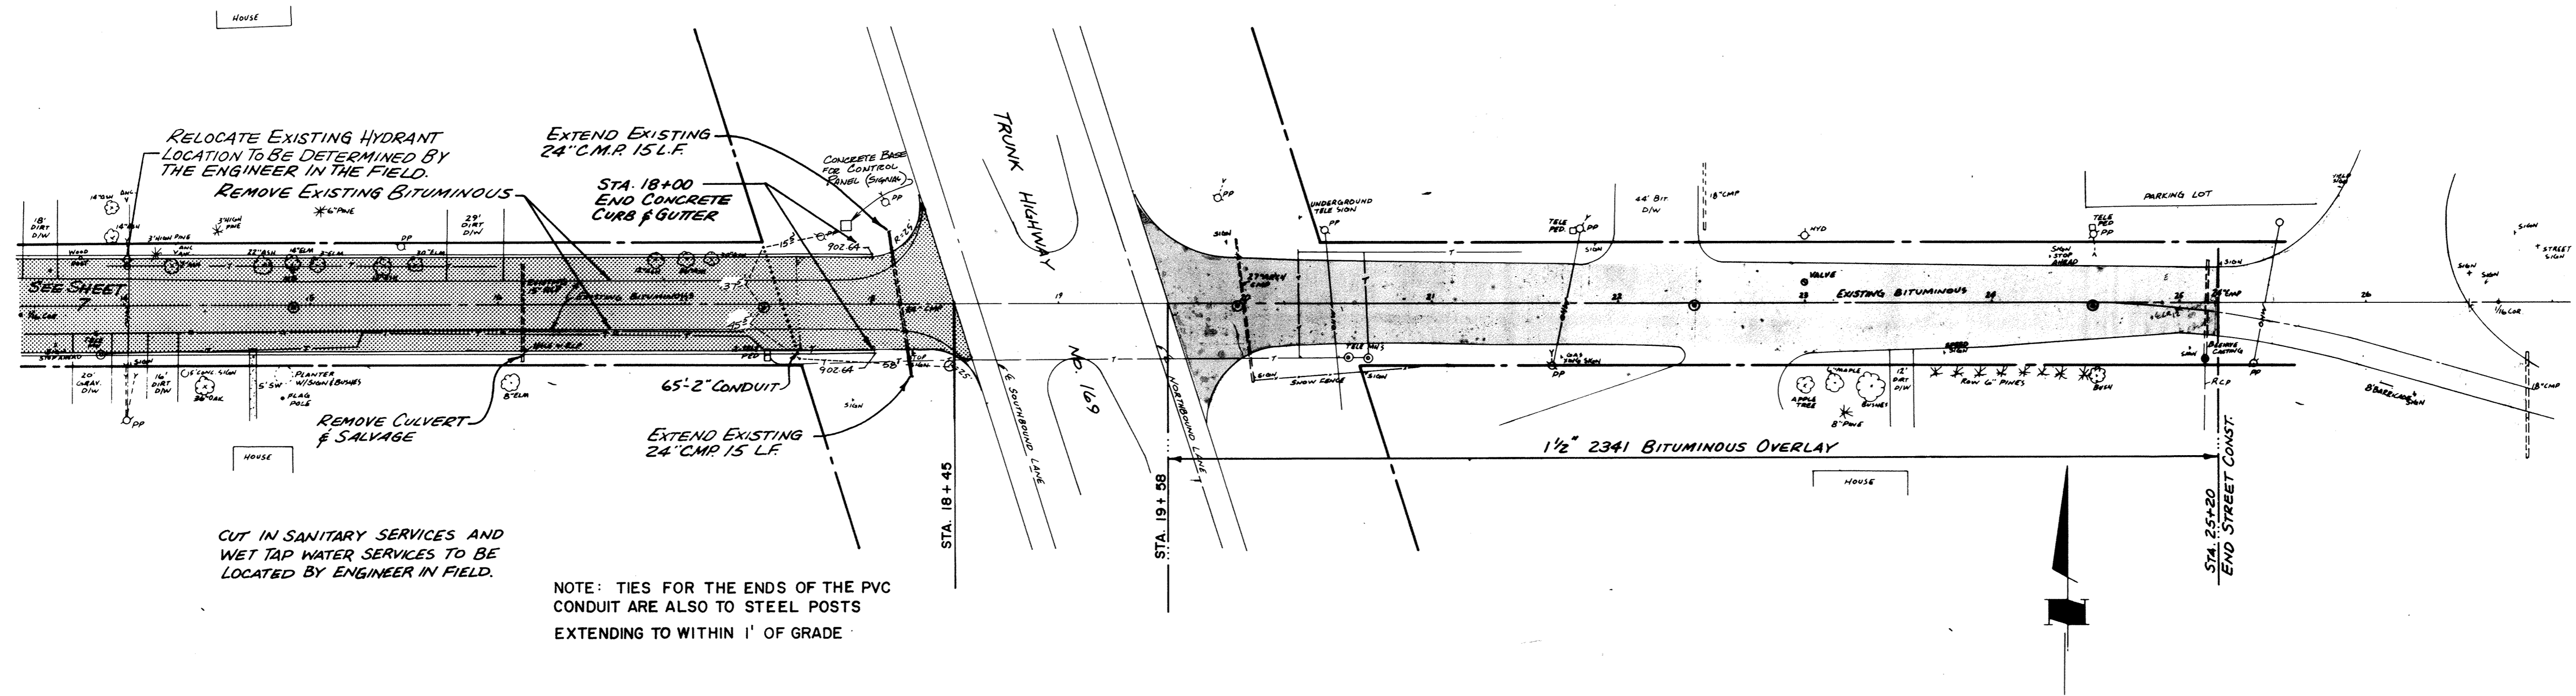

CUT IN SANITARY SERVICES AND WET TAP WATER SERVICES TO BE LOCATED BY ENGINEER IN FIELD.

NOTE: TIES FOR THE ENDS OF THE PVC CONDUIT ARE ALSO TO STEEL POSTS EXTENDING TO WITHIN 1' OF GRADE

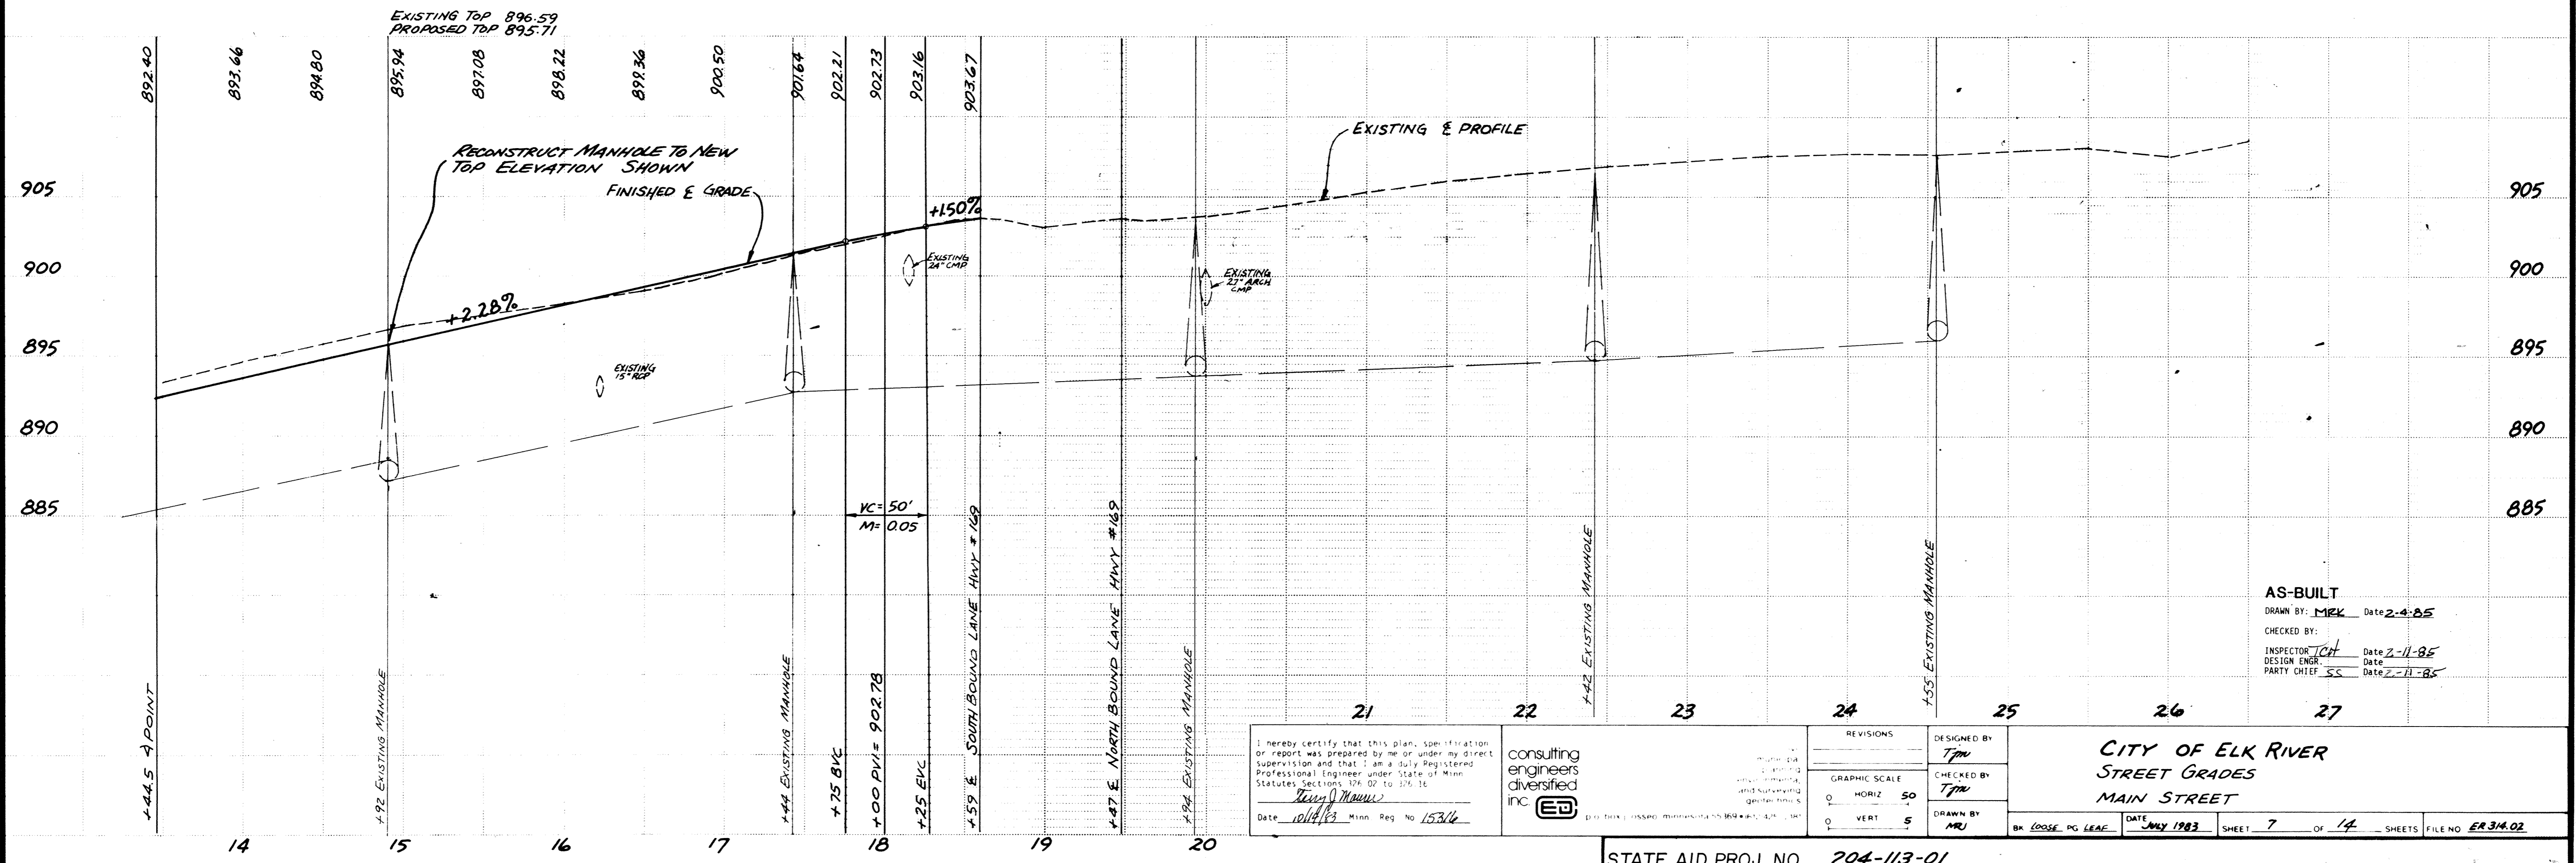

AS-BUILT  
 DRAWN BY: MEK Date 2-4-85  
 CHECKED BY:  
 INSPECTOR: JCH Date 2-11-85  
 DESIGN ENGR:  
 PARTY CHIEF: SC Date 2-11-85

I hereby certify that this plan, specification or report was prepared by me or under my direct supervision and that I am a duly Registered Professional Engineer under State of Minnesota Sections 379.02 to 379.36  
 Date 10/14/83 Minn Reg No 15316



REVISIONS		DESIGNED BY
		TJM
GRAPHIC SCALE		CHECKED BY
0	HORIZ 50	TJM
0	VERT 5	DRAWN BY
		MRJ

CITY OF ELK RIVER  
 STREET GRADES  
 MAIN STREET

DATE: JULY 1983 SHEET 7 OF 14 SHEETS FILE NO ER314.02

STATE AID PROJ. NO. 204-113-01

DRAWING NUMBER

DRAWING NUMBER

DRAWING NUMBER

DRAWING NUMBER  
7  
MANS. 83