
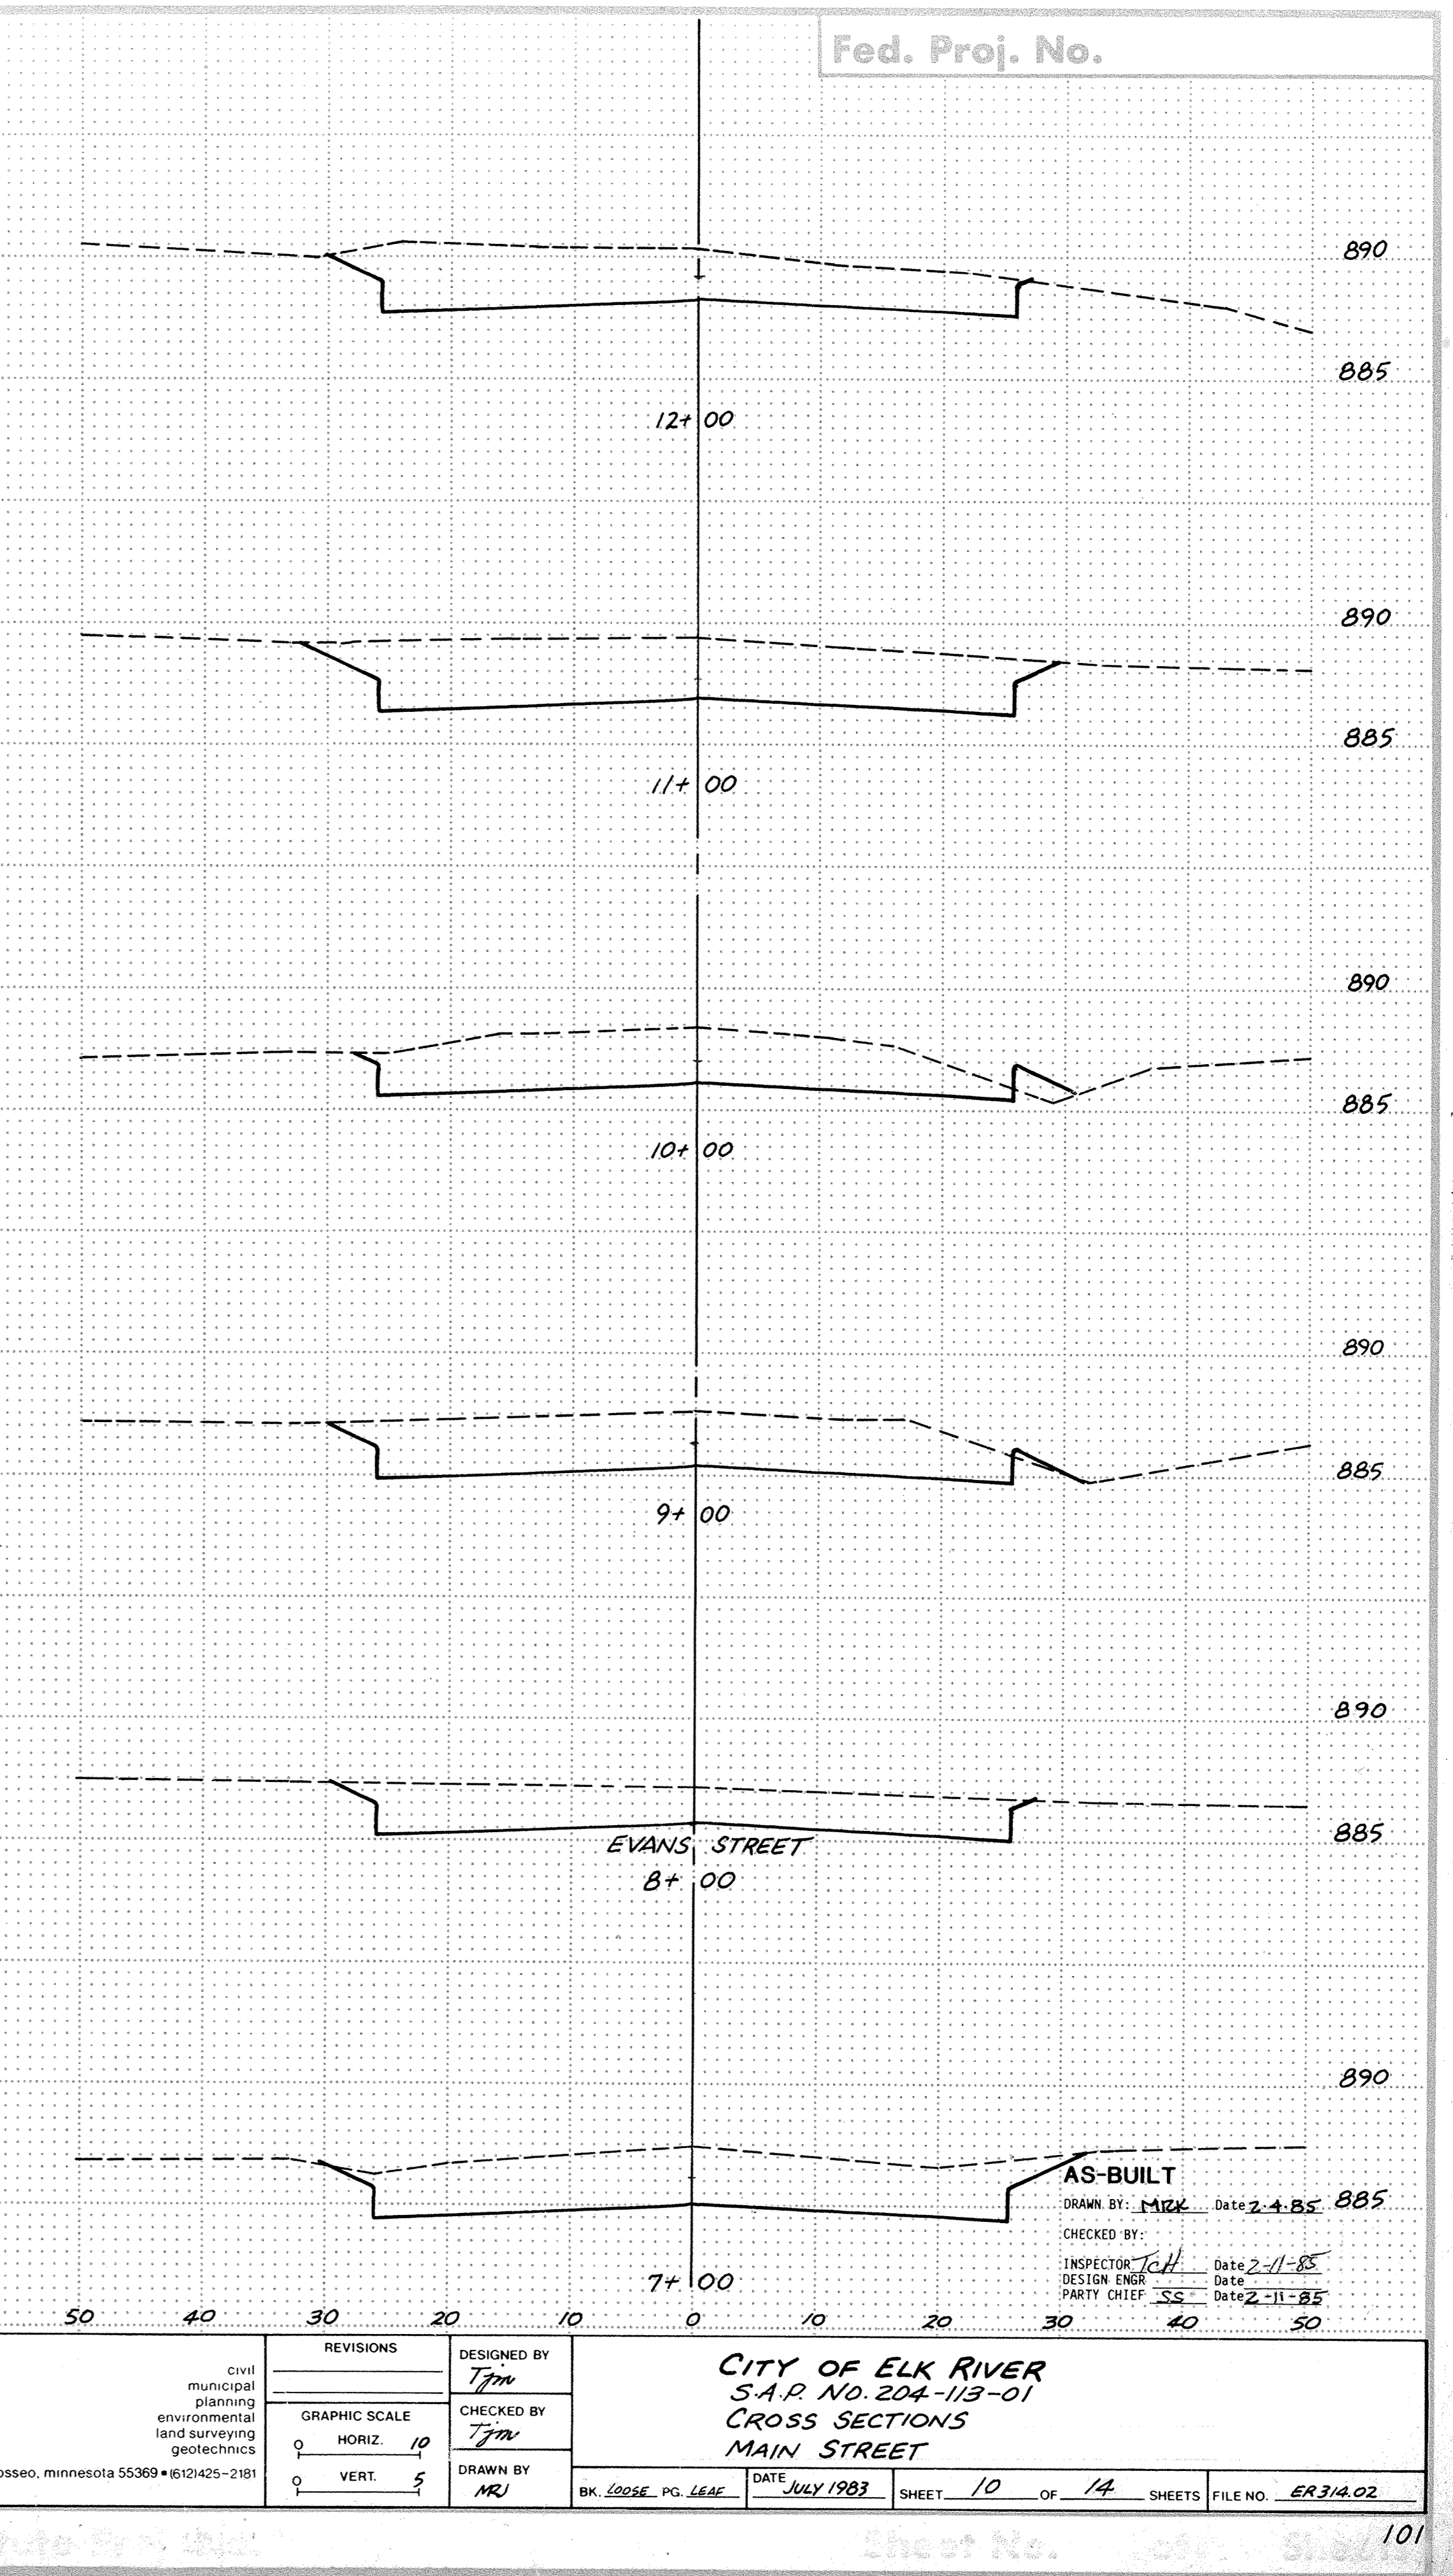



Fed. Proj. No.

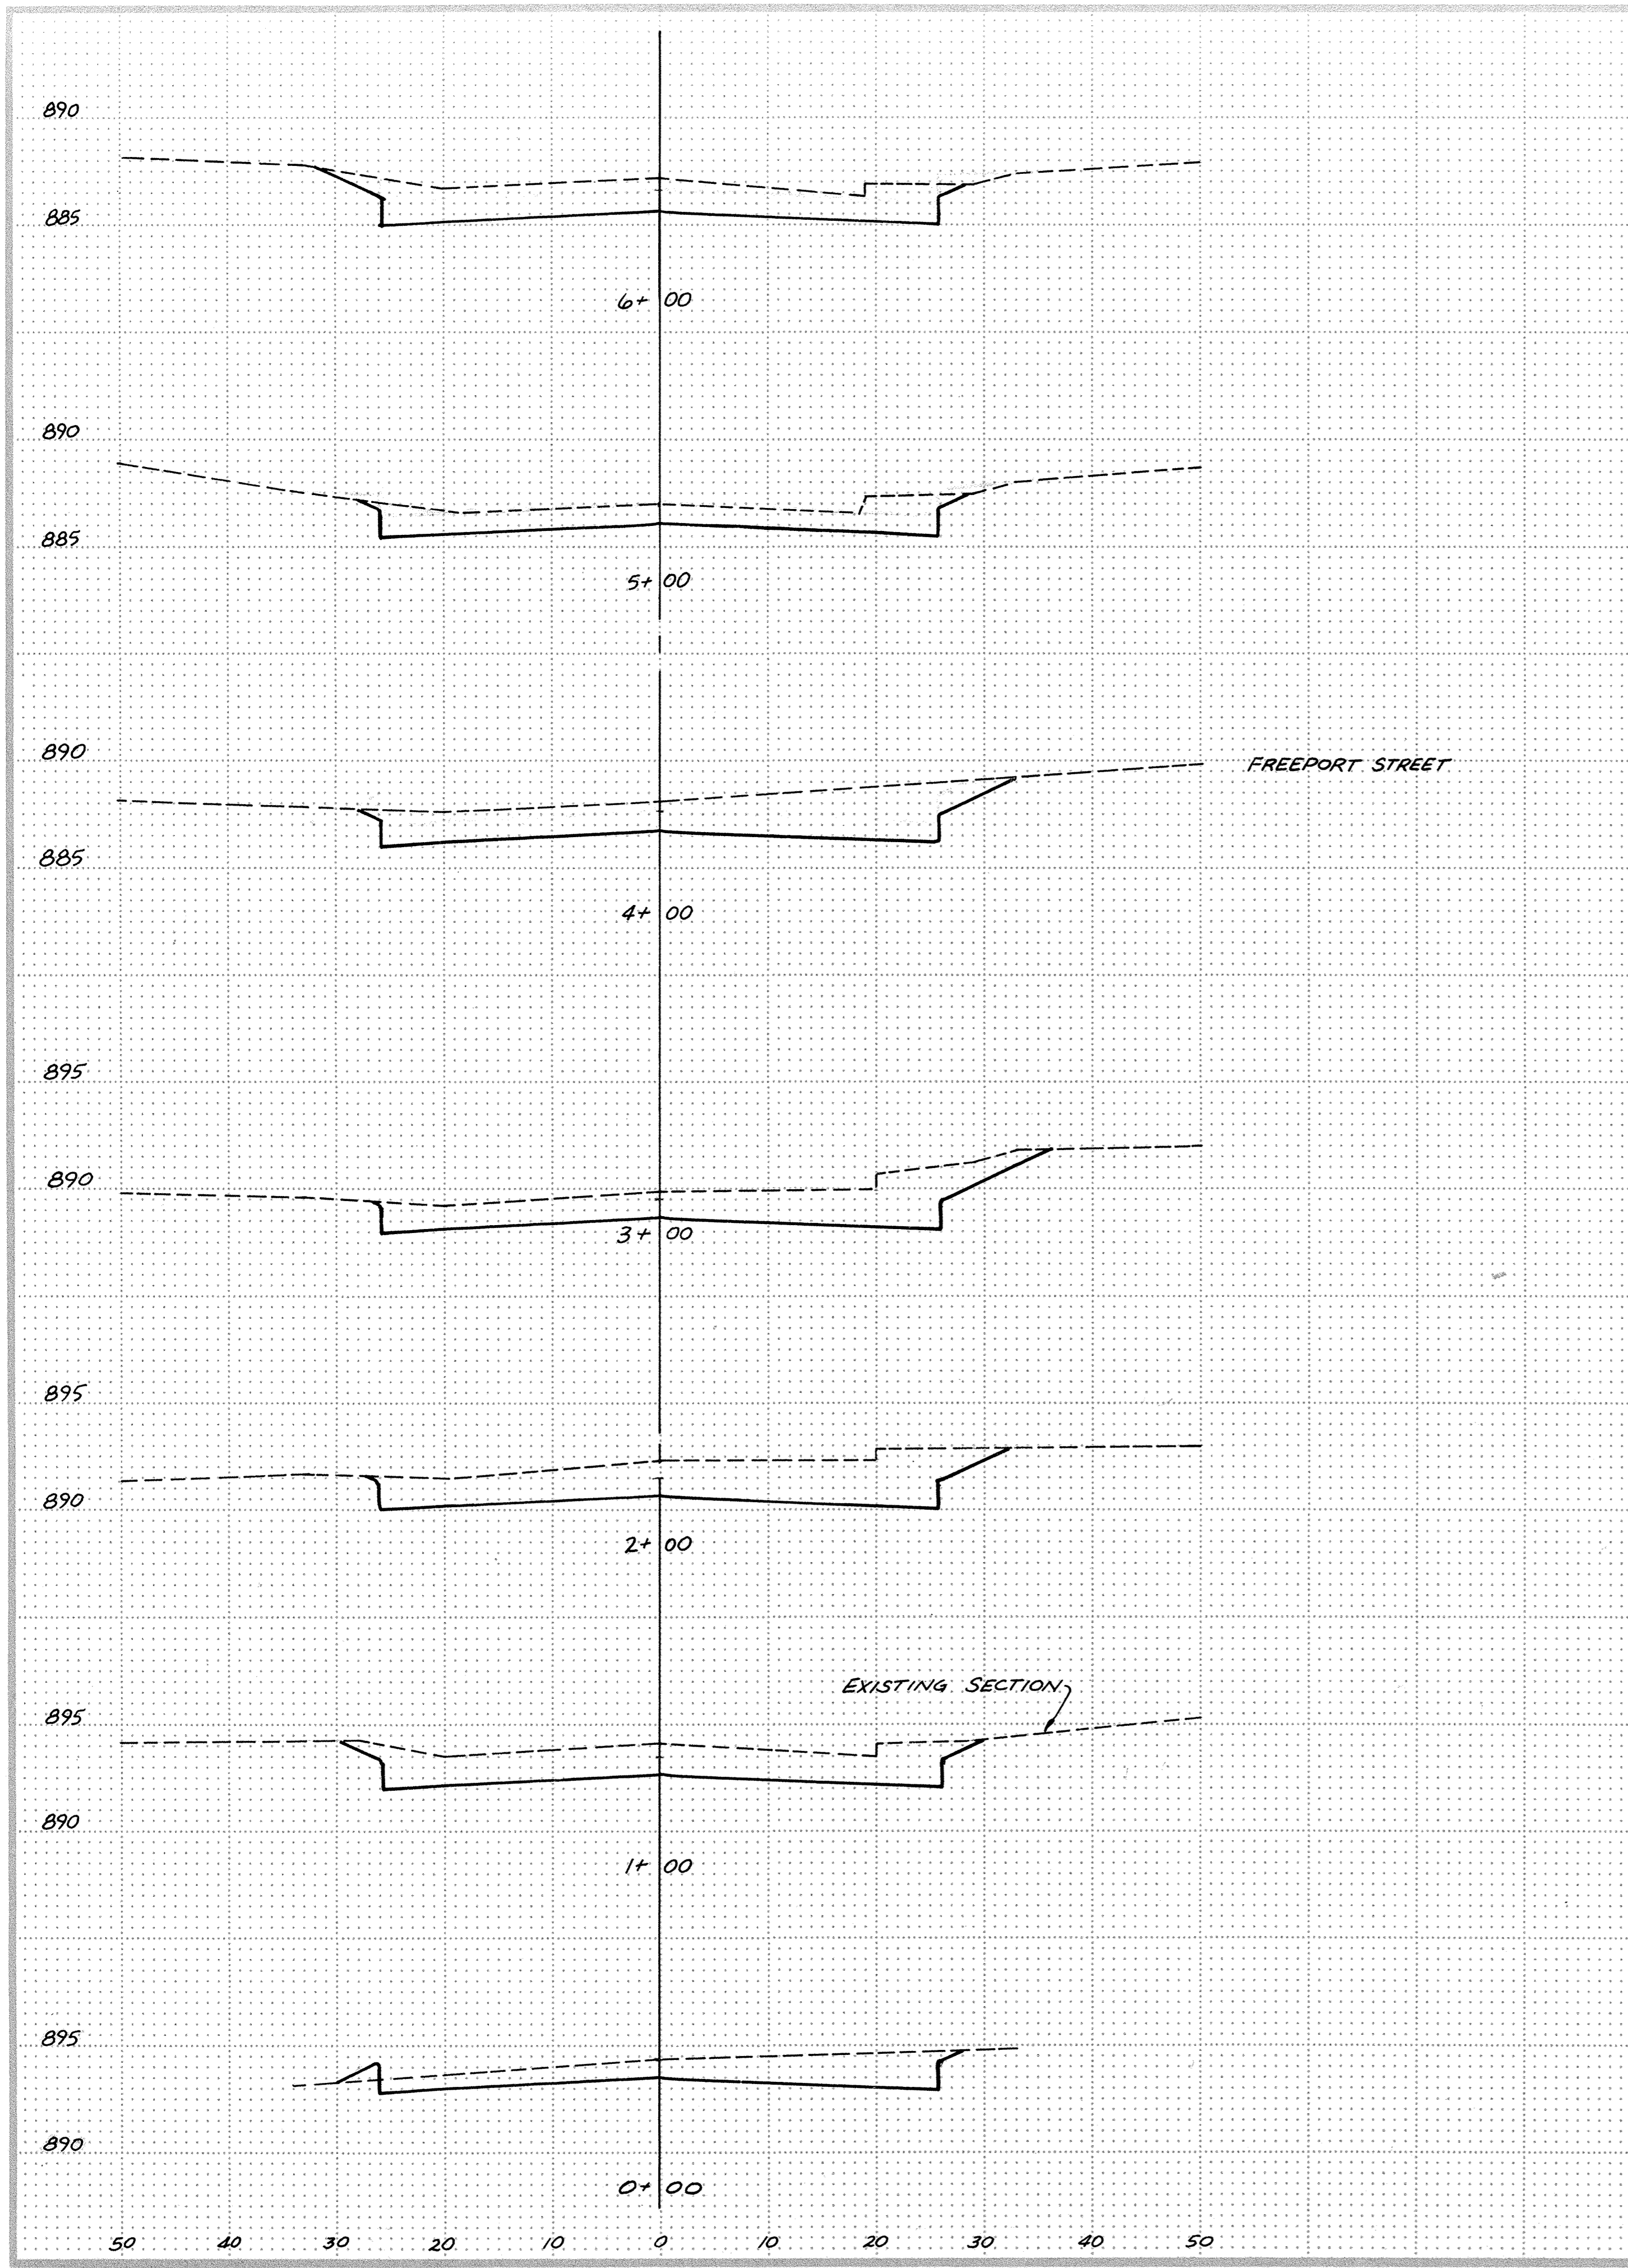

I hereby certify that this plan, specification or report was prepared by me or under my direct supervision and that I am a duly Registered Professional Engineer under State of Minn. Statutes Sections 326.02 to 326.16.

*James J. Wanner*  
Date 10/14/85 Minn. Reg. No. 15316

consulting engineers diversified inc.   
p.o. box j. osseo, minnesota 55369 • 612/425-2181

REVISIONS	
0	HORIZ. 10
0	VERT. 5

DESIGNED BY  
*Tjm*

CHECKED BY  
*Tjm*

DRAWN BY  
*MRJ*

**CITY OF ELK RIVER**  
S.A.P. NO. 204-113-01  
**CROSS SECTIONS**  
**MAIN STREET**

DATE JULY 1983 SHEET 10 OF 14 SHEETS FILE NO. ER314.02

**AS-BUILT**  
DRAWN BY: *MRJ* Date 2-4-85

CHECKED BY: *SS* Date 2-11-85

INSPECTOR: *SS* Date 2-11-85

DESIGN ENGINEER: *SS* Date 2-11-85

PARTY CHIEF: *SS* Date 2-11-85

50 40 30 20 10 0 10 20 30 40 50

50 40 30 20 10 0 10 20 30 40 50

Sheet No. 101