




MAIN STREET

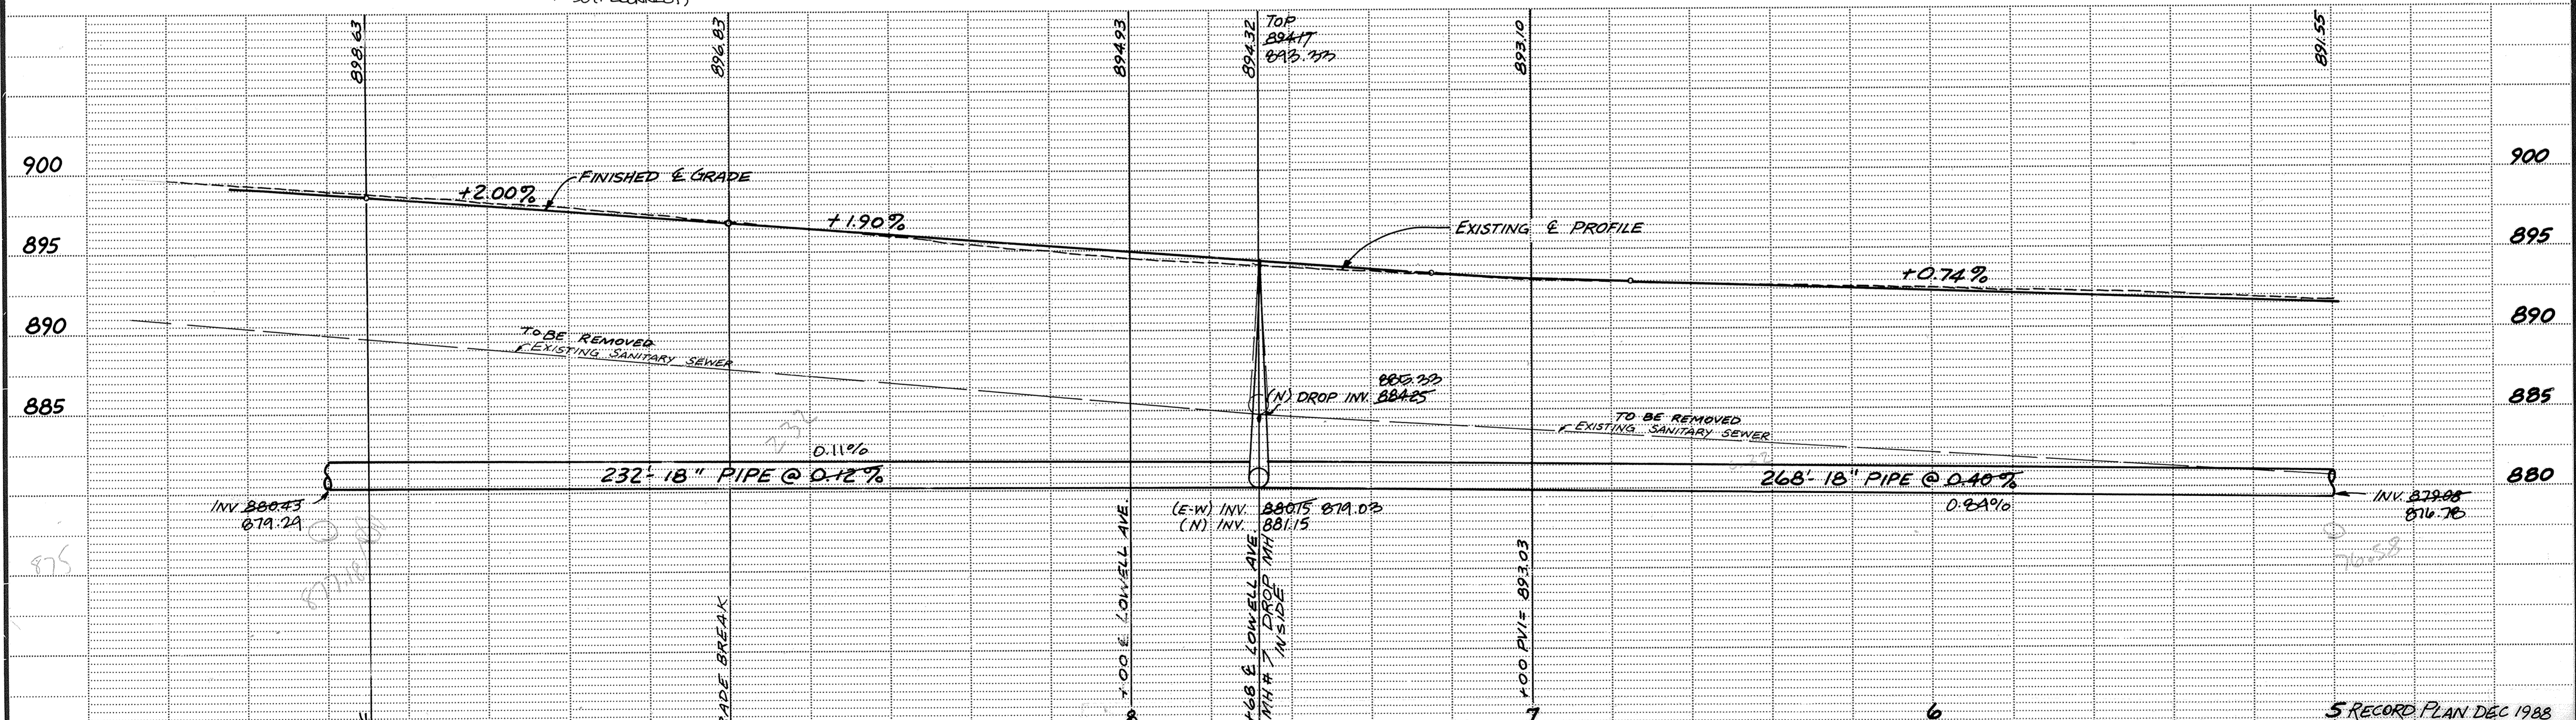

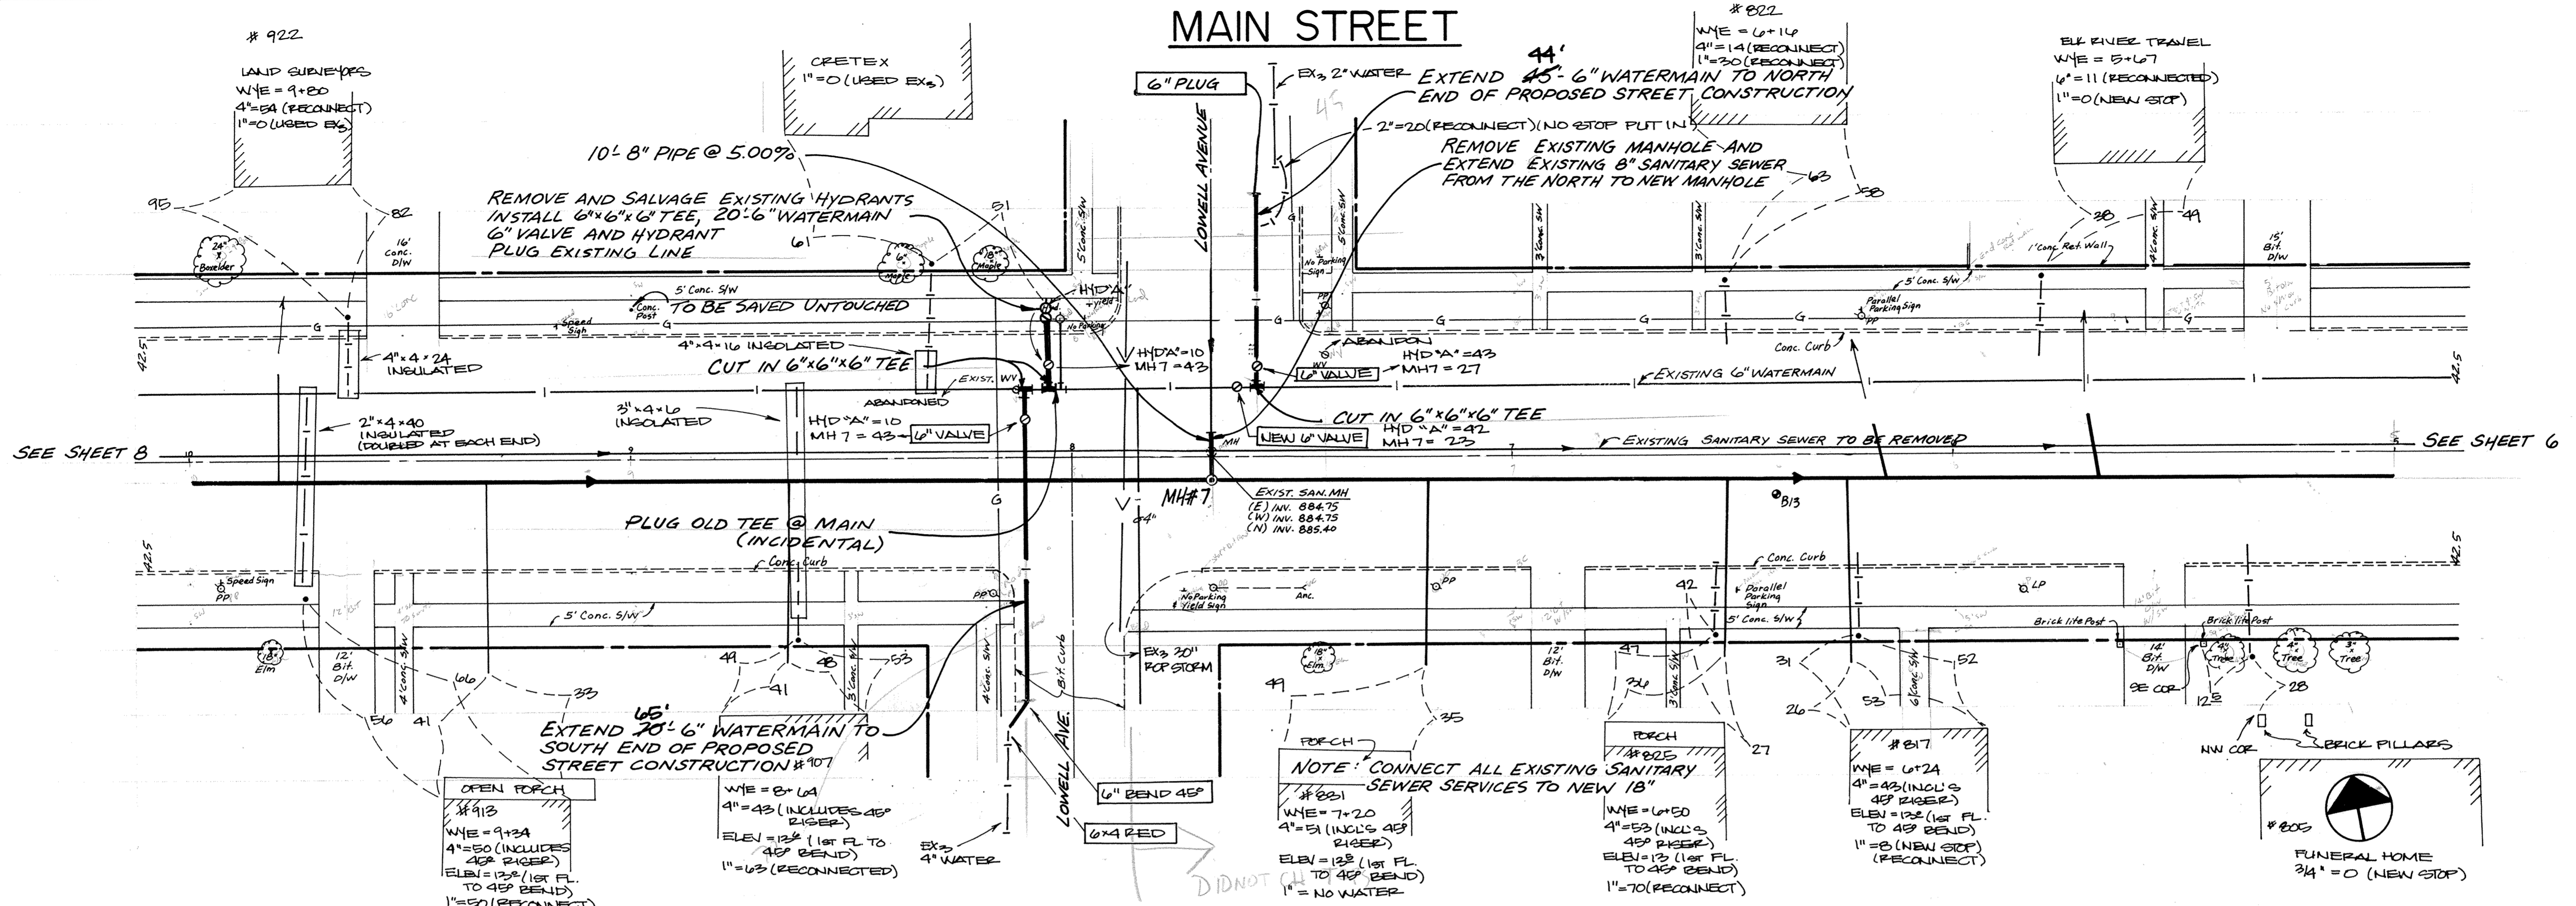

CONSULTING ENGINEERS
Maier Stewart & Associates Inc.
1959 SLOAN PLACE (612) 774-6021 ST. PAUL, MINNESOTA 55117

REVISIONS	DATE	DESCRIPTION	DESIGNED	CHECKED	DRAWN
	3/5/88	Street Grades			MRJ

CITY OF ELK RIVER
SANITARY SEWER
MAIN STREET
DATE OCT 1987 SHEET 7 OF 42 SHEETS PROJECT NO. 230-014

SAECO PRODUCTS • NEW HOPE, MINNESOTA
 PREPARED BY PART NUMBER 8032
 HORIZONTAL SCALE OF 1" = 40' (NEW STOP)
 SAECO PRODUCTS • NEW HOPE, MINNESOTA
 PREPARED BY PART NUMBER 8032
 HORIZONTAL SCALE OF 1" = 40' (NEW STOP)
 SAECO PRODUCTS • NEW HOPE, MINNESOTA
 PREPARED BY PART NUMBER 8032
 HORIZONTAL SCALE OF 1" = 40' (NEW STOP)

268