

MAIN STREET

DRAWING NUMBER

DRAWING NUMBER



DRAWING NUMBER

DRAWING NUMBER

HANKE SCHOOL

WYE = MH 13
8" PVC = 12 (RECONNECTED)

INSTALL NEW HYD+
USED OLD VALVE
REMOVE AND SALVAGE EXISTING HYDRANT
INSTALL 6"x6"x6" TEE, 8" 6" WATERMAIN
6" VALVE AND HYDRANT
1"=3 (RECONNECT)
1"=3 (RECONNECT)

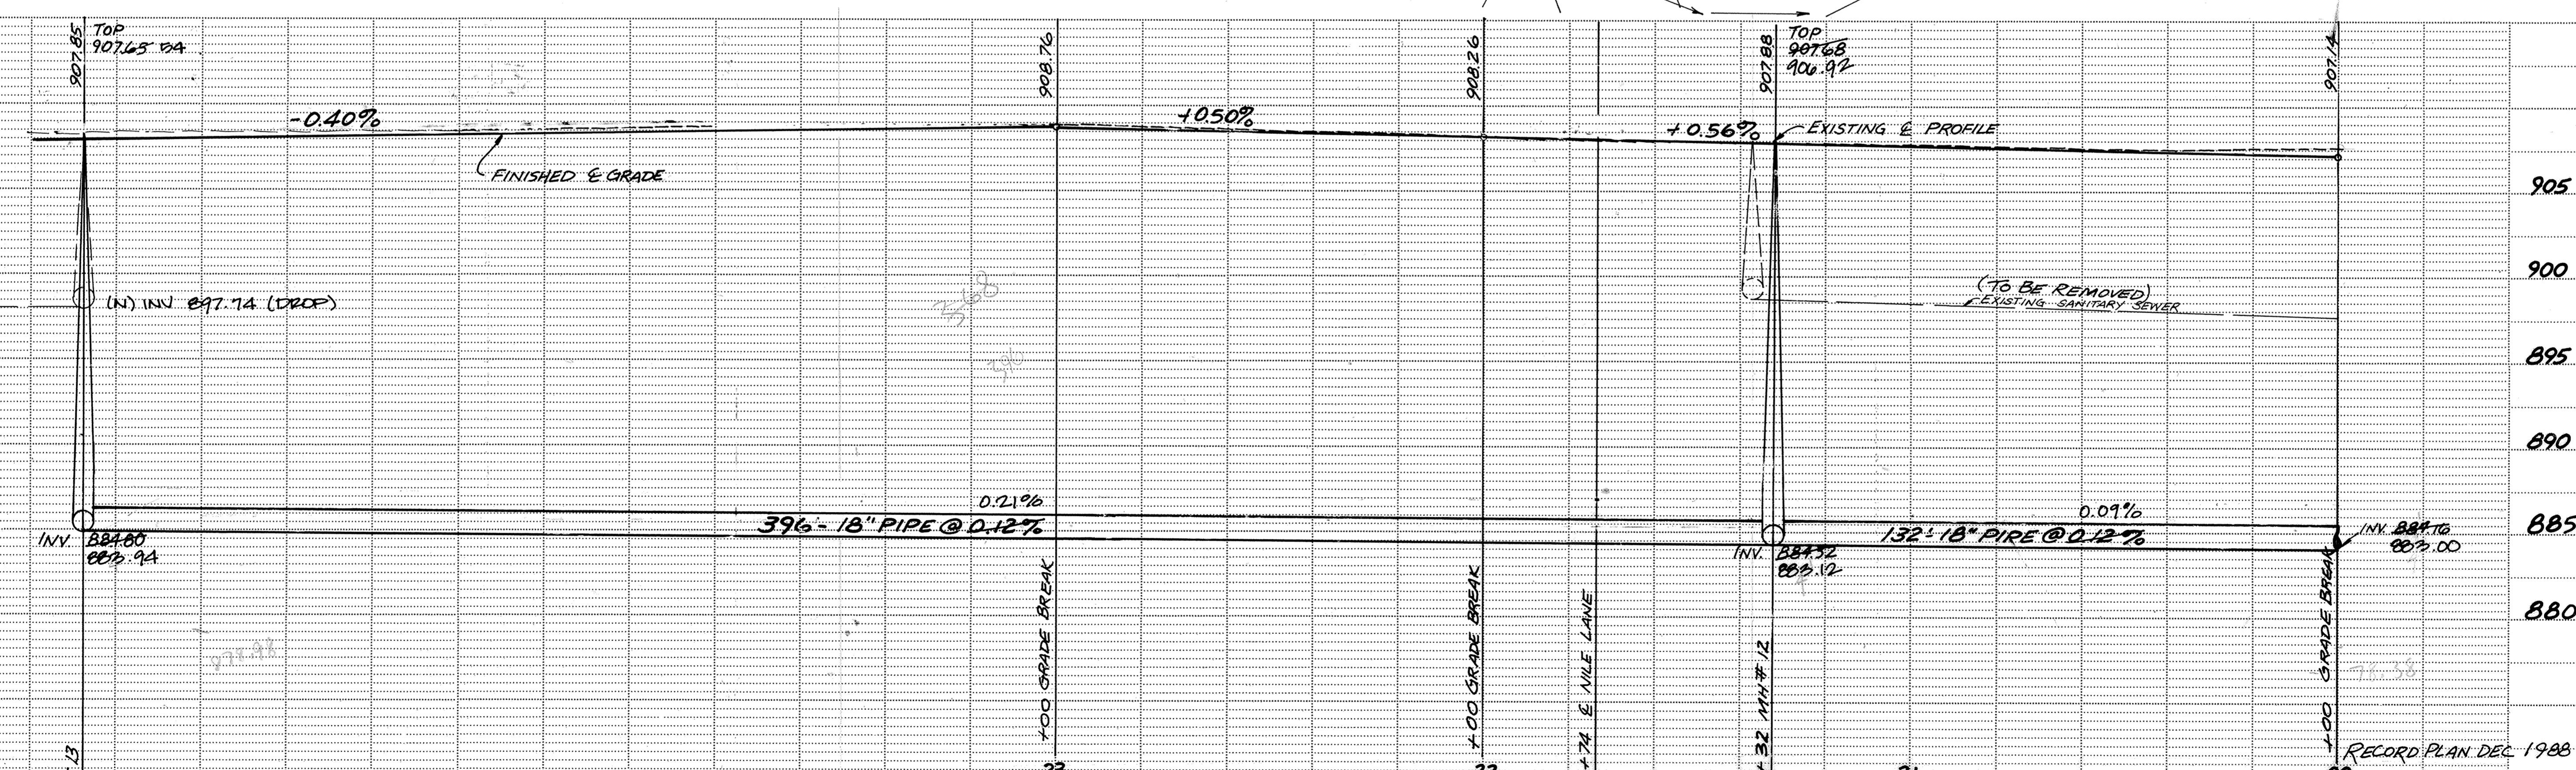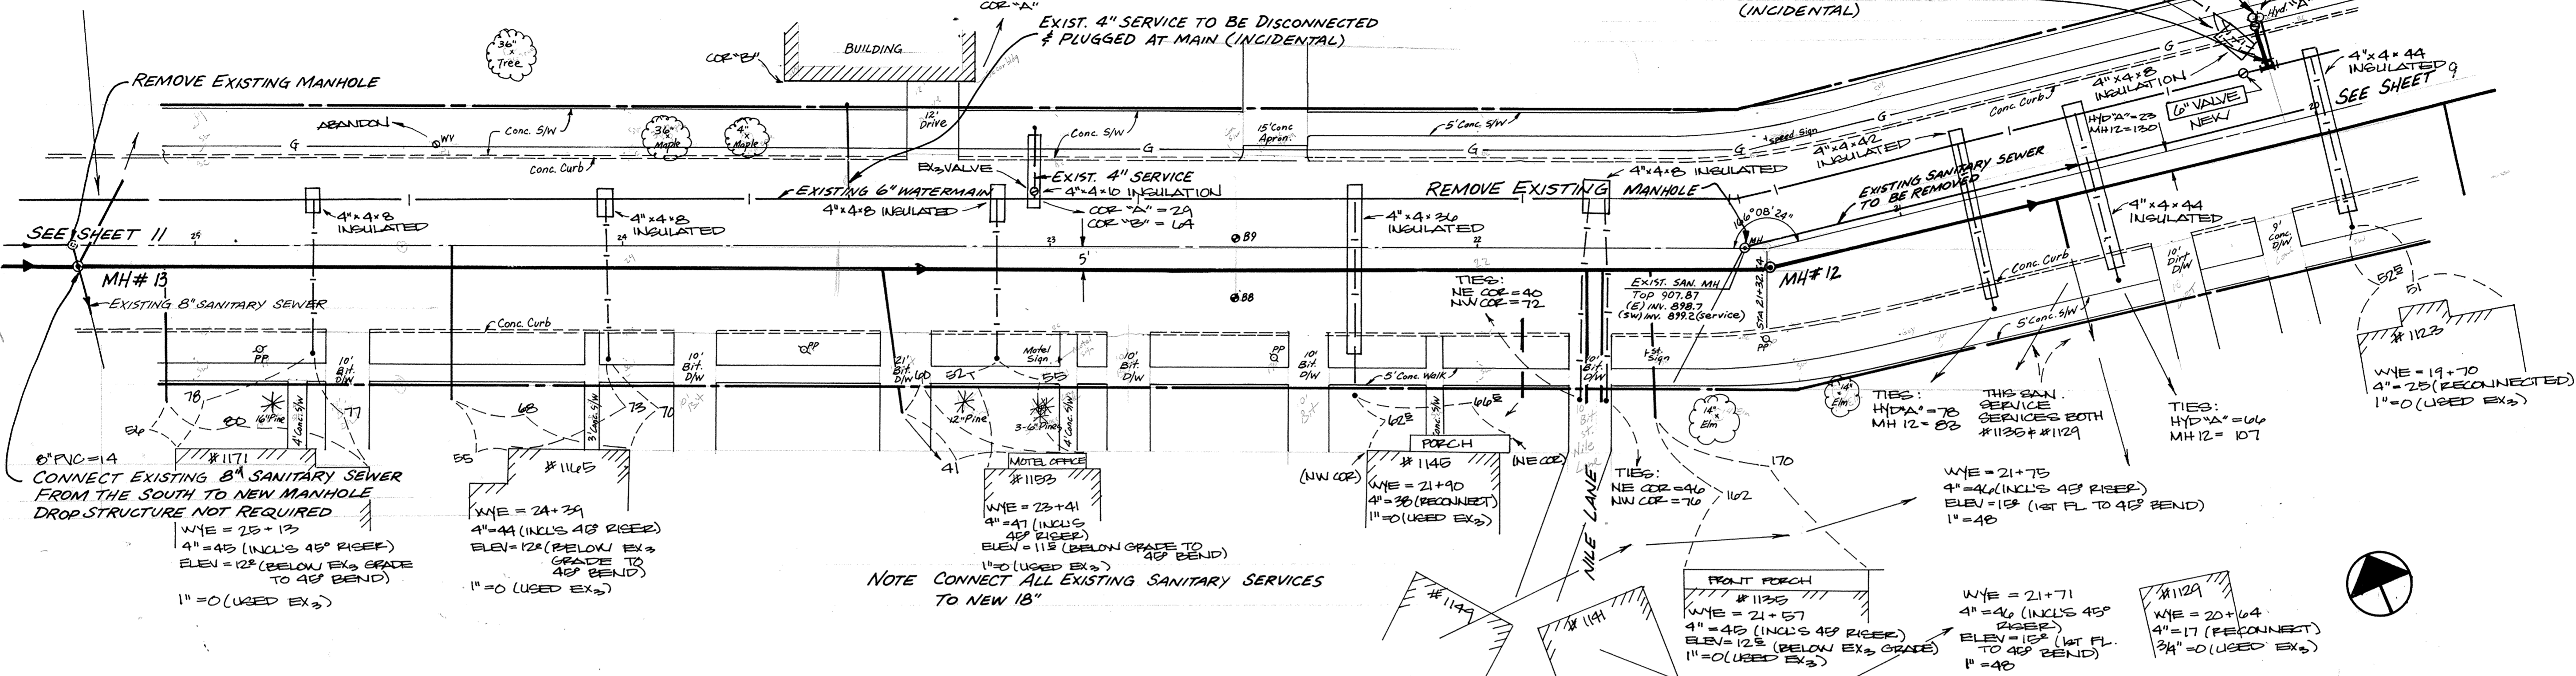

NOTE CONNECT ALL EXISTING SANITARY SERVICES TO NEW 18"

MSA CONSULTING ENGINEERS
Maier Stewart & Associates Inc.
1959 SLOAN PLACE (612) 774-6021 ST. PAUL, MINNESOTA 55117

REVISIONS DATE 3/5/88 DESCRIPTION Street Grades	DESIGNED	CITY OF ELK RIVER	
	CHECKED	SANITARY SEWER MAIN STREET	
DRAWN MRJ	DATE OCT 1987 SHEET 10 OF 42 SHEETS PROJECT NO. 230-014		
GRAPHIC SCALE 0 HORIZ. 20 0 VERT. 5			