
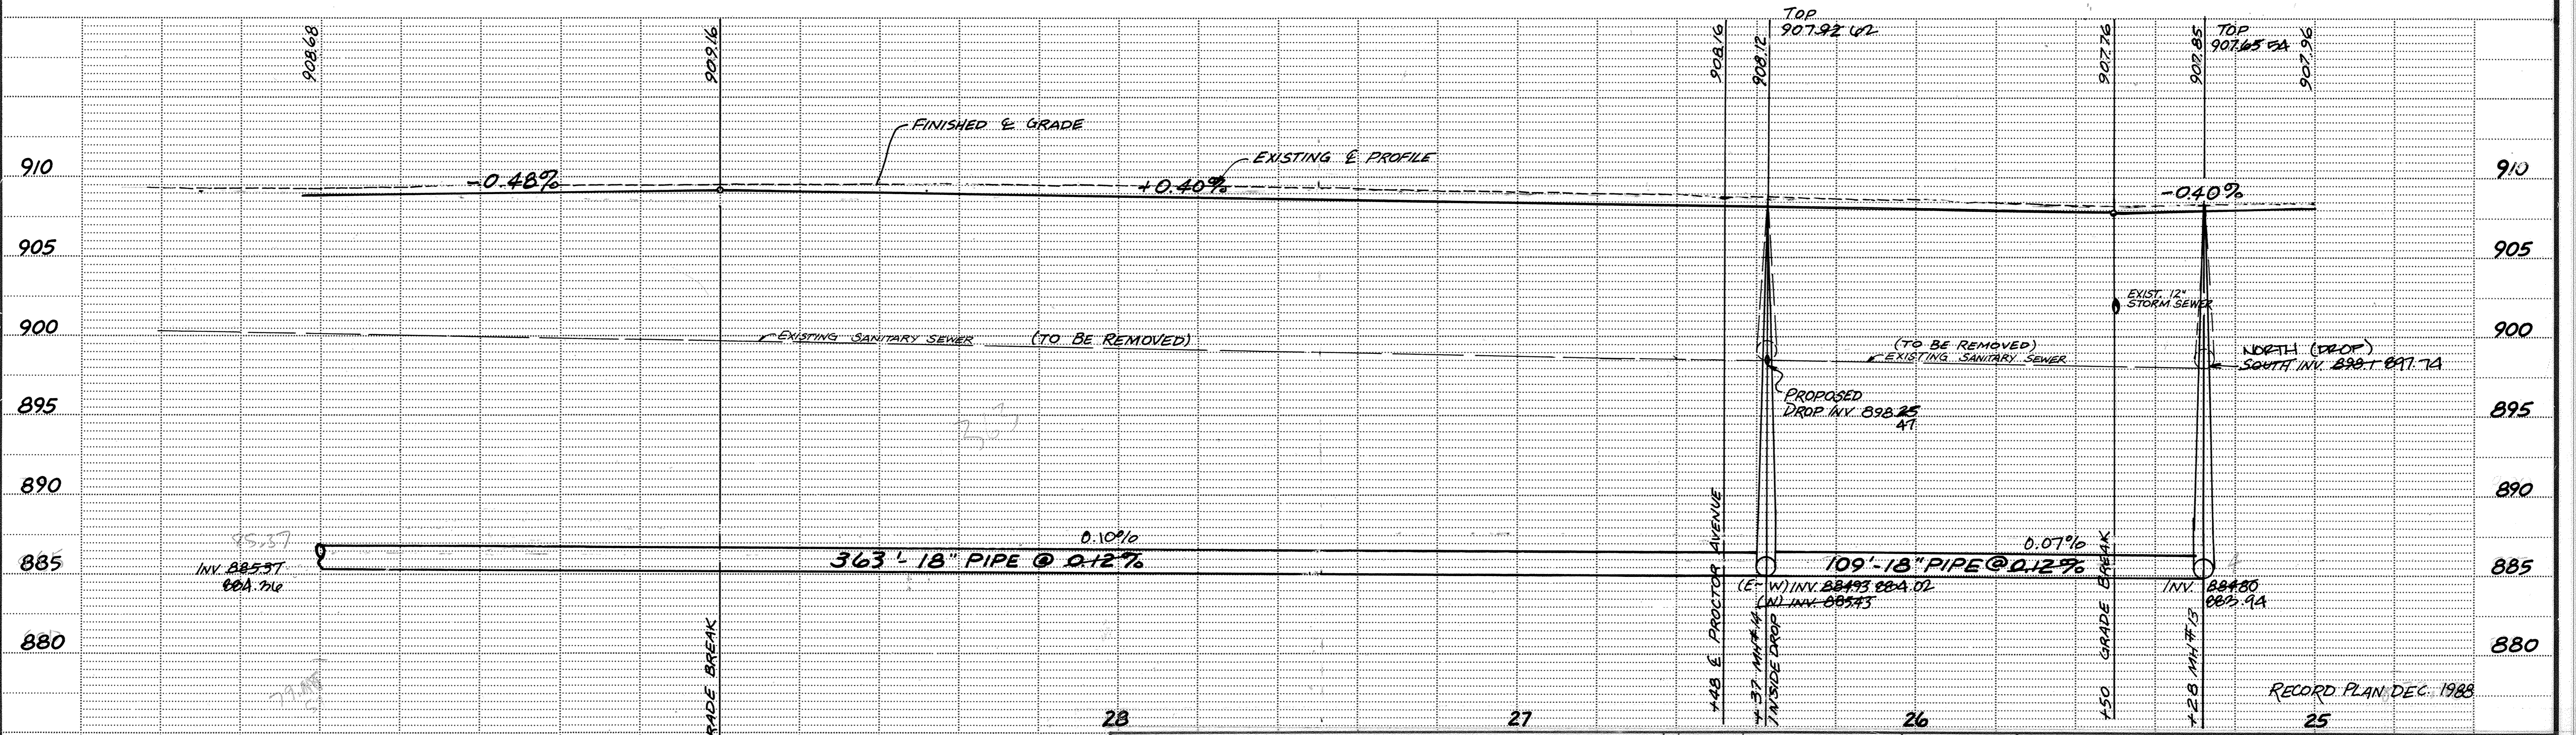


# MAIN STREET

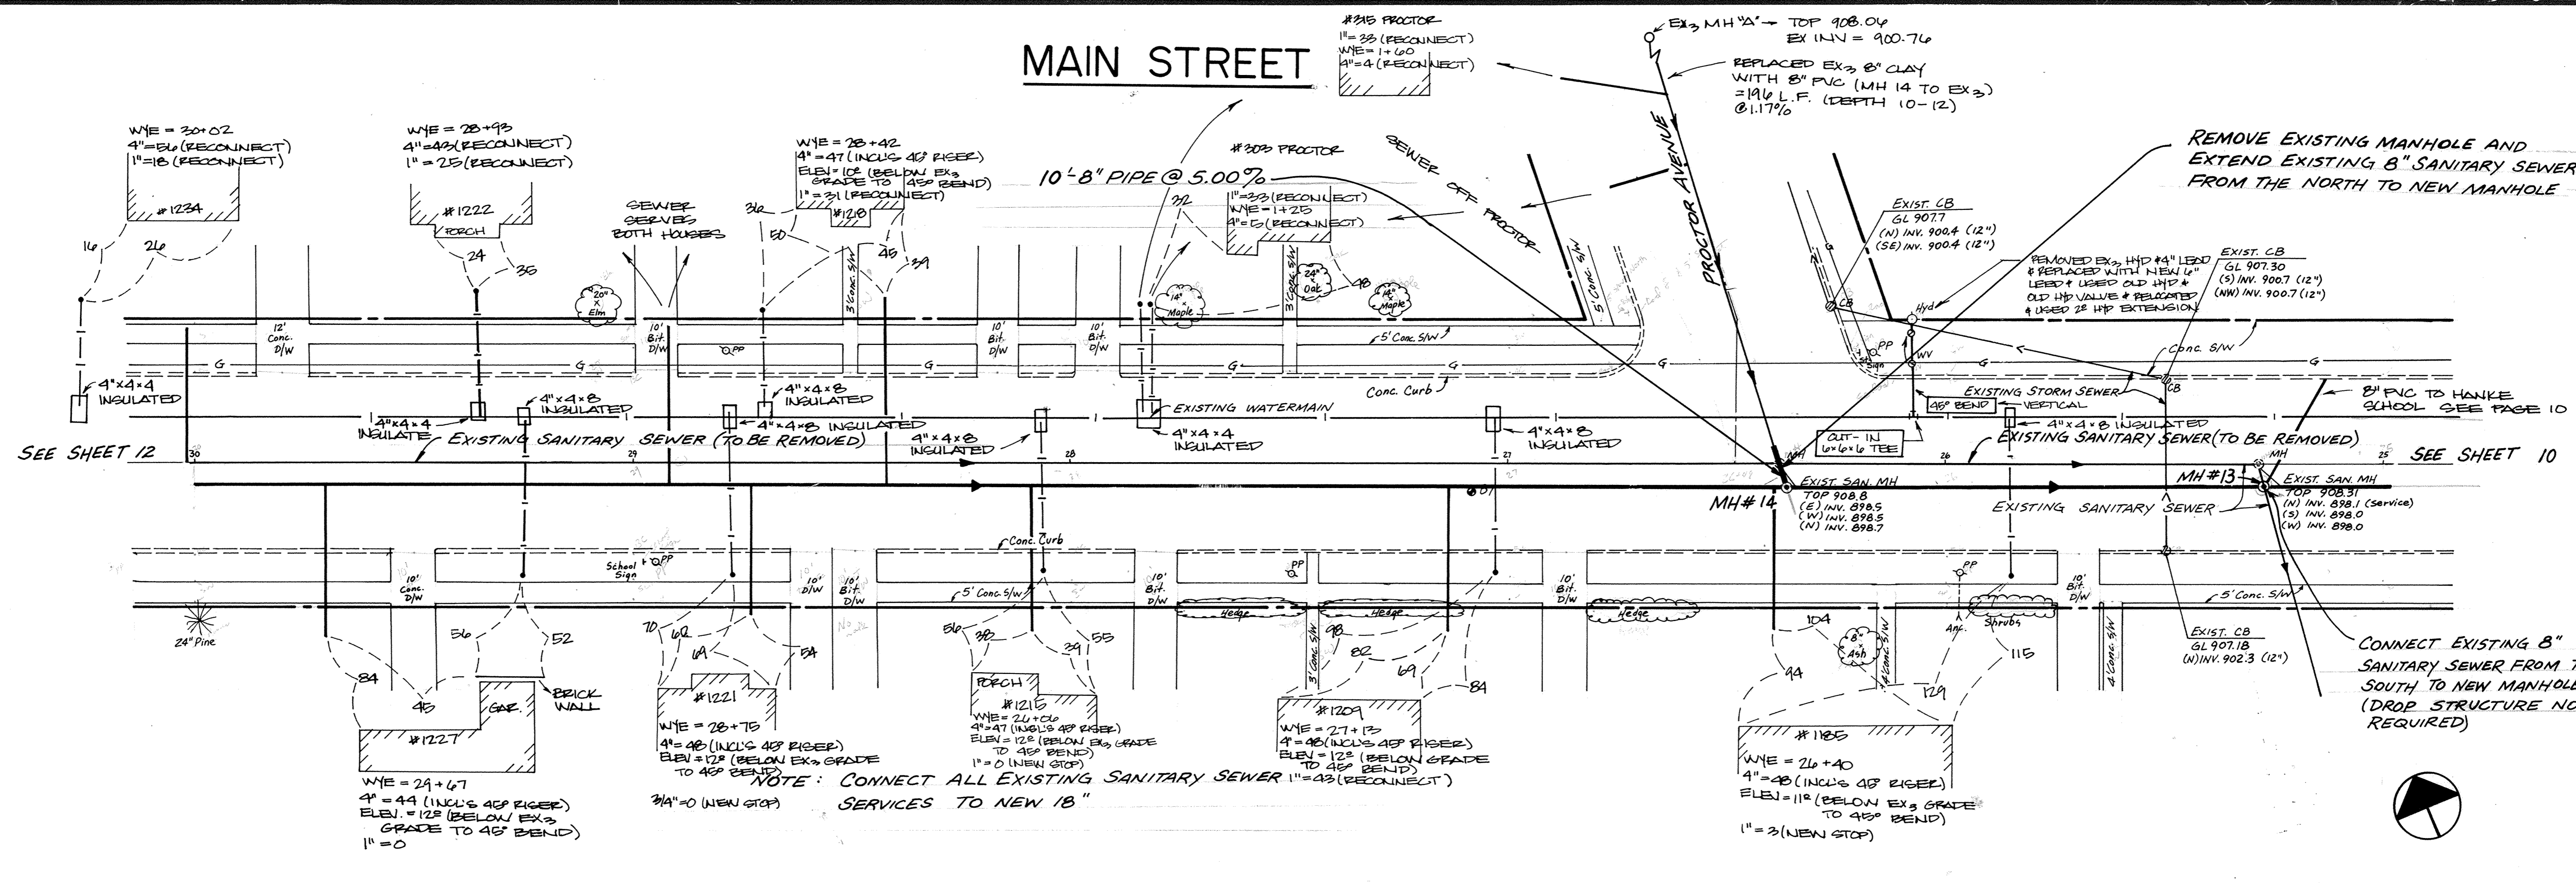

<p>CONSULTING ENGINEERS Maier Stewart &amp; Associates Inc. 1959 SLOAN PLACE (612)774-6021 ST. PAUL, MINNESOTA 55117</p>		<p>DATE 3/5/08 DESCRIPTION Street Grades</p>	<p>DESIGNED CHECKED DRAWN MRJ GRAPHIC SCALE 9 HORIZ. 29 9 VERT. 5</p>	<p>CITY OF ELK RIVER SANITARY SEWER MAIN STREET DATE OCT 1987 SHEET 11 OF 42 SHEETS PROJECT NO. 230-014</p>
----------------------------------------------------------------------------------------------------------------------------------	--	--------------------------------------------------	-------------------------------------------------------------------------------------------	-------------------------------------------------------------------------------------------------------------------------

SAFCO PRODUCTS • NEW HOPK, MINNESOTA  
 PROJECT BY PART NUMBER 8532  
 SAFCO PRODUCTS • NEW HOPK, MINNESOTA  
 PROJECT BY PART NUMBER 8532  
 SAFCO PRODUCTS • NEW HOPK, MINNESOTA  
 PROJECT BY PART NUMBER 8532  
 SAFCO PRODUCTS • NEW HOPK, MINNESOTA  
 PROJECT BY PART NUMBER 8532