
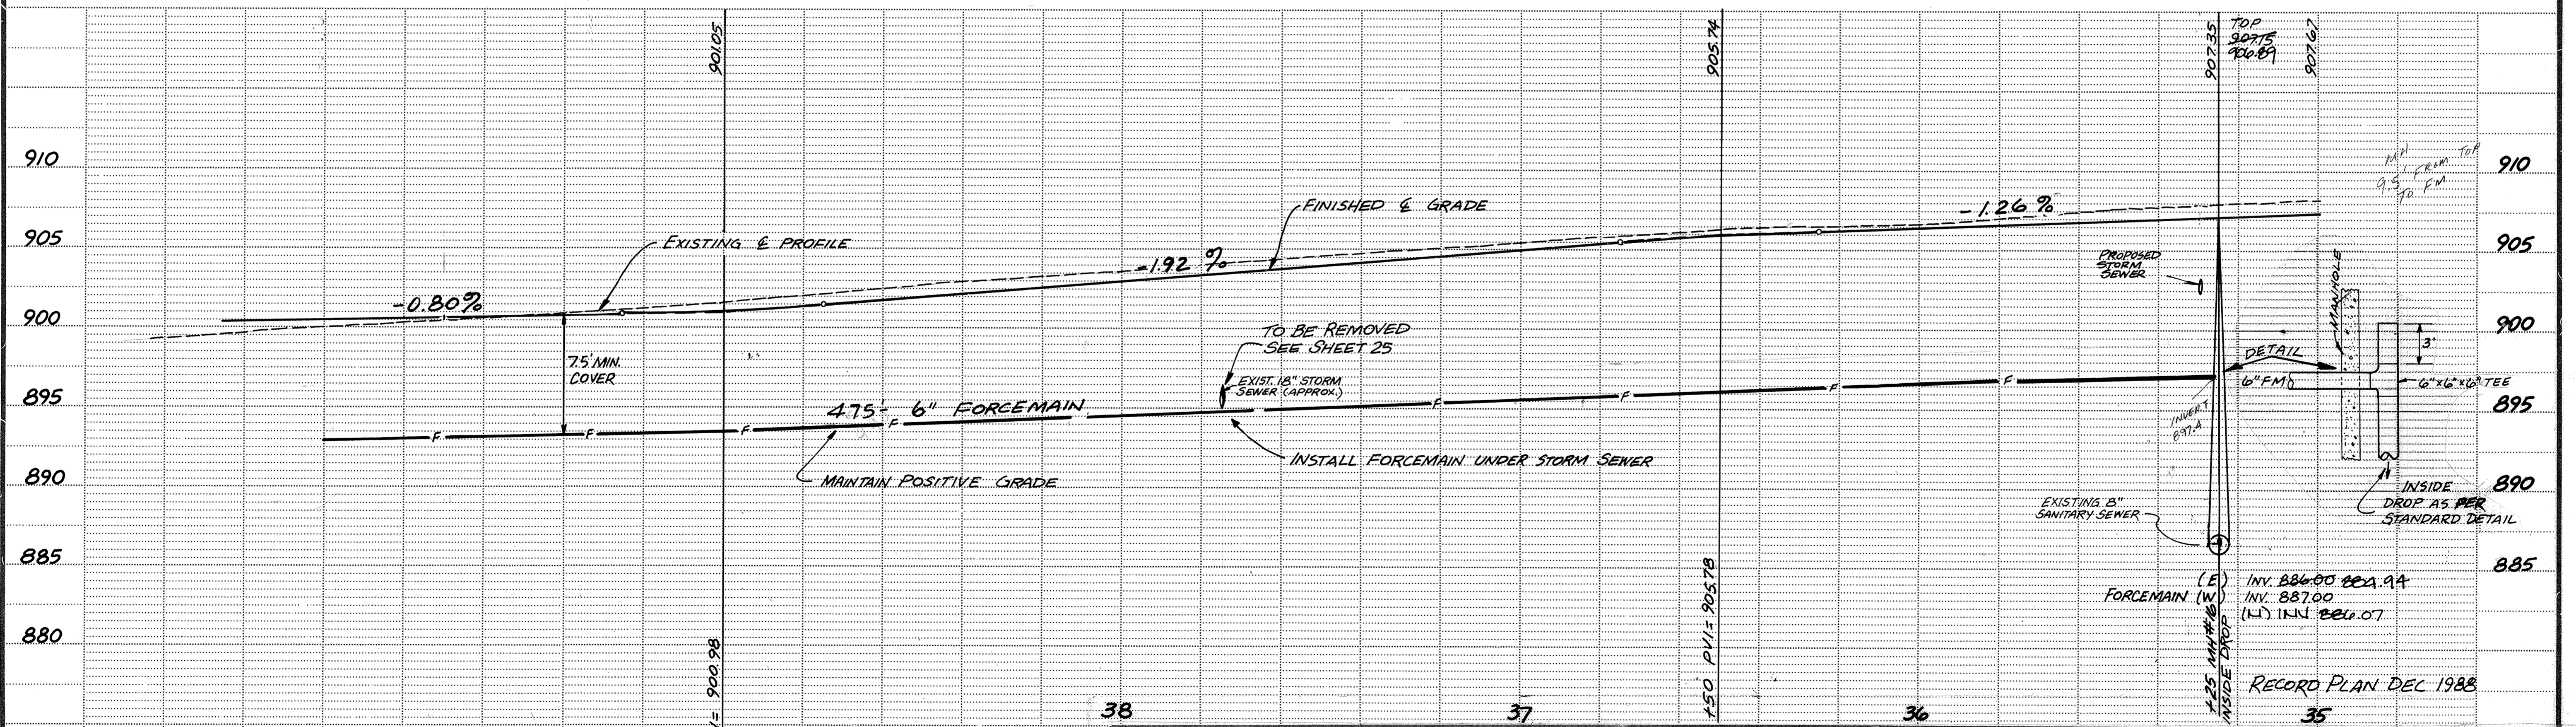


MAIN STREET

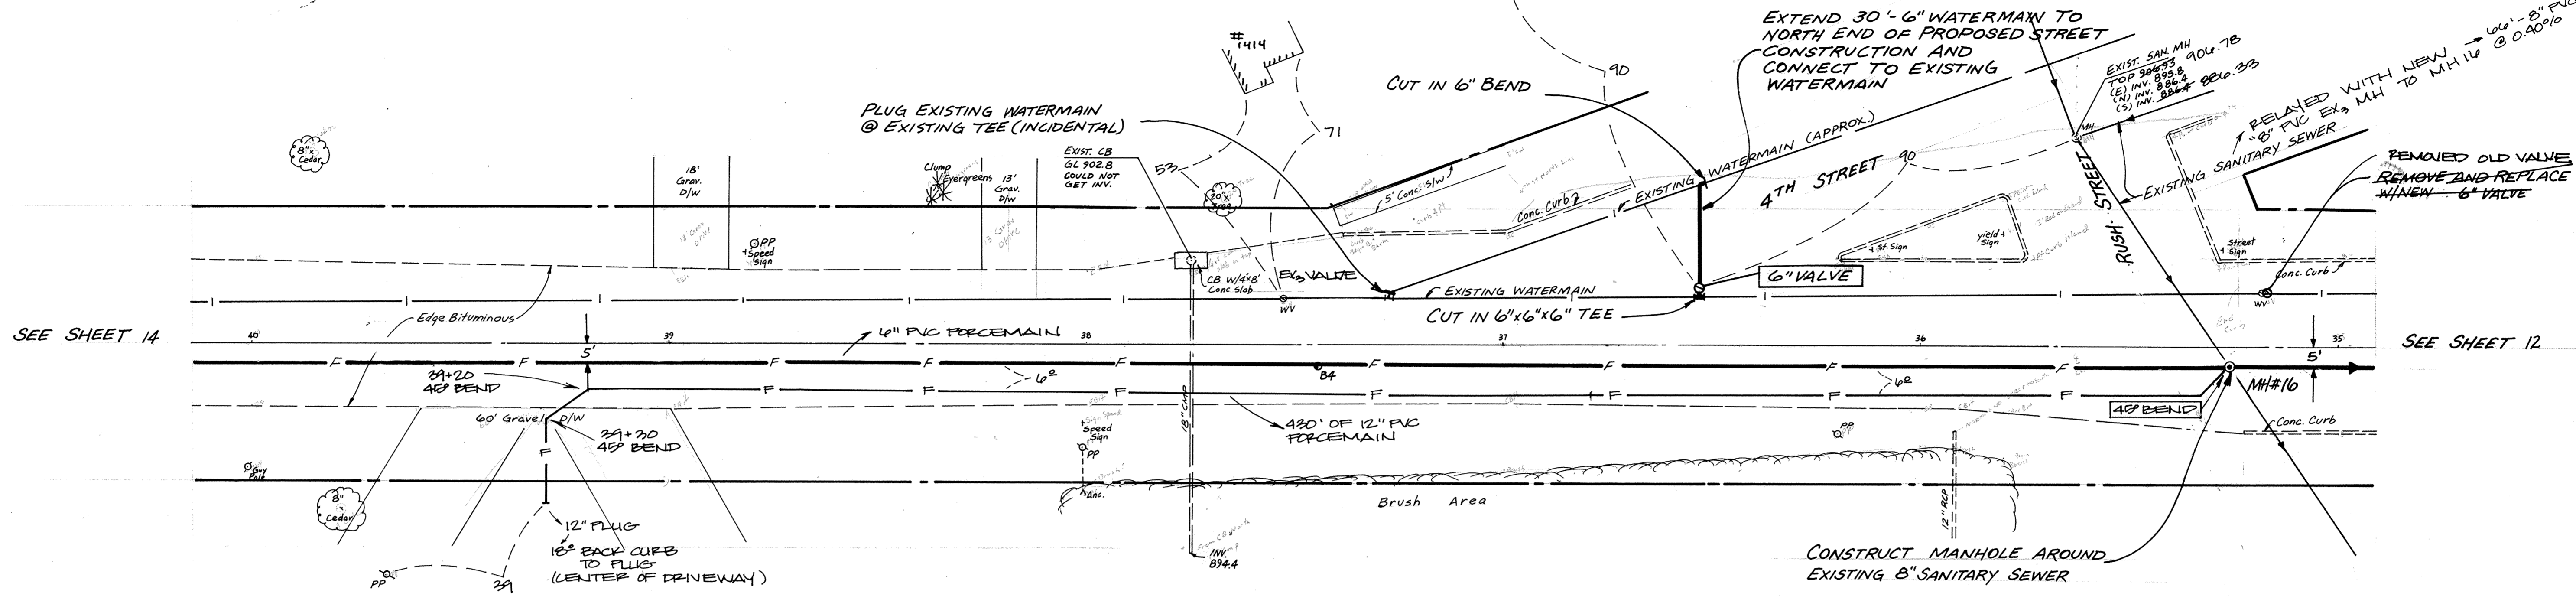

	CONSULTING ENGINEERS Maier Stewart & Associates Inc.	DATE 3/5/88	DESCRIPTION Street Grades	DESIGNED CHECKED DRAWN <i>MRJ</i>	CITY OF ELK RIVER SANITARY SEWER MAIN STREET
	1959 SLOAN PLACE (612) 774-6021 ST. PAUL, MINNESOTA 55117	GRAPHIC SCALE 0 HORIZ. 20 0 VERT. 5	DATE OCT 1987	SHEET 13 OF 42 SHEETS	

DRAWING NUMBER
 MAINS 87
 13
 262