
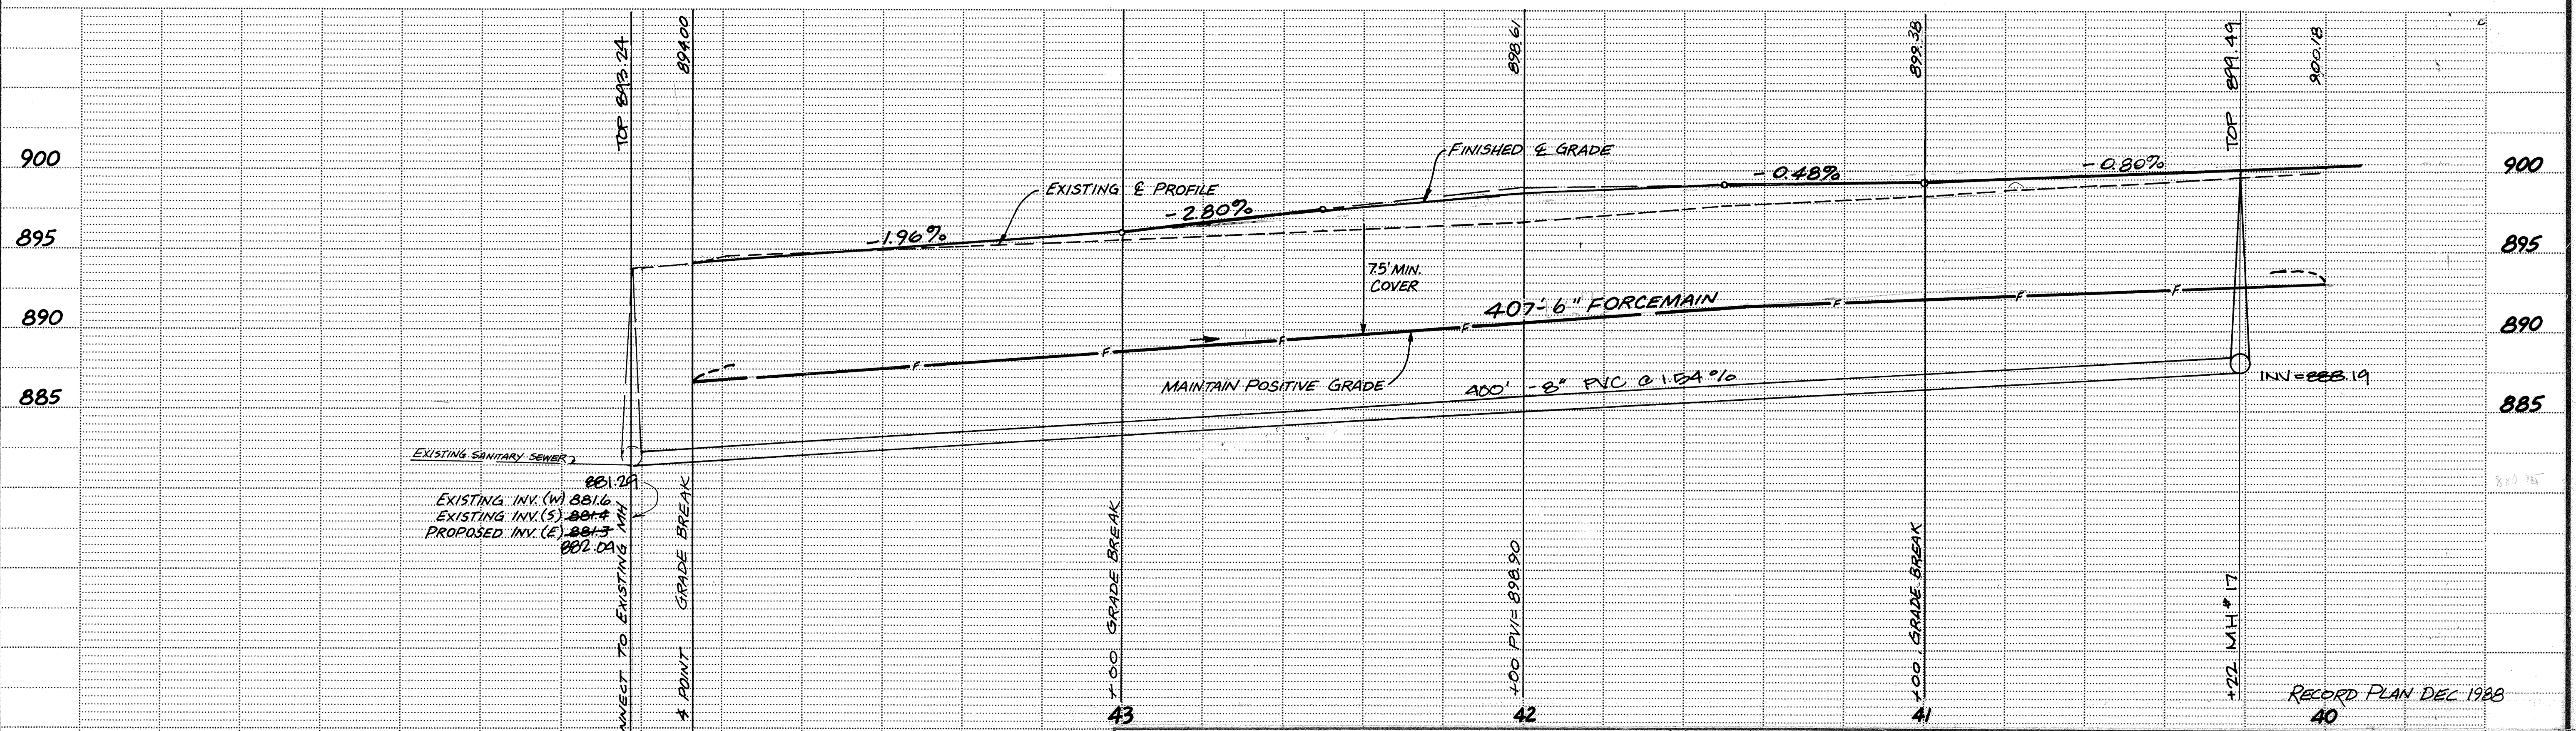


MAIN STREET

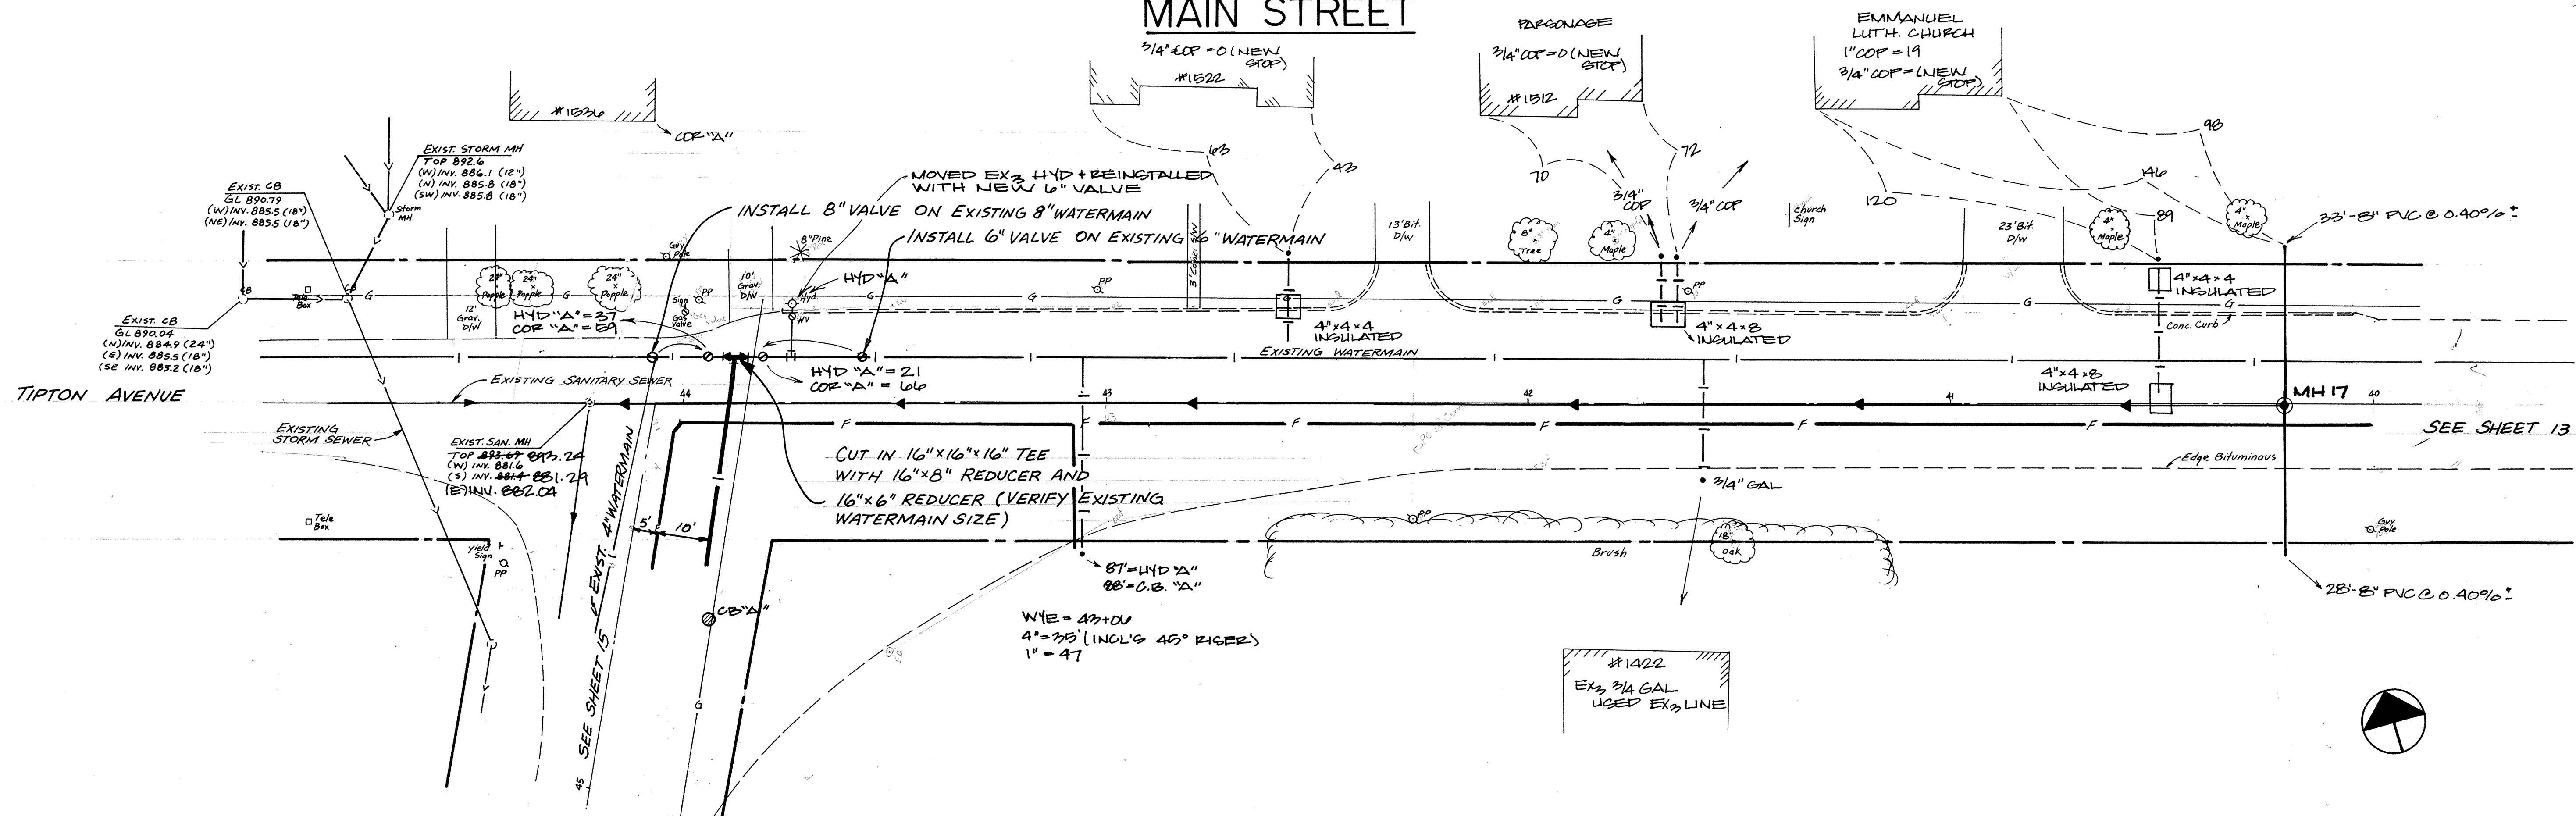

MS&A CONSULTING ENGINEERS
Maier Stewart & Associates Inc.
1959 SLOAN PLACE (612) 774-6021 ST. PAUL, MINNESOTA 55117

DATE	DESCRIPTION	DESIGNED
3/5/88	Street Grades	CHECKED
		DRAWN MRJ
		GRAPHIC SCALE
		0 HORIZ. 20
		0 VERT. 5

CITY OF ELK RIVER
SANITARY SEWER
MAIN STREET
DATE OCT 1987 SHEET 14 OF 42 SHEETS PROJECT NO. 230-014

SD&C PRODUCTS • NEW YORK, MINNESOTA
 SD&C PRODUCTS • NEW YORK, MINNESOTA
 SD&C PRODUCTS • NEW YORK, MINNESOTA
 SD&C PRODUCTS • NEW YORK, MINNESOTA