
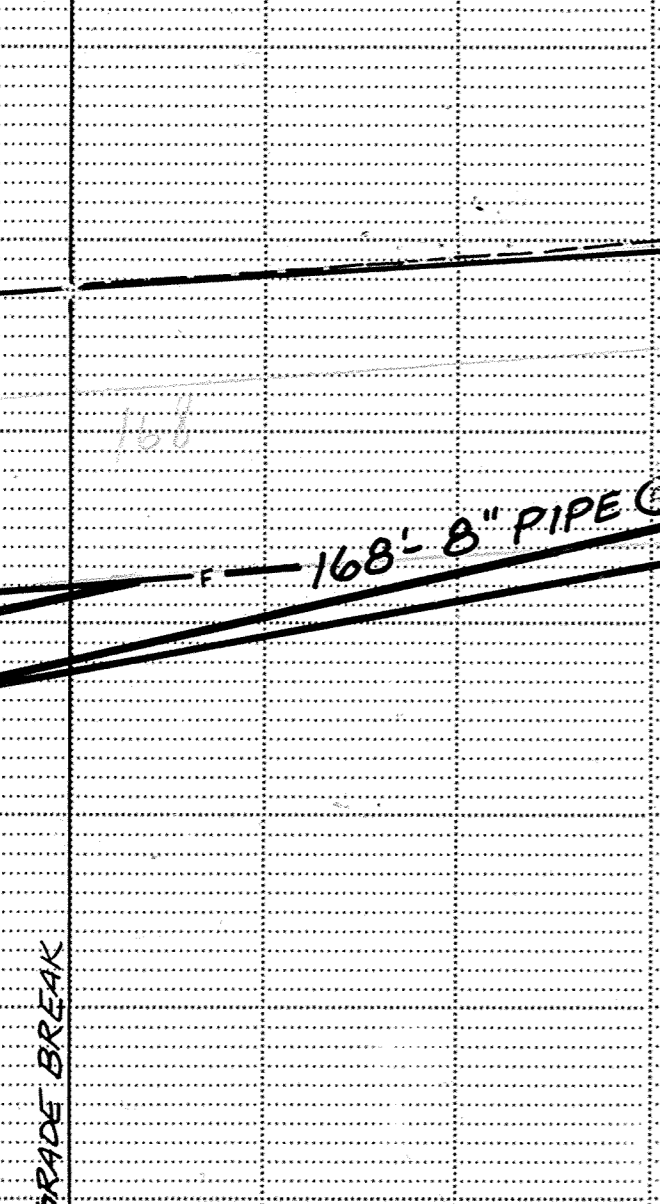
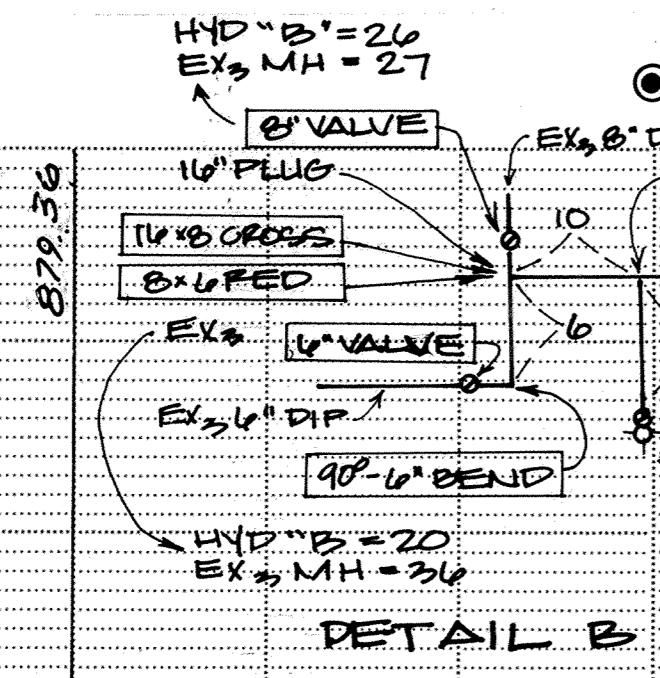
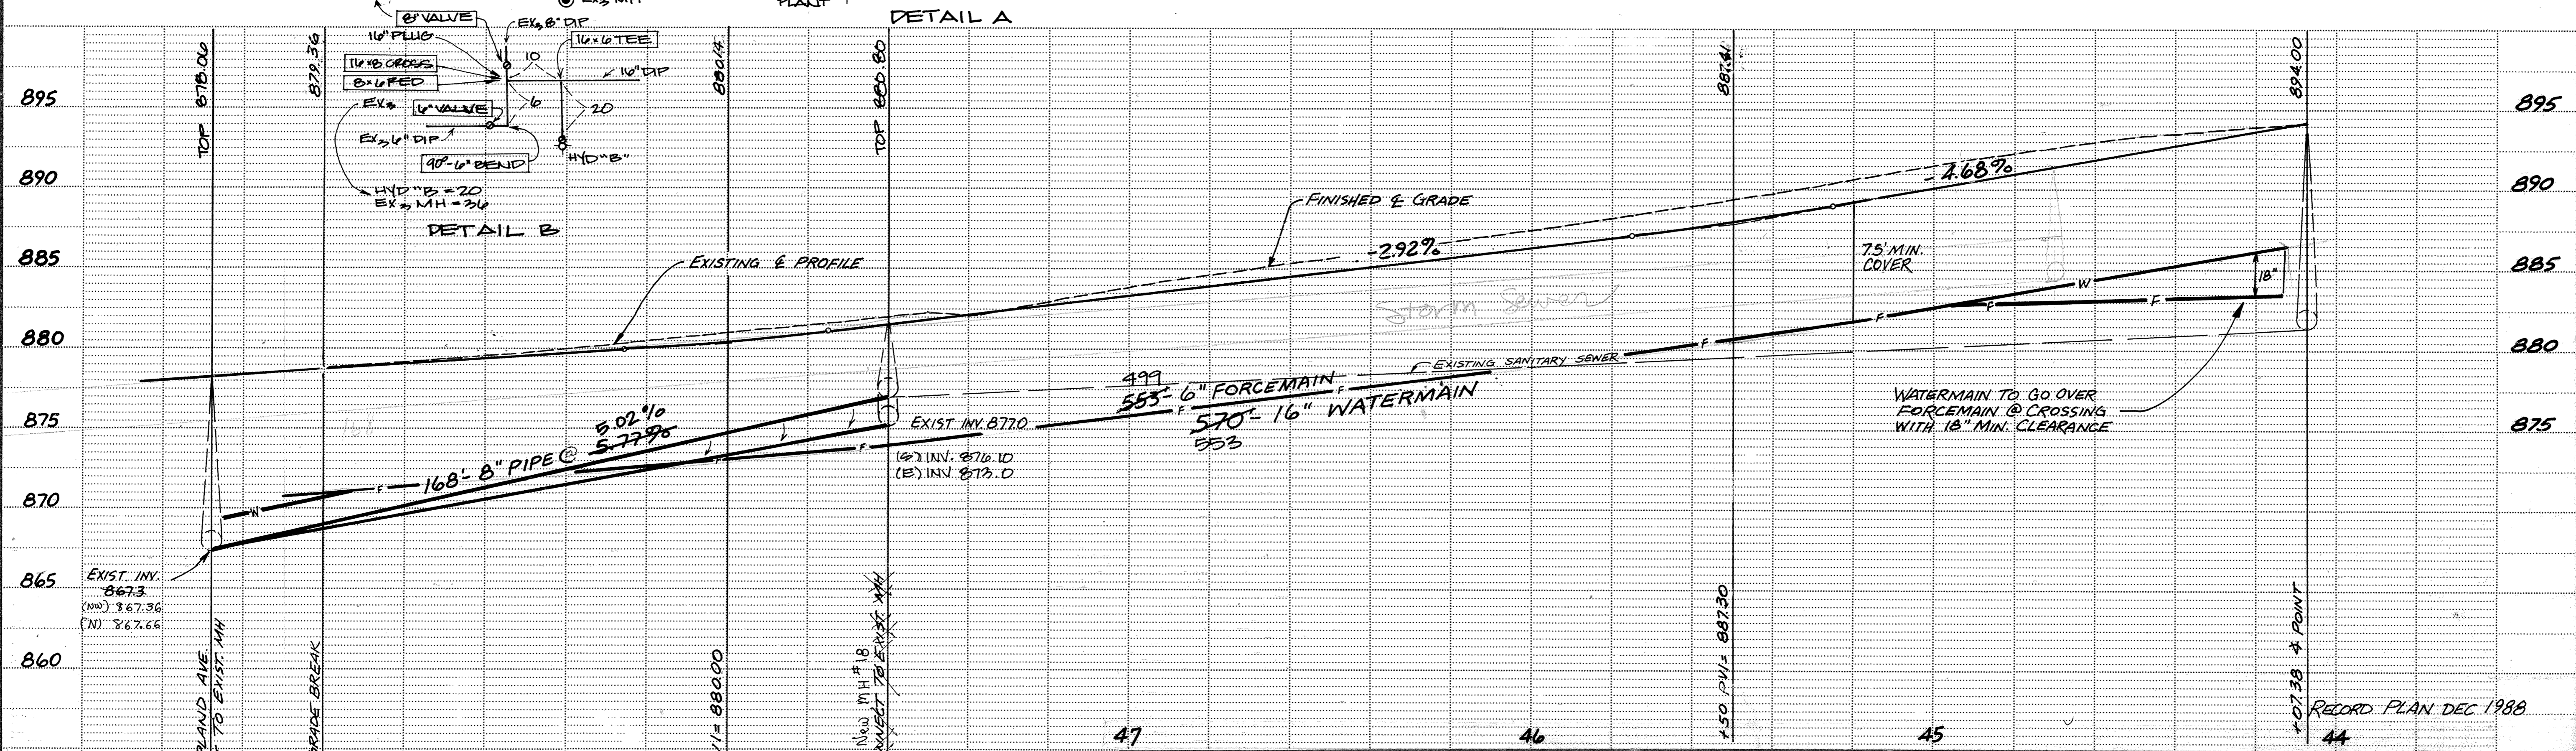


# MAIN STREET

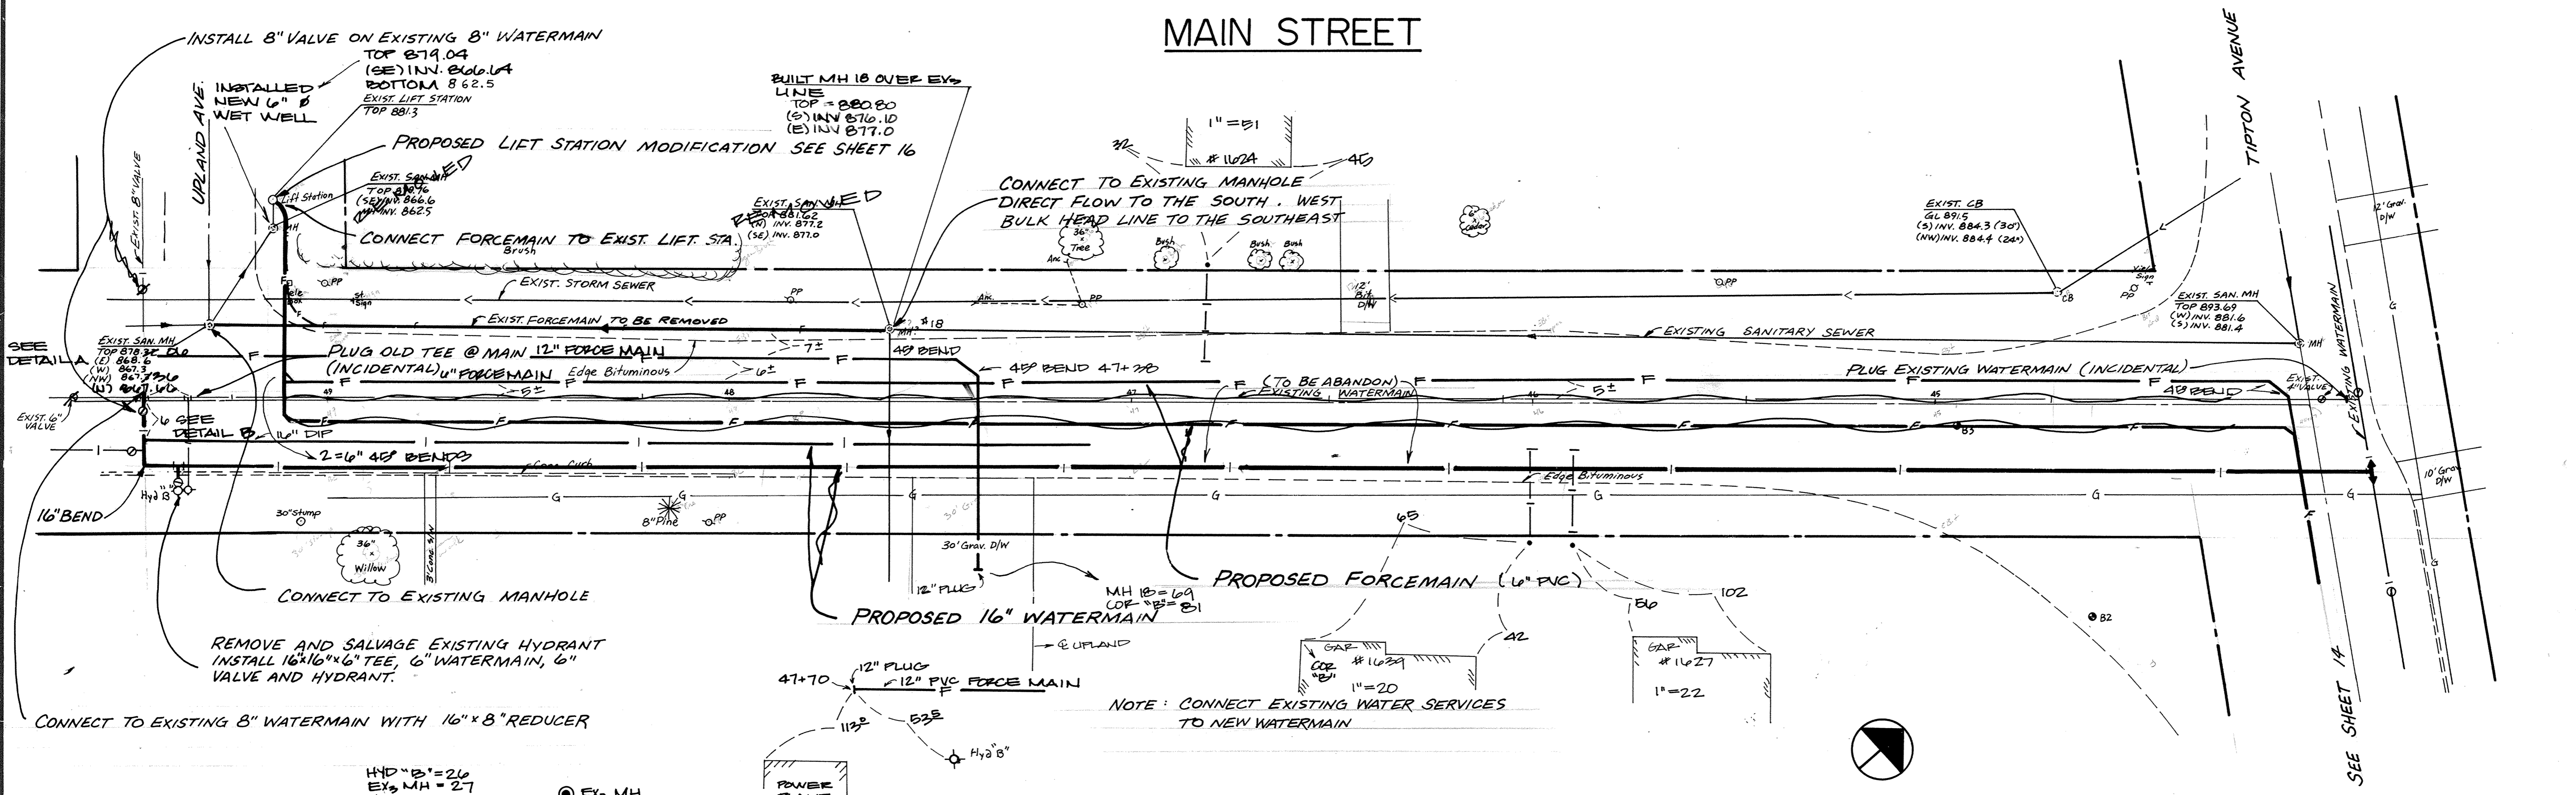

		CONSULTING ENGINEERS		<b>CITY OF ELK RIVER</b> SANITARY SEWER & WATERMAIN MAINS 87	
		1959 SLOAN PLACE (612) 774-6021 ST. PAUL, MINNESOTA 55117			
DATE	DESCRIPTION	DESIGNED	DATE Oct 1987 SHEET 15 OF 42 SHEETS PROJECT NO. 230-014		
3/3/88	Street Grades	CHECKED			
REVISIONS		DRAWN	GRAPHIC SCALE 0 HORIZ. 20 0 VERT. 5		
		MRI			