
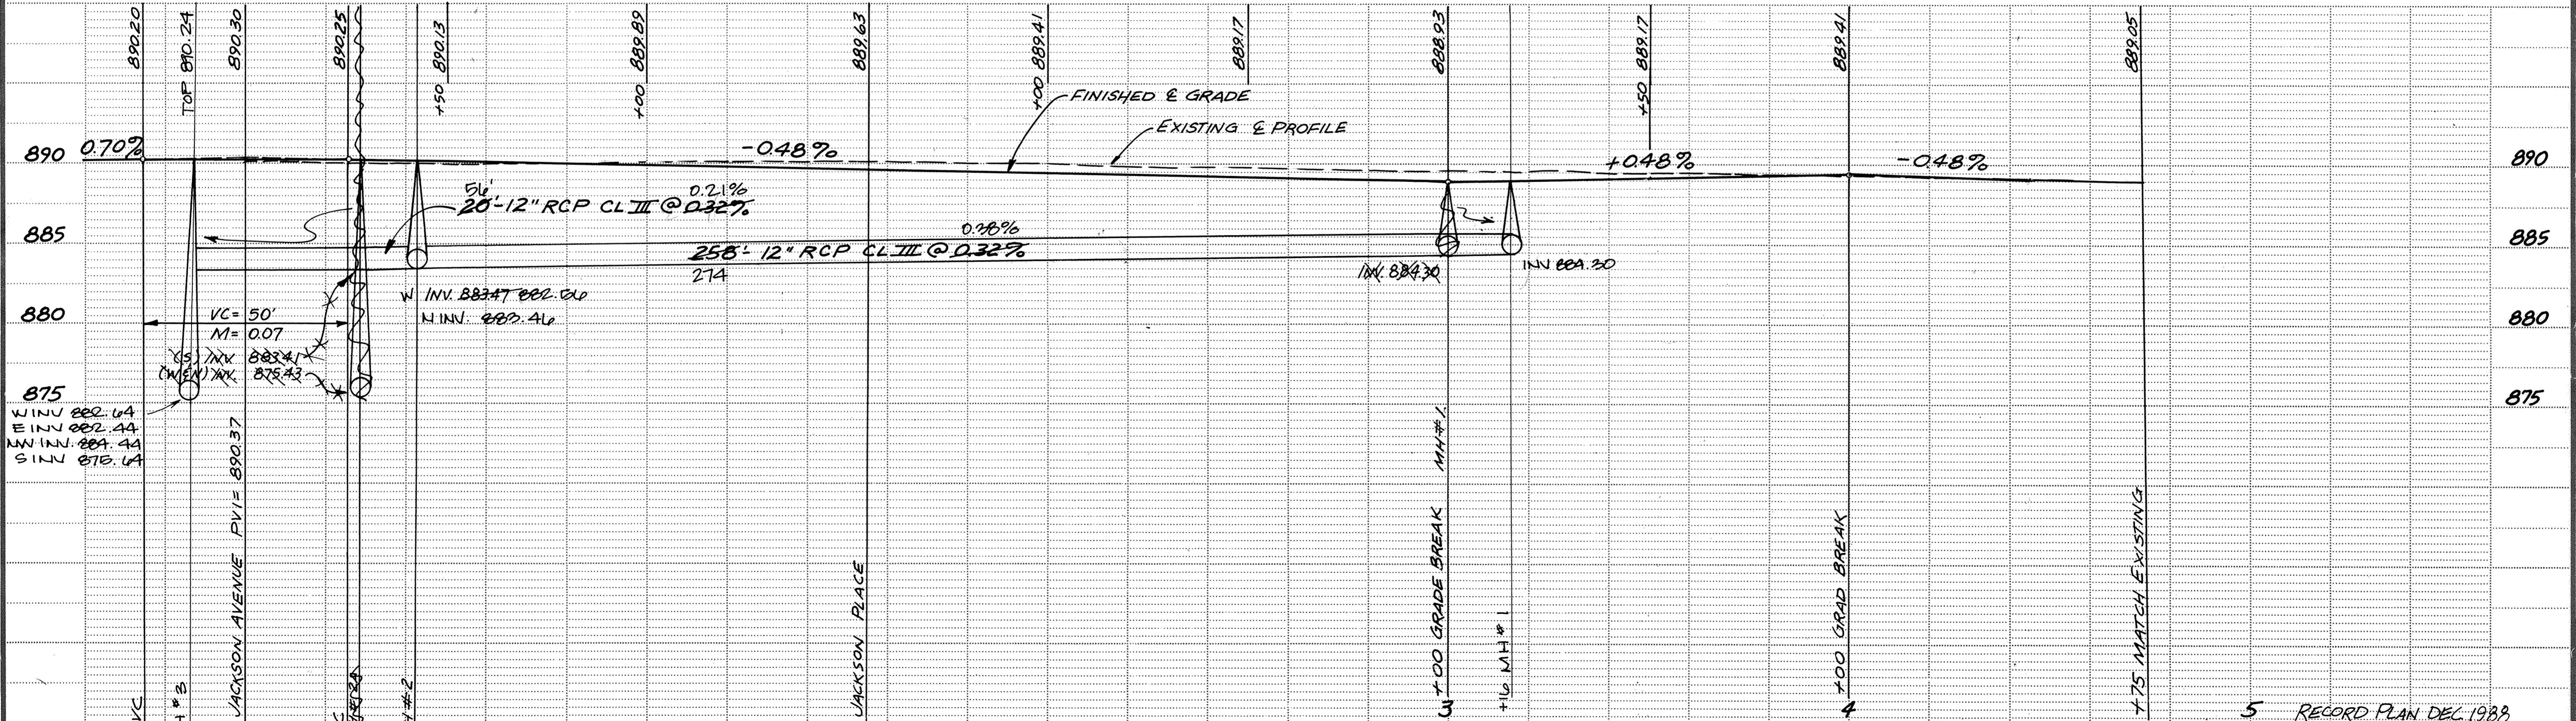


MAIN STREET

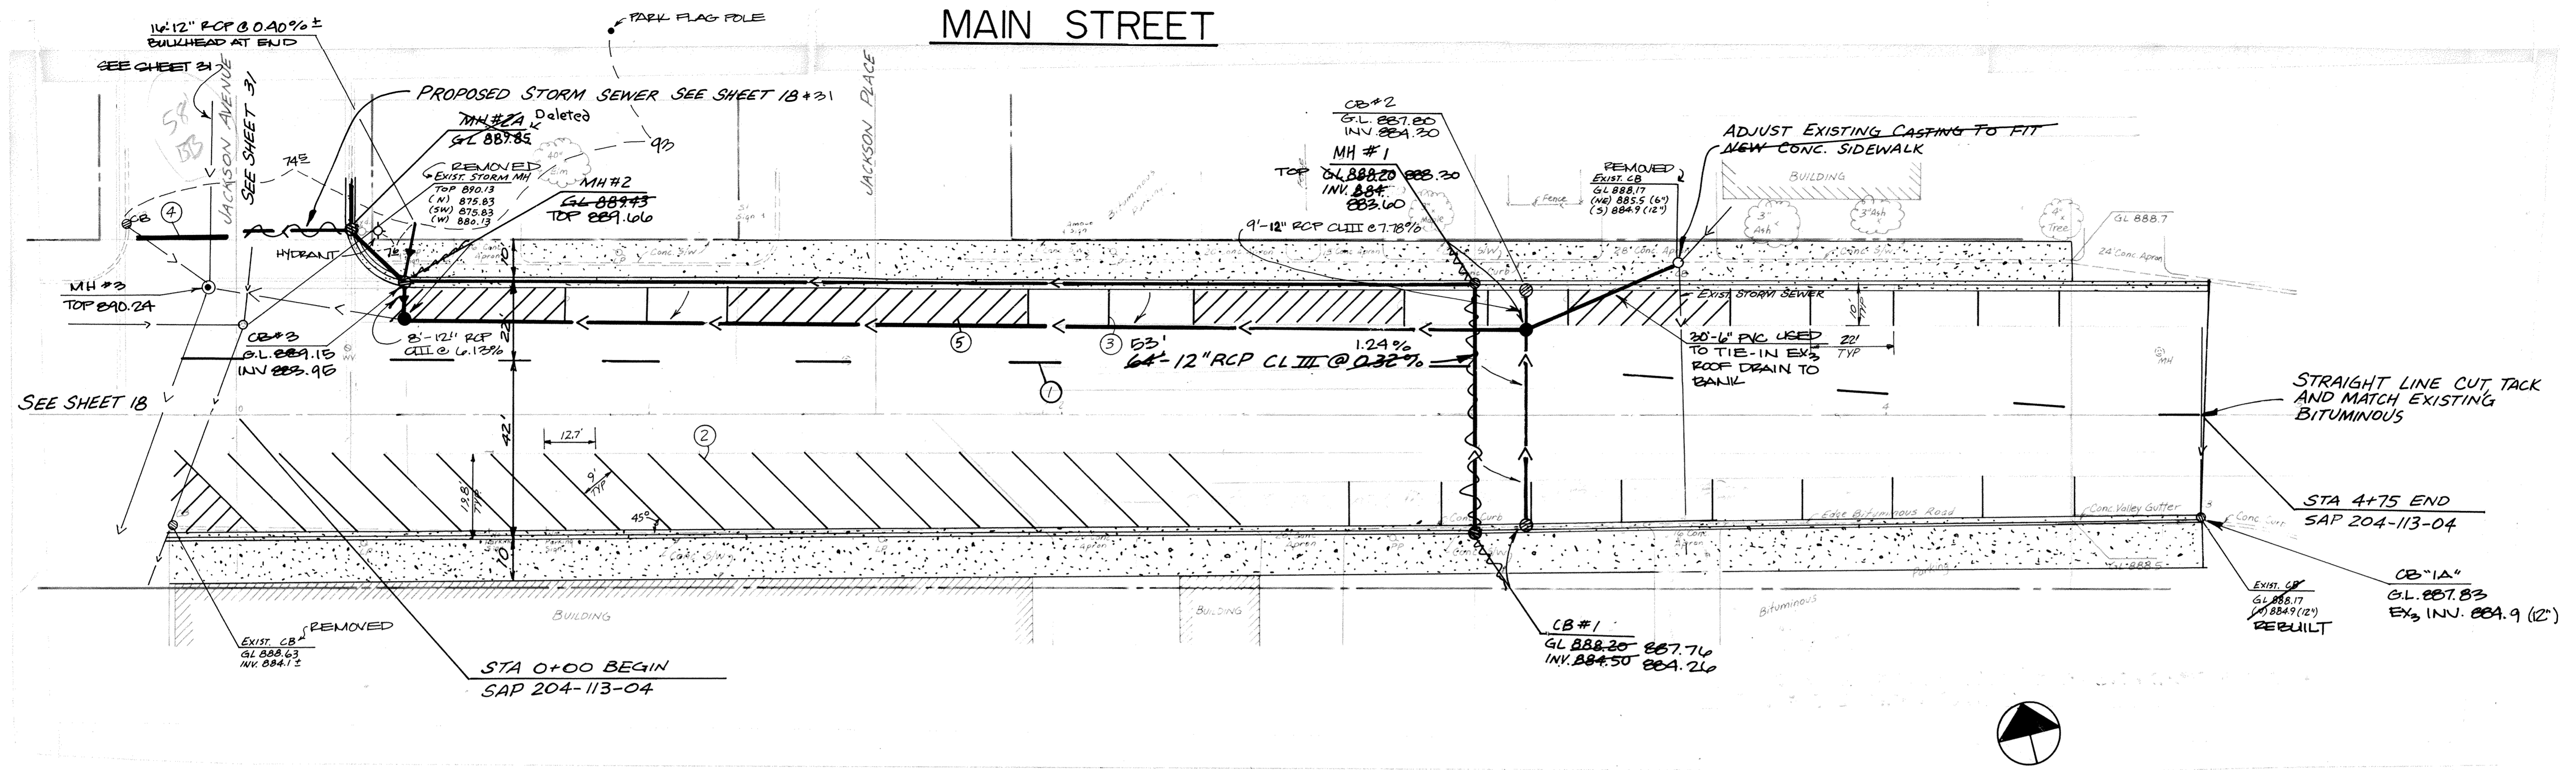

<p>Maier Stewart & Associates Inc. CONSULTING ENGINEERS 1959 SLOAN PLACE (612) 774-6021 ST. PAUL, MINNESOTA 55117</p>	<p>DATE _____</p> <p>DESCRIPTION _____</p>	<p>DESIGNED _____</p> <p>CHECKED _____</p> <p>DRAWN <u>ARJ</u></p> <p>GRAPHIC SCALE 0 HORIZ. 20 0 VERT. 5</p>	<p>CITY OF ELK RIVER</p> <p>STREET CONSTRUCTION</p> <p>MAIN STREET</p>
	<p>REVISIONS _____</p>	<p>DATE <u>OCT 1987</u></p> <p>SHEET <u>17</u> OF <u>42</u> SHEETS</p> <p>PROJECT NO. <u>230-014</u></p>	<p>RECORD PLAN DEC 1988</p>

SAICO PRODUCTS • NEW HOPE, MINNESOTA
 REPROD BY PART NUMBER 8938
 SAICO PRODUCTS • NEW HOPE, MINNESOTA
 REPROD BY PART NUMBER 8938
 SAICO PRODUCTS • NEW HOPE, MINNESOTA
 REPROD BY PART NUMBER 8938
 SAICO PRODUCTS • NEW HOPE, MINNESOTA
 REPROD BY PART NUMBER 8938