
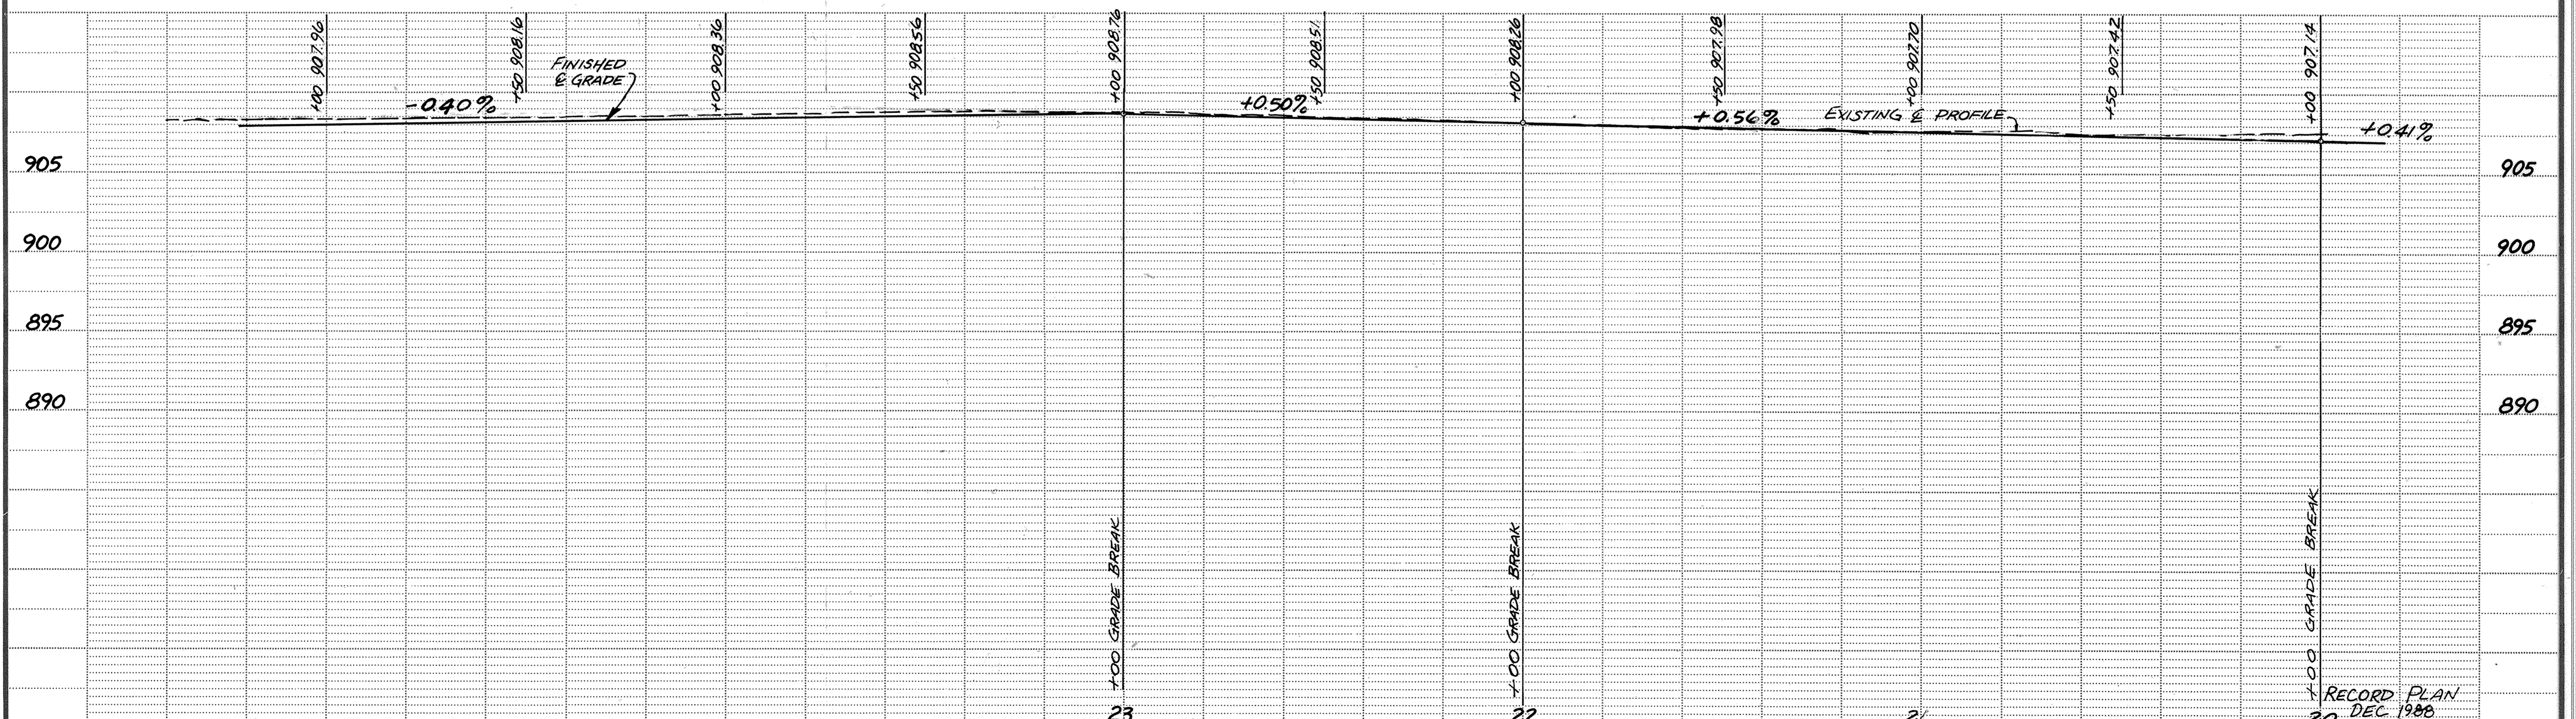


MAIN STREET

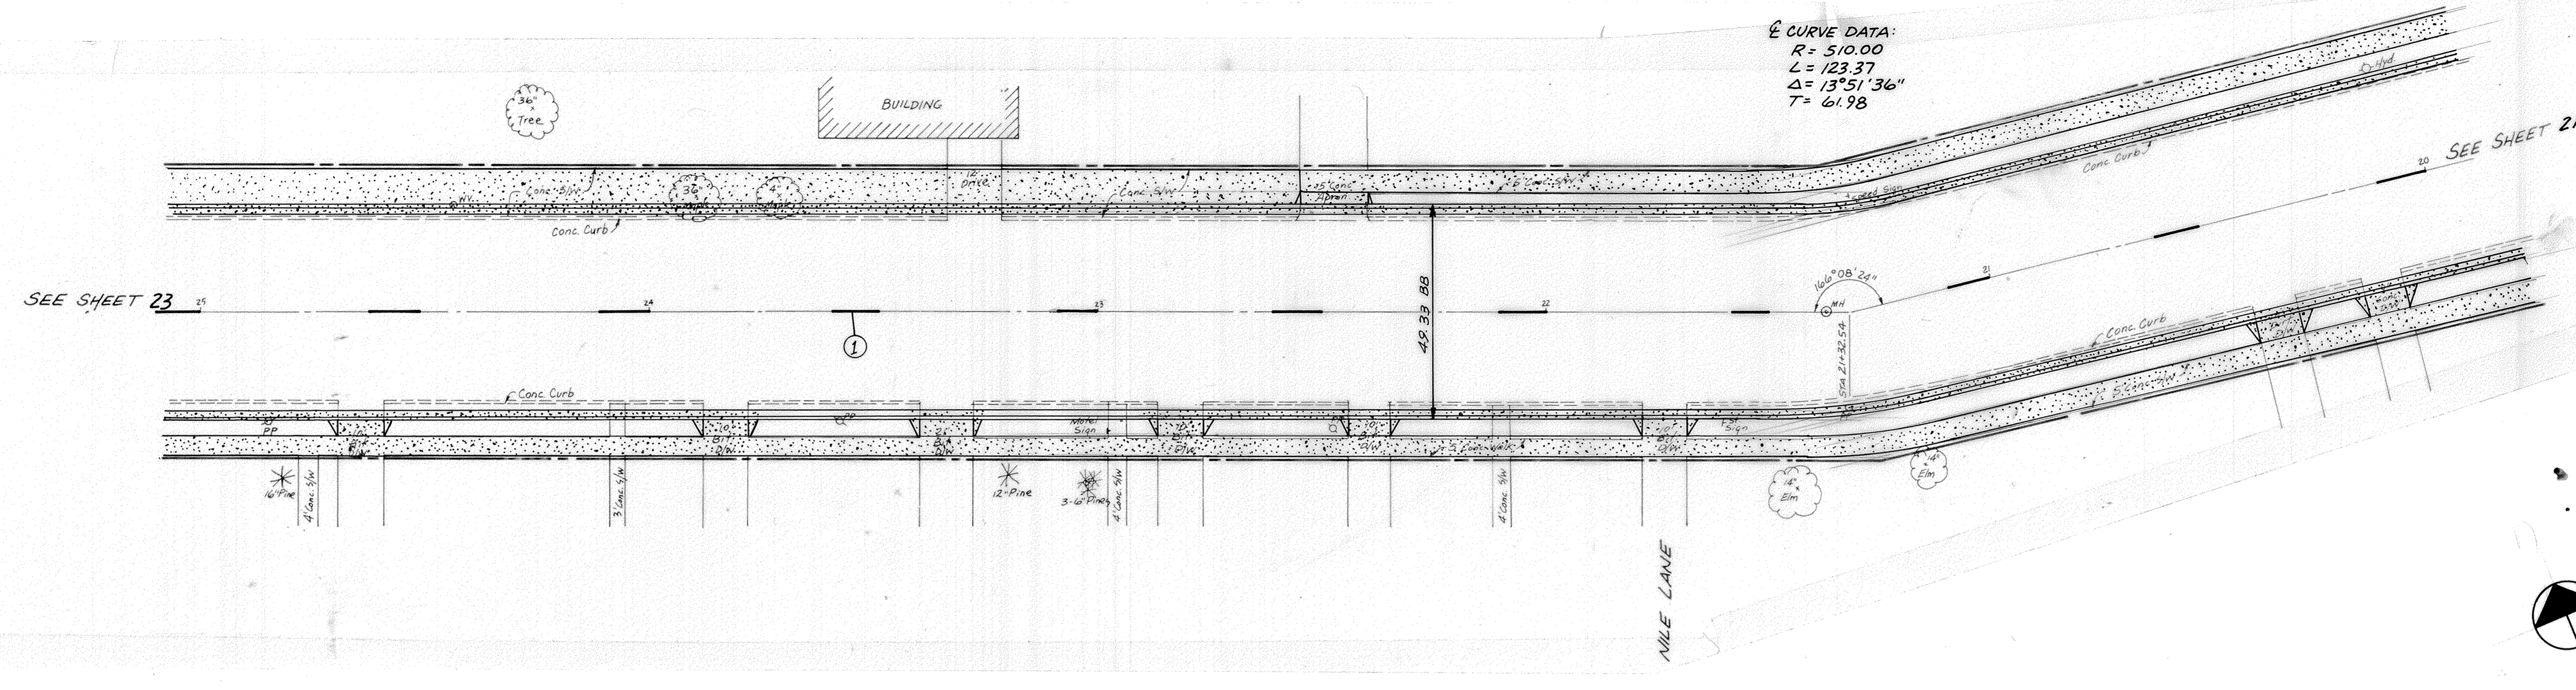

Maier Stewart & Associates Inc.
CONSULTING ENGINEERS
1959 SLOAN PLACE (612) 774-6021 ST. PAUL, MINNESOTA 55117

REVISIONS	DATE	DESCRIPTION	DESIGNED	CHECKED	DRAWN
	3/5/88	Street Grades			MRJ

CITY OF ELK RIVER

STREET CONSTRUCTION

MAIN STREET

DATE OCT. 1987 SHEET 22 OF 42 SHEETS PROJECT NO. 230-014

RECORD PLAN
20 DEC 1988

DRAWING NUMBER
 MAINS 87
 22
 DRAWING NUMBER
 253

DRAWING NUMBER
 MAINS 87
 22